



#4327

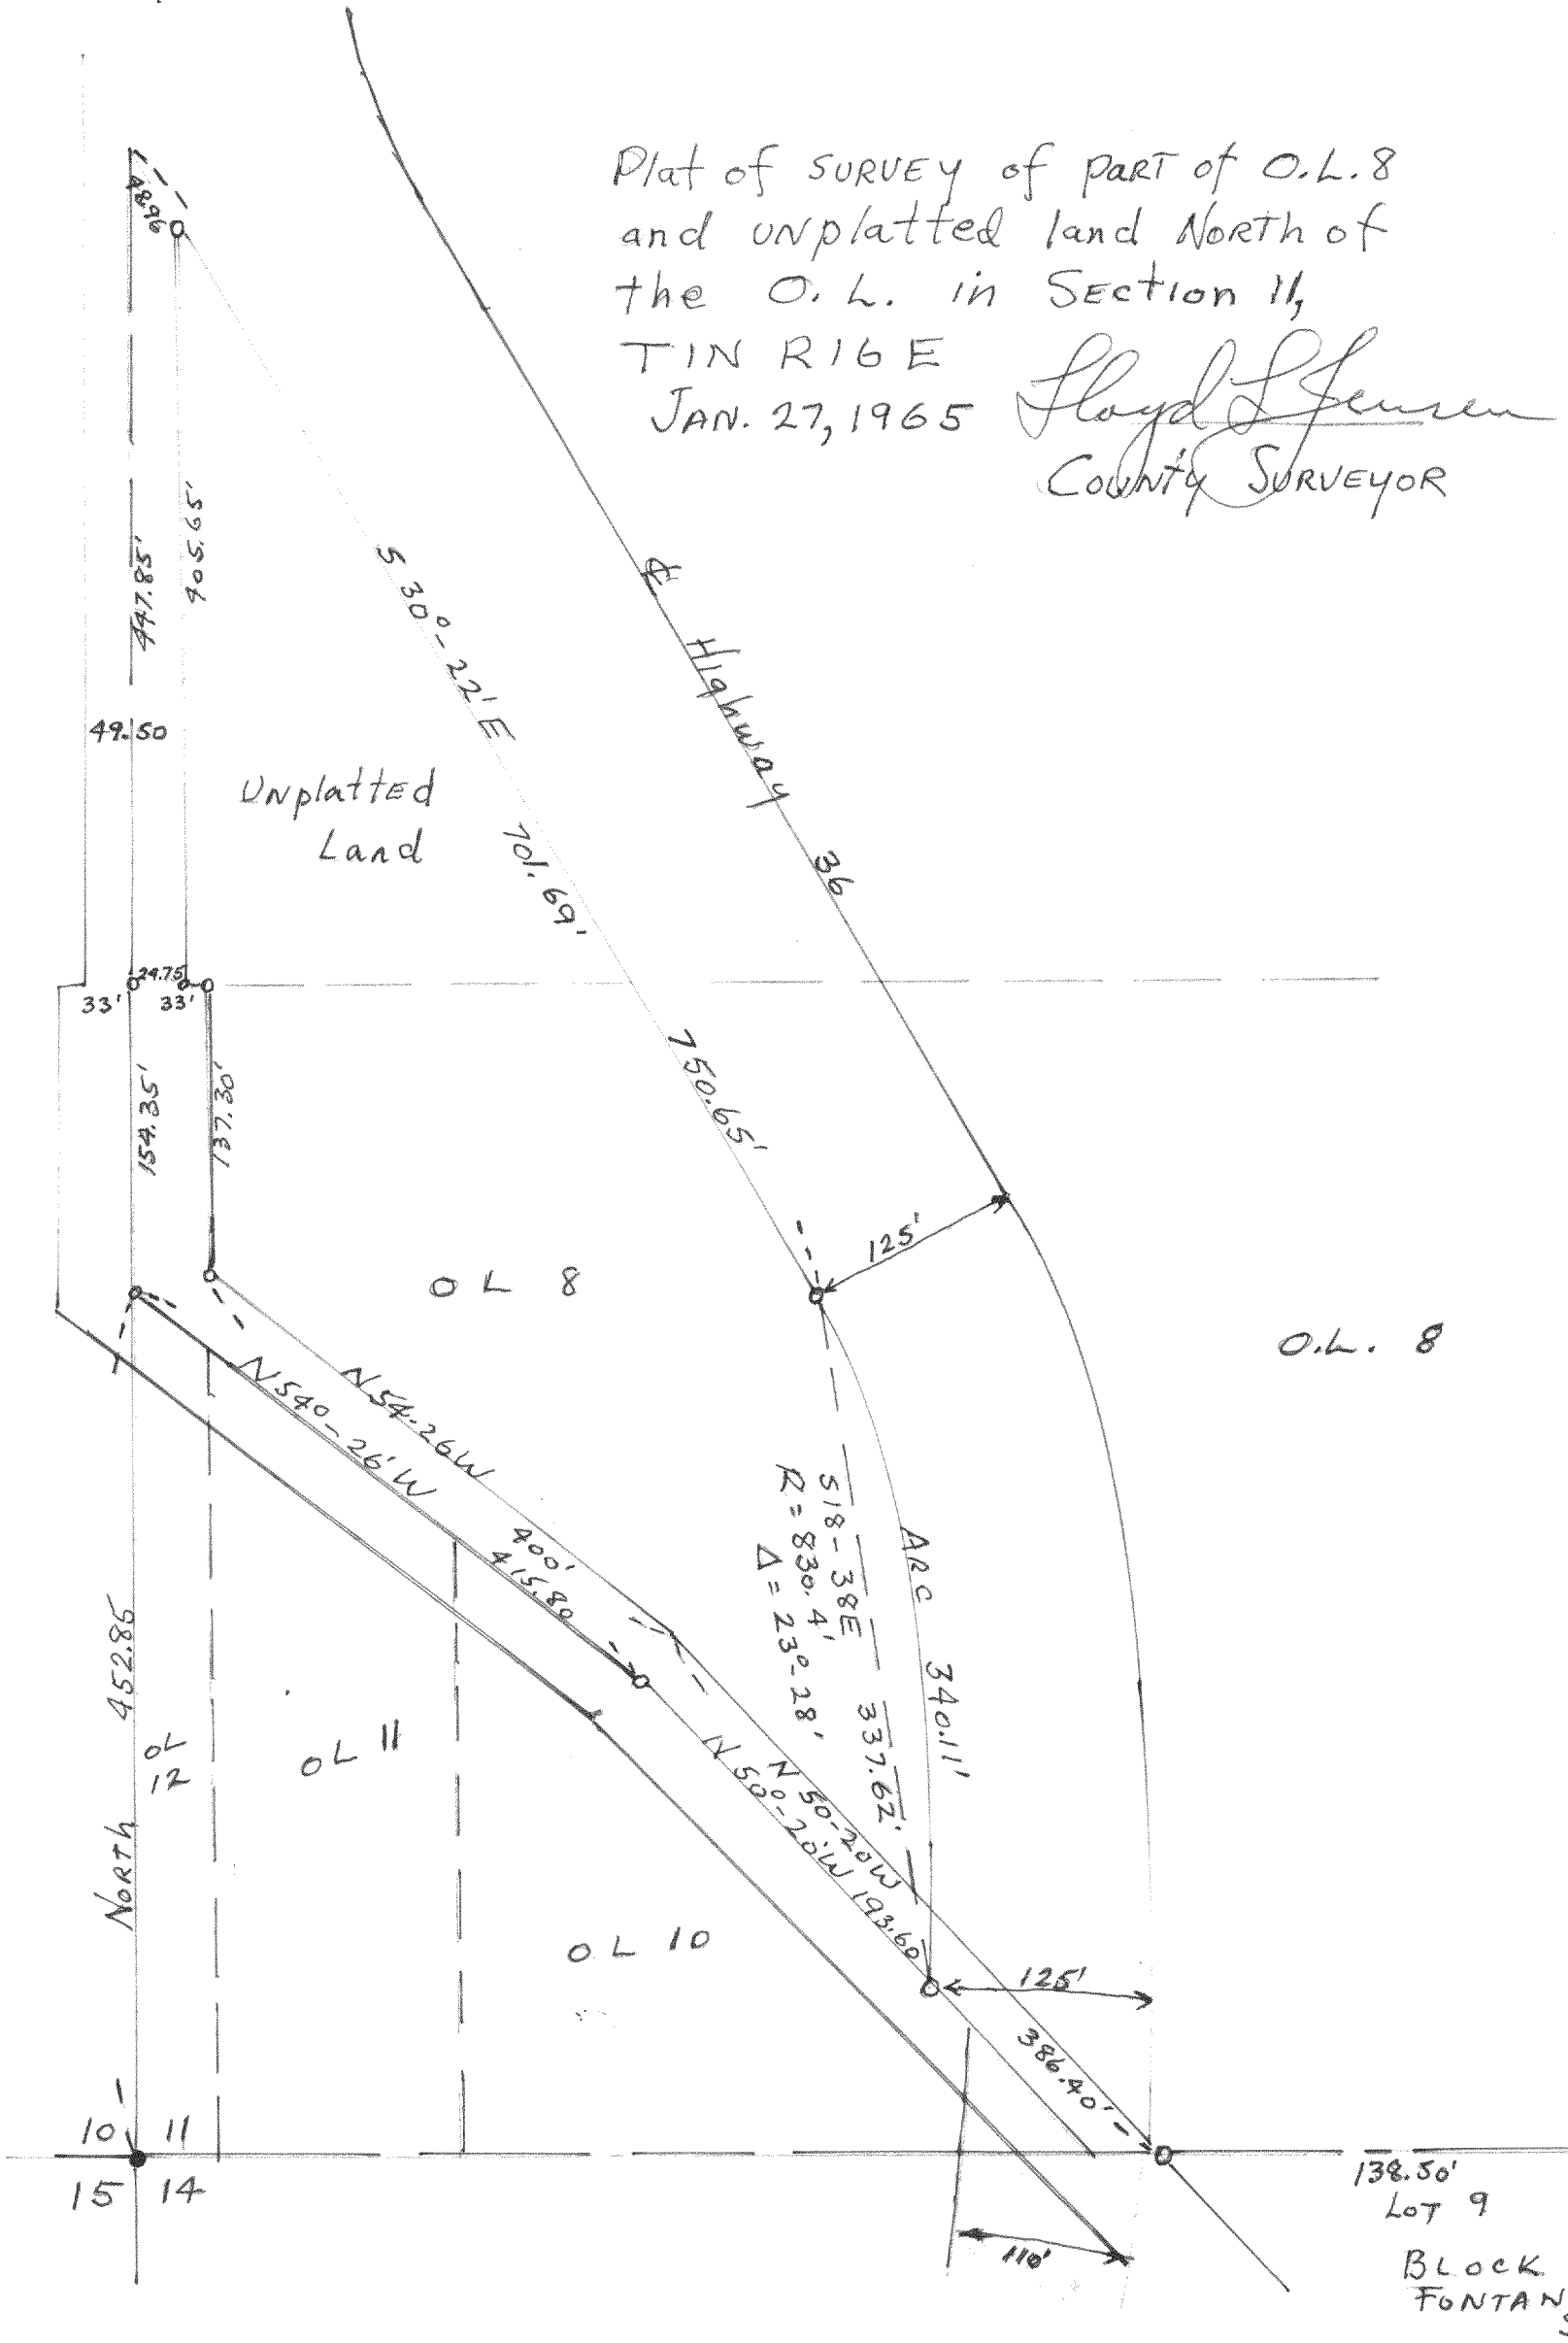

#4328

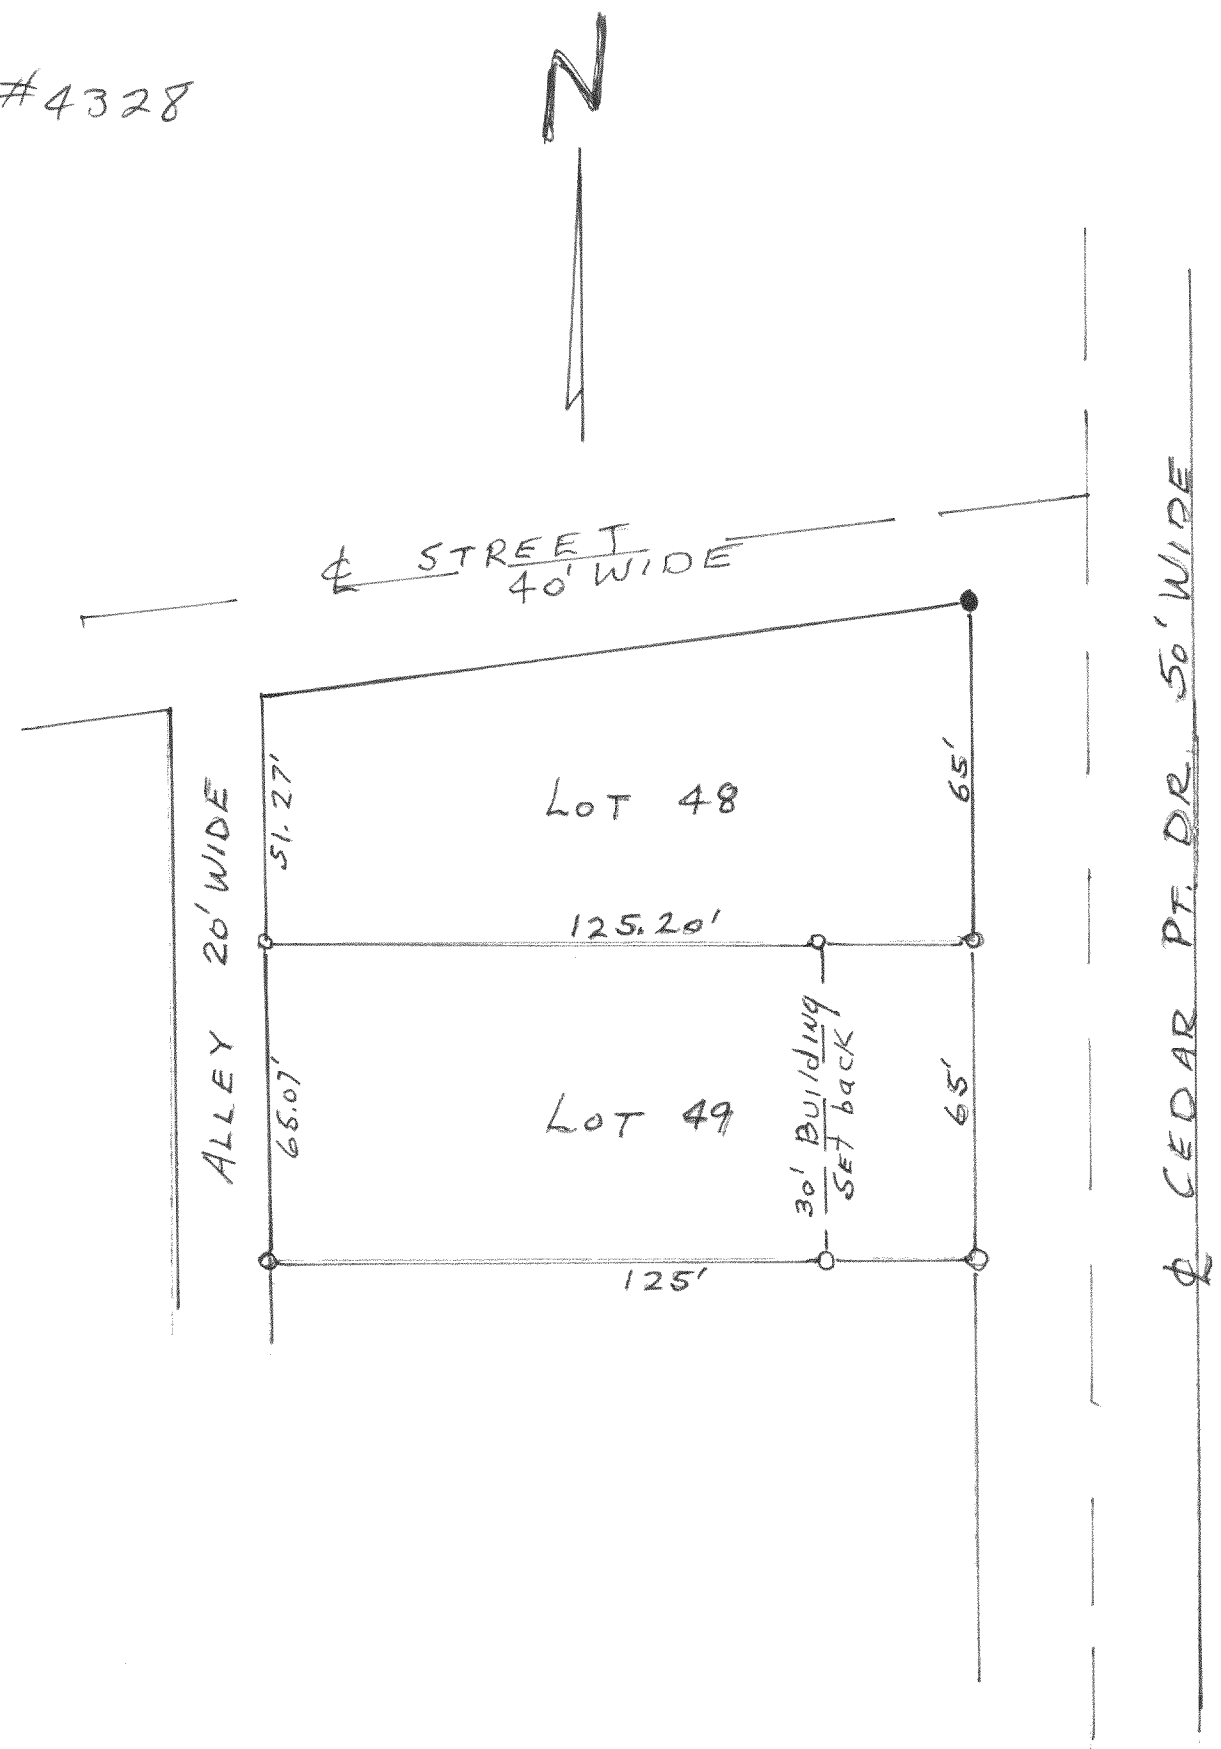

Plat of SURVEY of Lot 49
1st Add. to CEDAR PT. PARK
Williams Bay, Wis.
Feb. 12, 1965 *Floyd L Jensen*
COUNTY SURVEYOR