


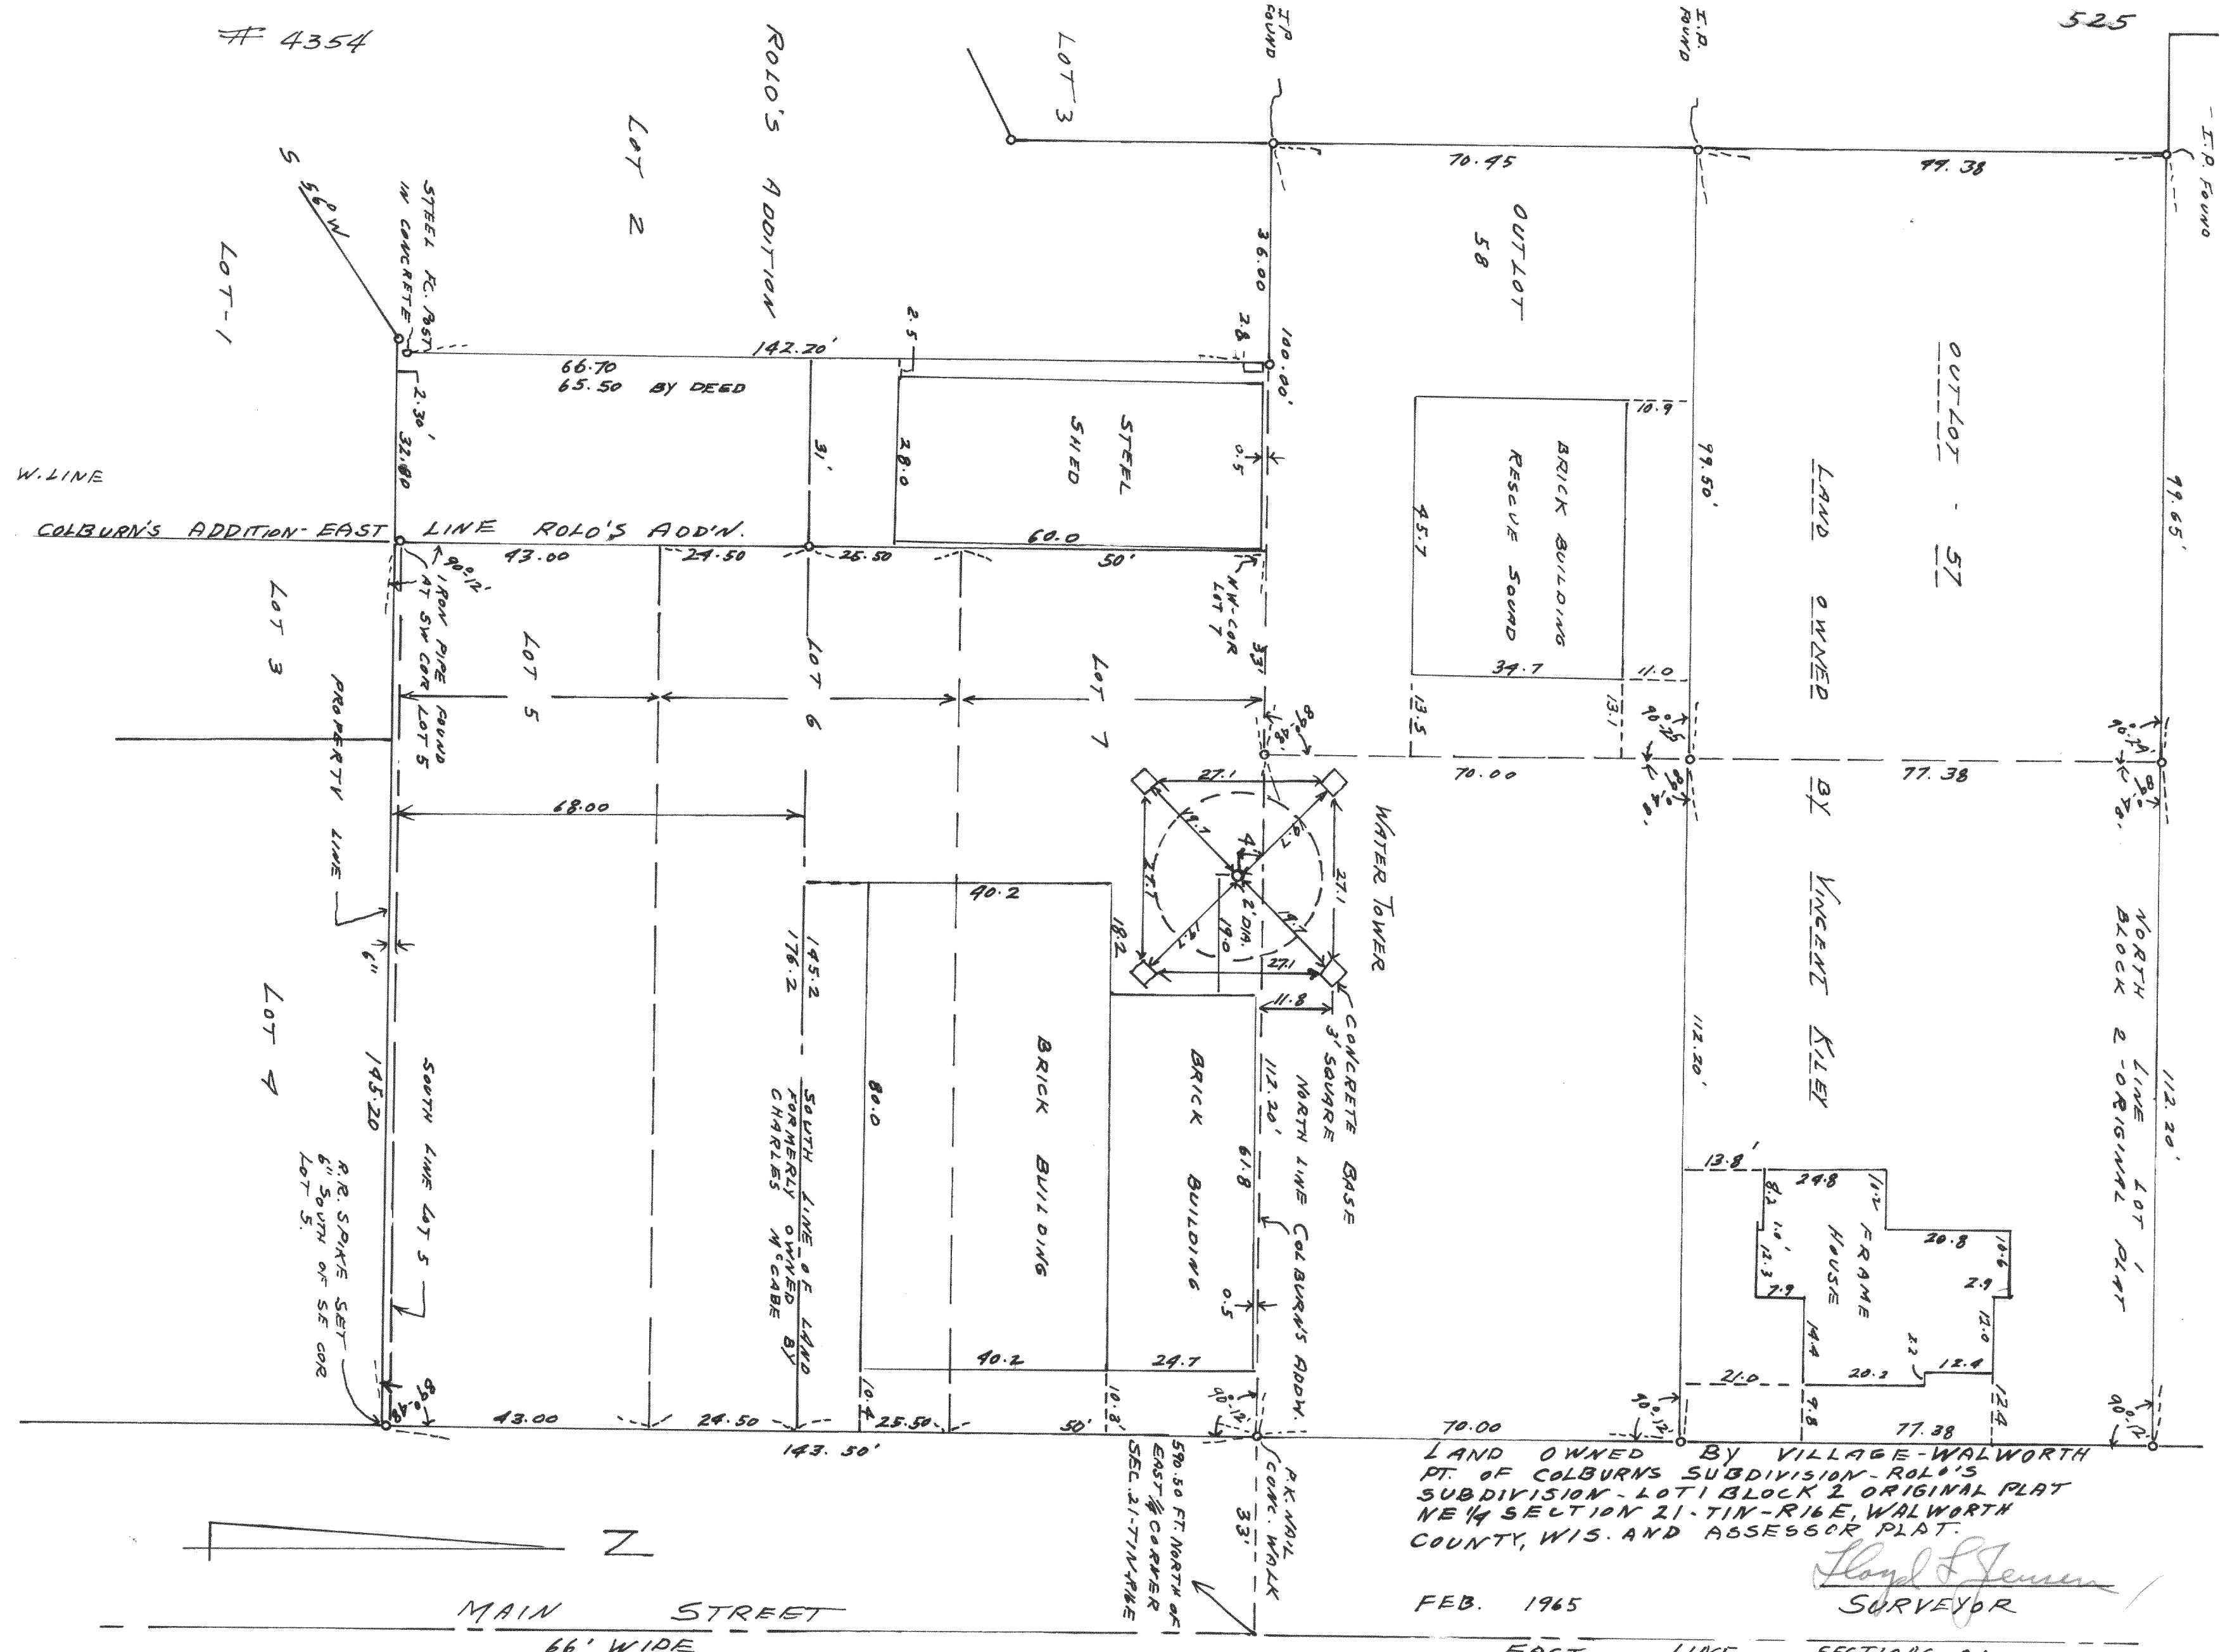

LAND OWNED BY VILLAGE-WALWORTH
PT. OF COLBURN'S SUBDIVISION-ROLO'S
SUBDIVISION-LOT 1 BLOCK 2 ORIGINAL PLAT
NE 1/4 SECTION 21-TIN-RIDGE, WALWORTH
COUNTY, WIS. AND ASSESSOR PLAT.

FEB. 1965

Lloyd F. Jensen
SURVEYOR

EAST LINE SECTION 21