


542

4386

PLAT OF SURVEY
OF
A PARCEL IN THE SW $\frac{1}{4}$ OF SEC. 19
T4N R18E WAL. CO. WIS.
AUG 1965

Lloyd L Jensen
CO. SURVEYOR

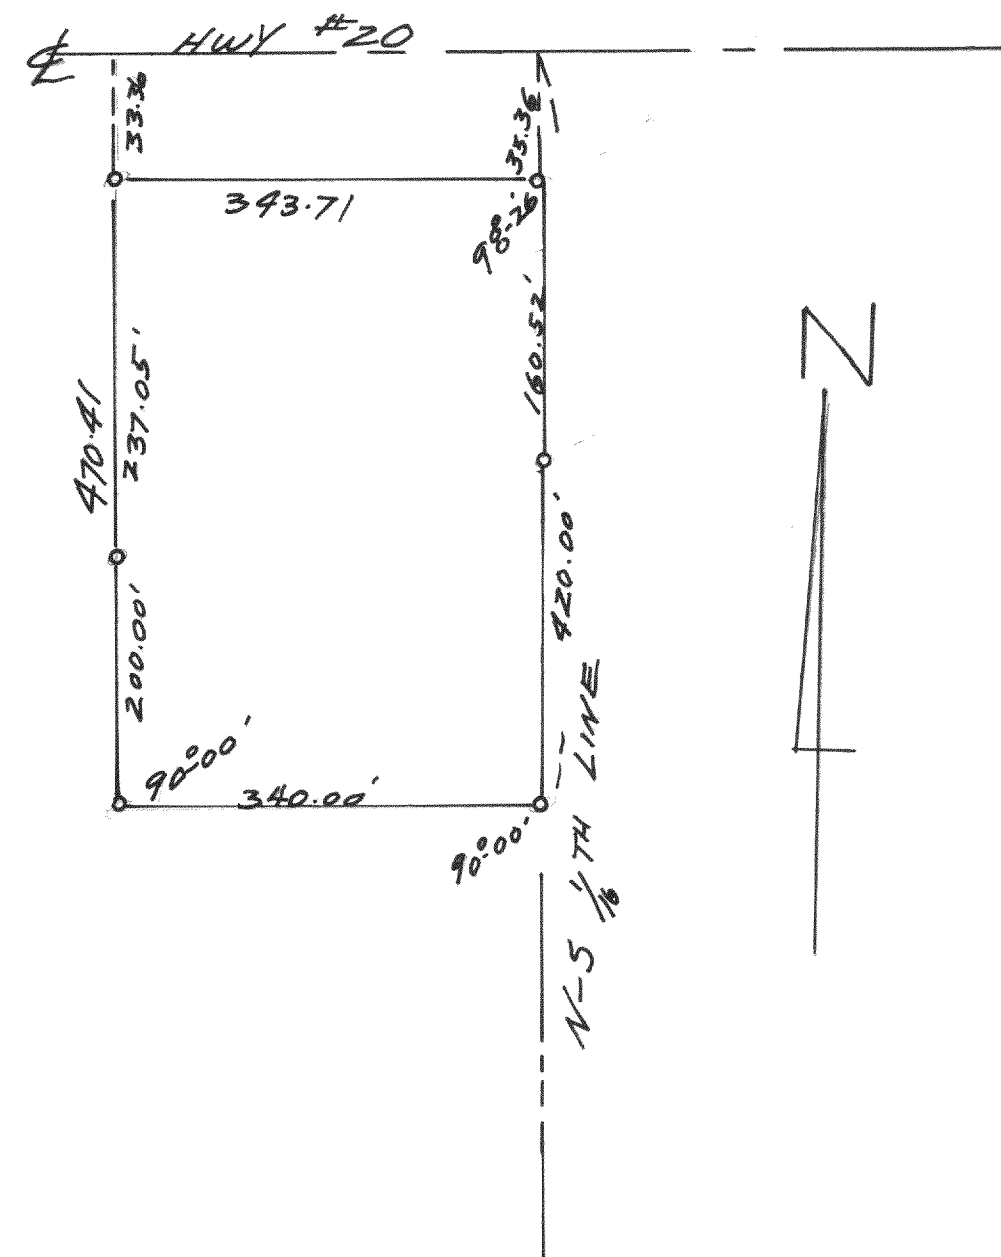

#4387

PLAT OF SURVEY
OF
A PARCEL OF LAND IN THE SE $\frac{1}{4}$
OF THE SE $\frac{1}{4}$ SEC 28, T4N R18E
WAL. CO. WIS.
AUG. 1965

Lloyd L Jensen
CO. SURVEYOR

