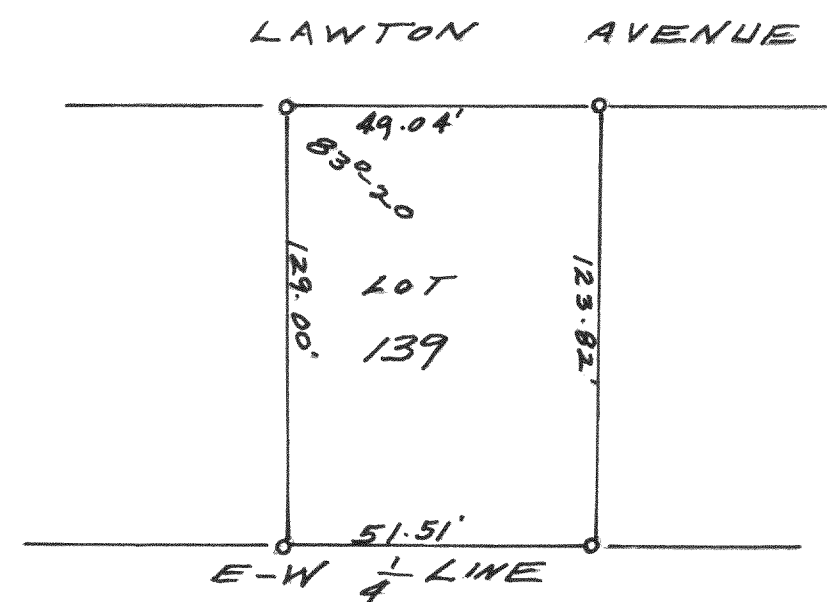


#4390

PLAT OF SURVEY
OFLOT 139 LAKE GENEVA GOLF HILLS ADD.
SECTION 31 T2N R18E WAL. CO. WIS.

SEPT 1962

Lloyd L. Jensen
 Lloyd L. JENSEN CO. SURVEYOR


PLAT OF SURVEY
OF

#4391

NW 1/4 - NW 1/4 SEC 1, T2N R18E
WAL. CO. WIS.

APRIL 1964

Lloyd L. Jensen
 Lloyd L. JENSEN
 CO. SURVEYOR

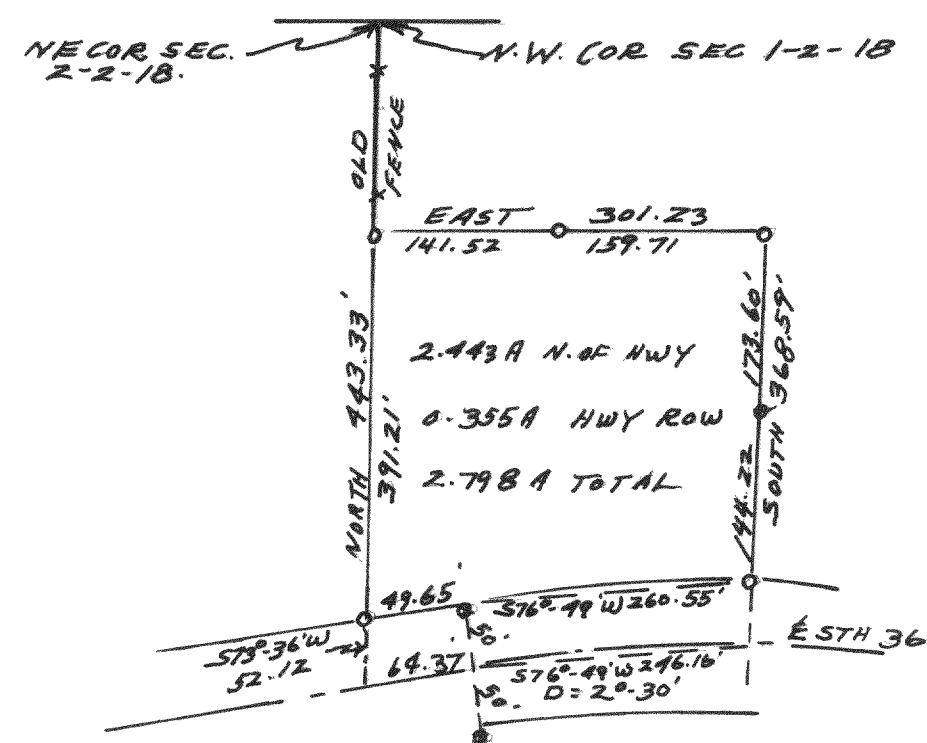


#4392

PLAT OF SURVEY
OFPART OF LOT 19 BLK 2 CAMPBELLS ADD.
TO LYONS VILLAGE SEC. 10 T2N R18E

OCT 1965

Lloyd L. Jensen
 Lloyd L. JENSEN
 CO. SURVEYOR

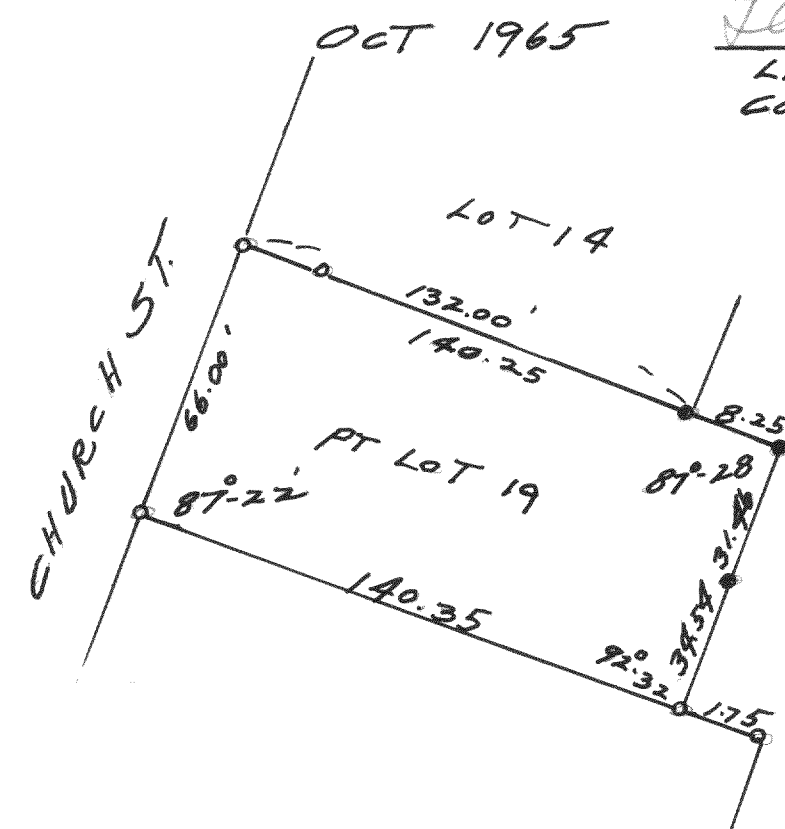

#4393

PLAT OF SURVEY
OFA PARCEL IN THE SE 1/4 OF SEC 18,
T3N R18E WAL. CO. WIS.

MAY 1965

Lloyd L. Jensen
 CO. SURVEYOR

