



4423 PLAT OF SURVEY
OF
LOT 59 WESTPARK SECOND ADDITION
LOCATED IN THE SW 1/4 OF SECTION 5, T4N-
R15E CITY OF WHITEWATER WAL. CO. WIS.
MAY 1965

Lloyd L. Jensen
COUNTY SURVEYOR

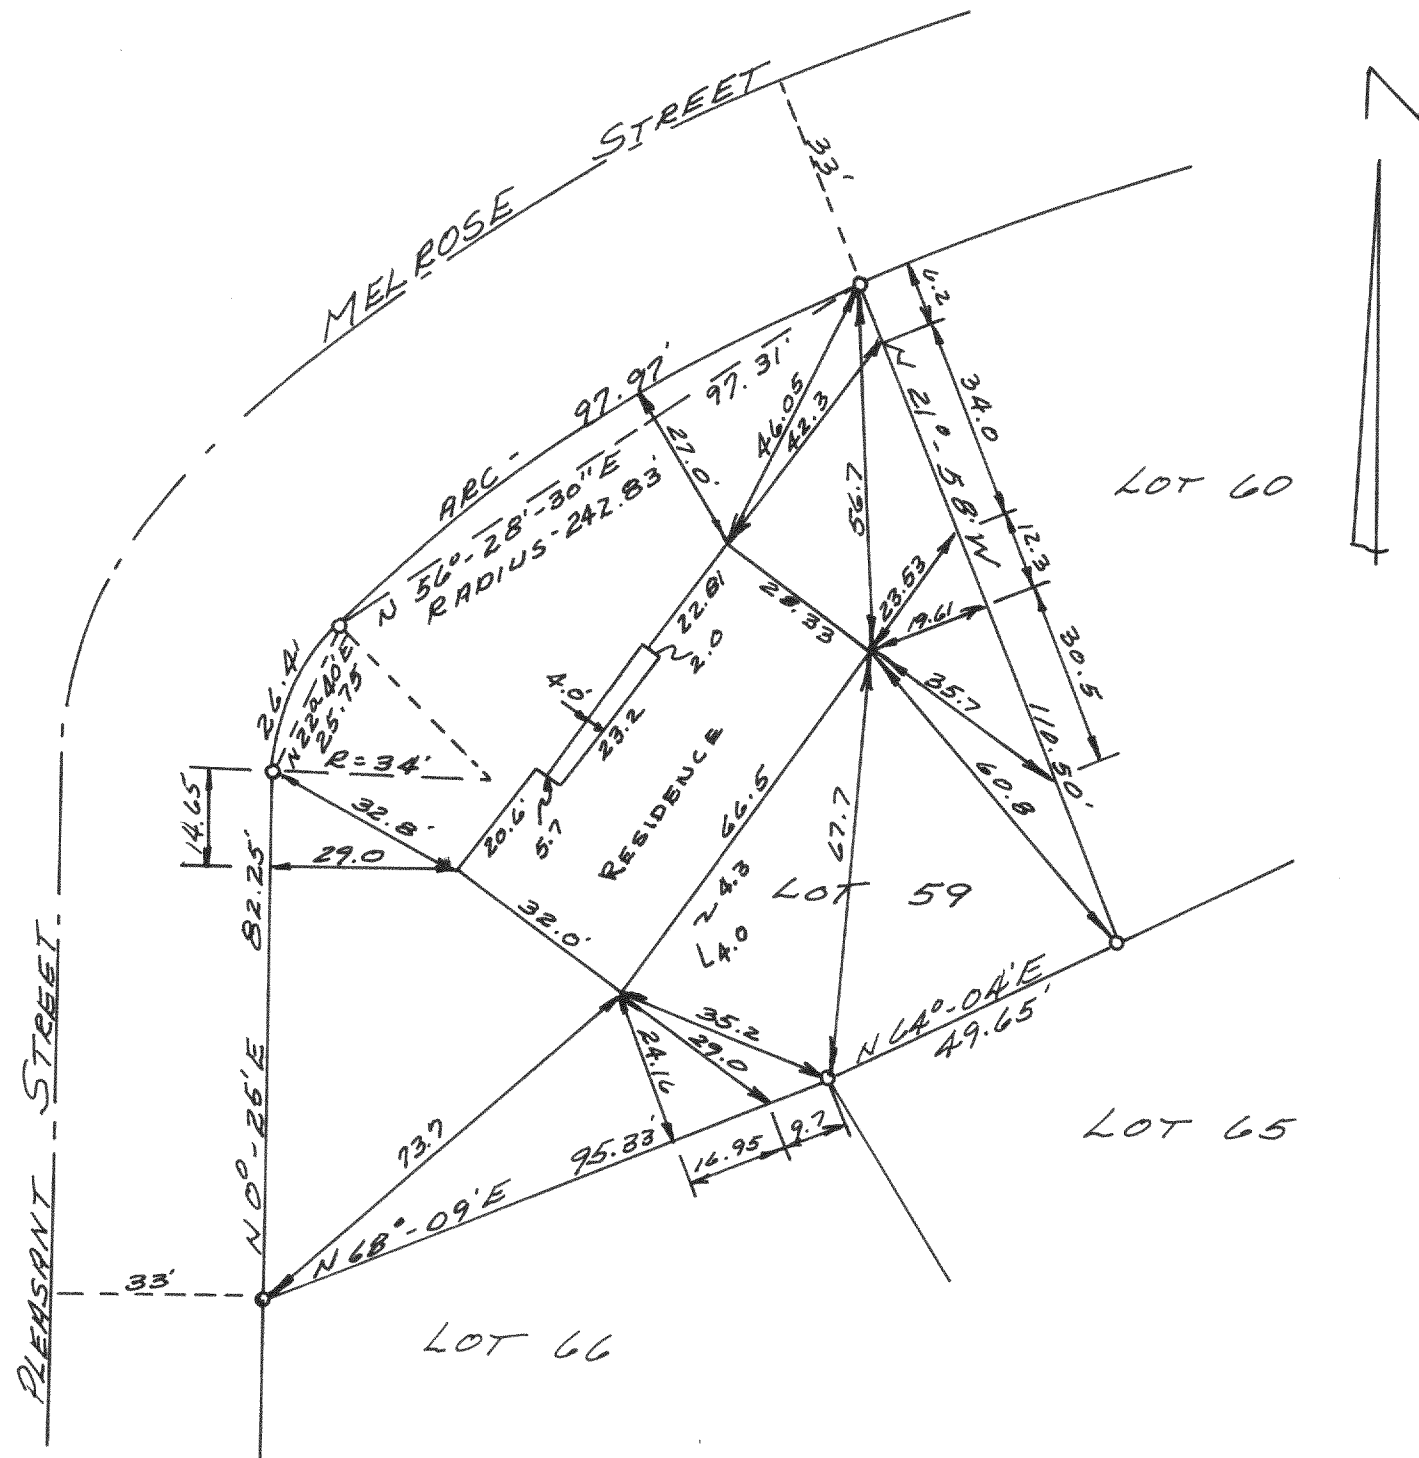

NW COR. OF LOT 11
STEARNSE & GEROLD'S SUBDIVISION

LOT 10 STEARNSE & GEROLD'S SUBDIVISION

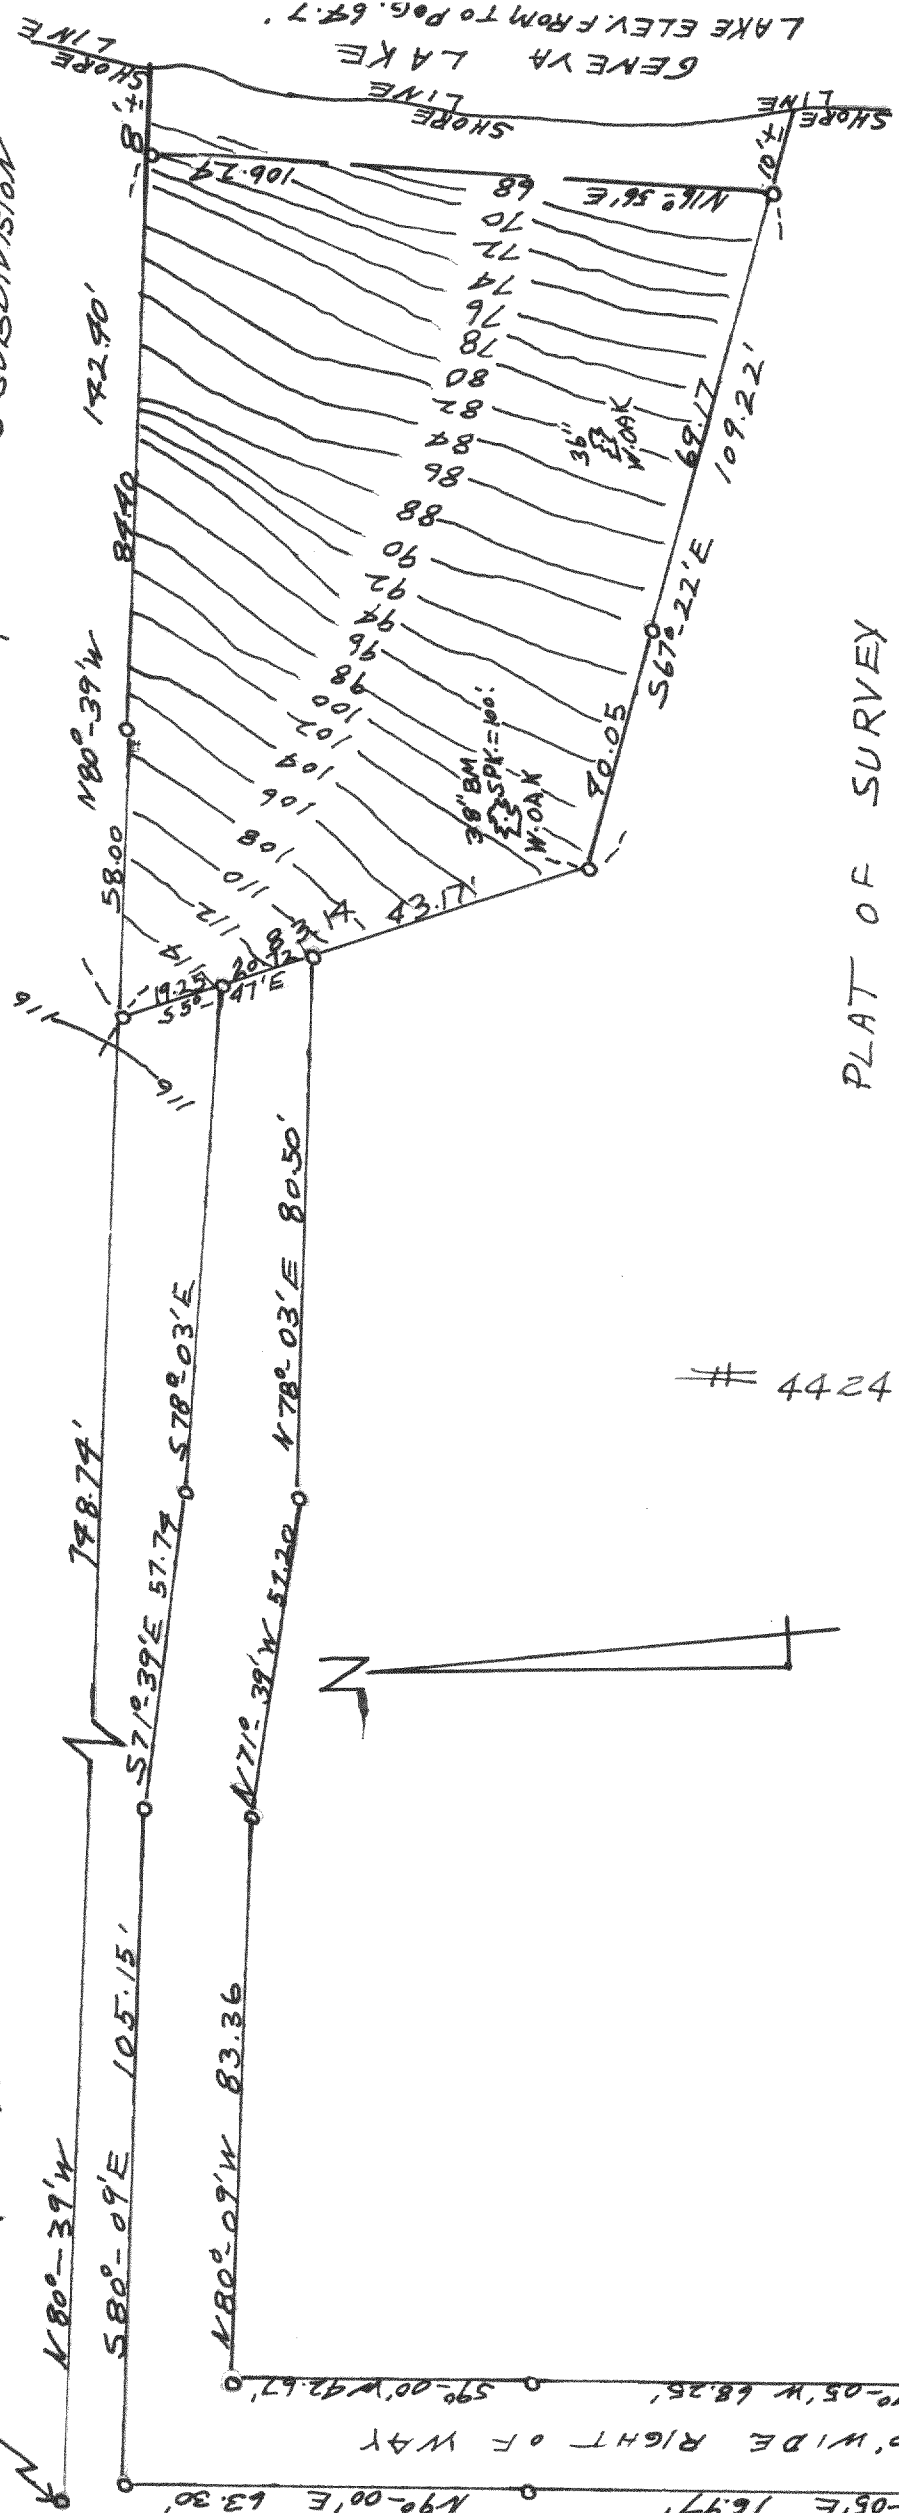

PLAT OF SURVEY
OF

A PARCEL OF LAND LOCATED IN
STEARNSE & GEROLD'S SUBDIVISION
IN THE SW 1/4 SECTION 11 T4N-R15E
WALWORTH COUNTY, WISCONSIN.

JUNE 1965

Lloyd L. Jensen
CO. SURVEYOR

