


4484.

PLAT OF SURVEY
OF

LOTS 9274-9275-9276-9277-9278
PELL LAKE SUBDIVISION
SECTION 15, T1N-R18E
WALWORTH COUNTY, WISCONSIN.

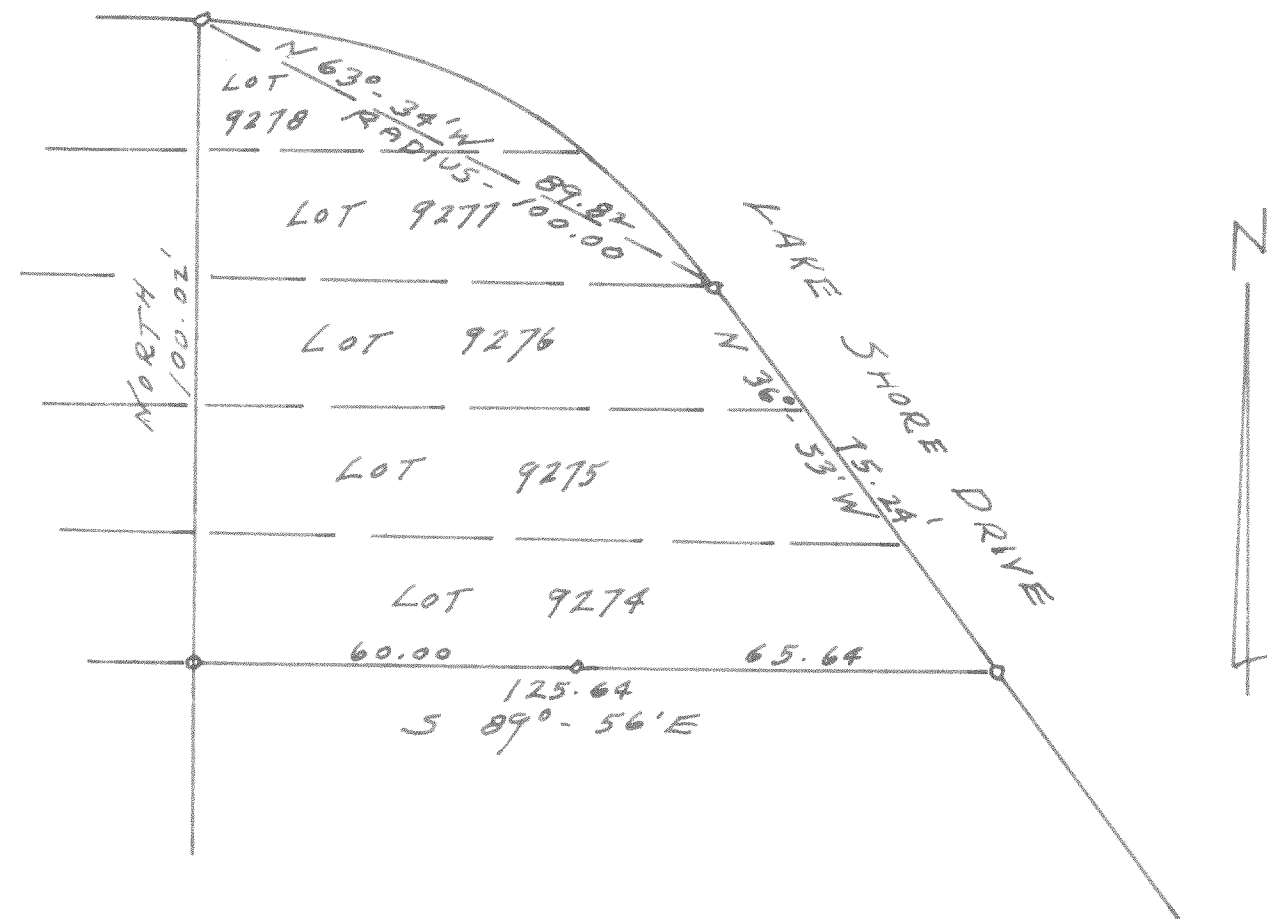


NOV. 1966

Lloyd Jensen
COUNTY SURVEYOR

4485

PLAT OF SURVEY
OF

LOT 26-27-28 LOST NATION PARK
SUBDIVISION, NE 1/4 SECTION 35,
T4N-R16E, WALWORTH COUNTY, WIS

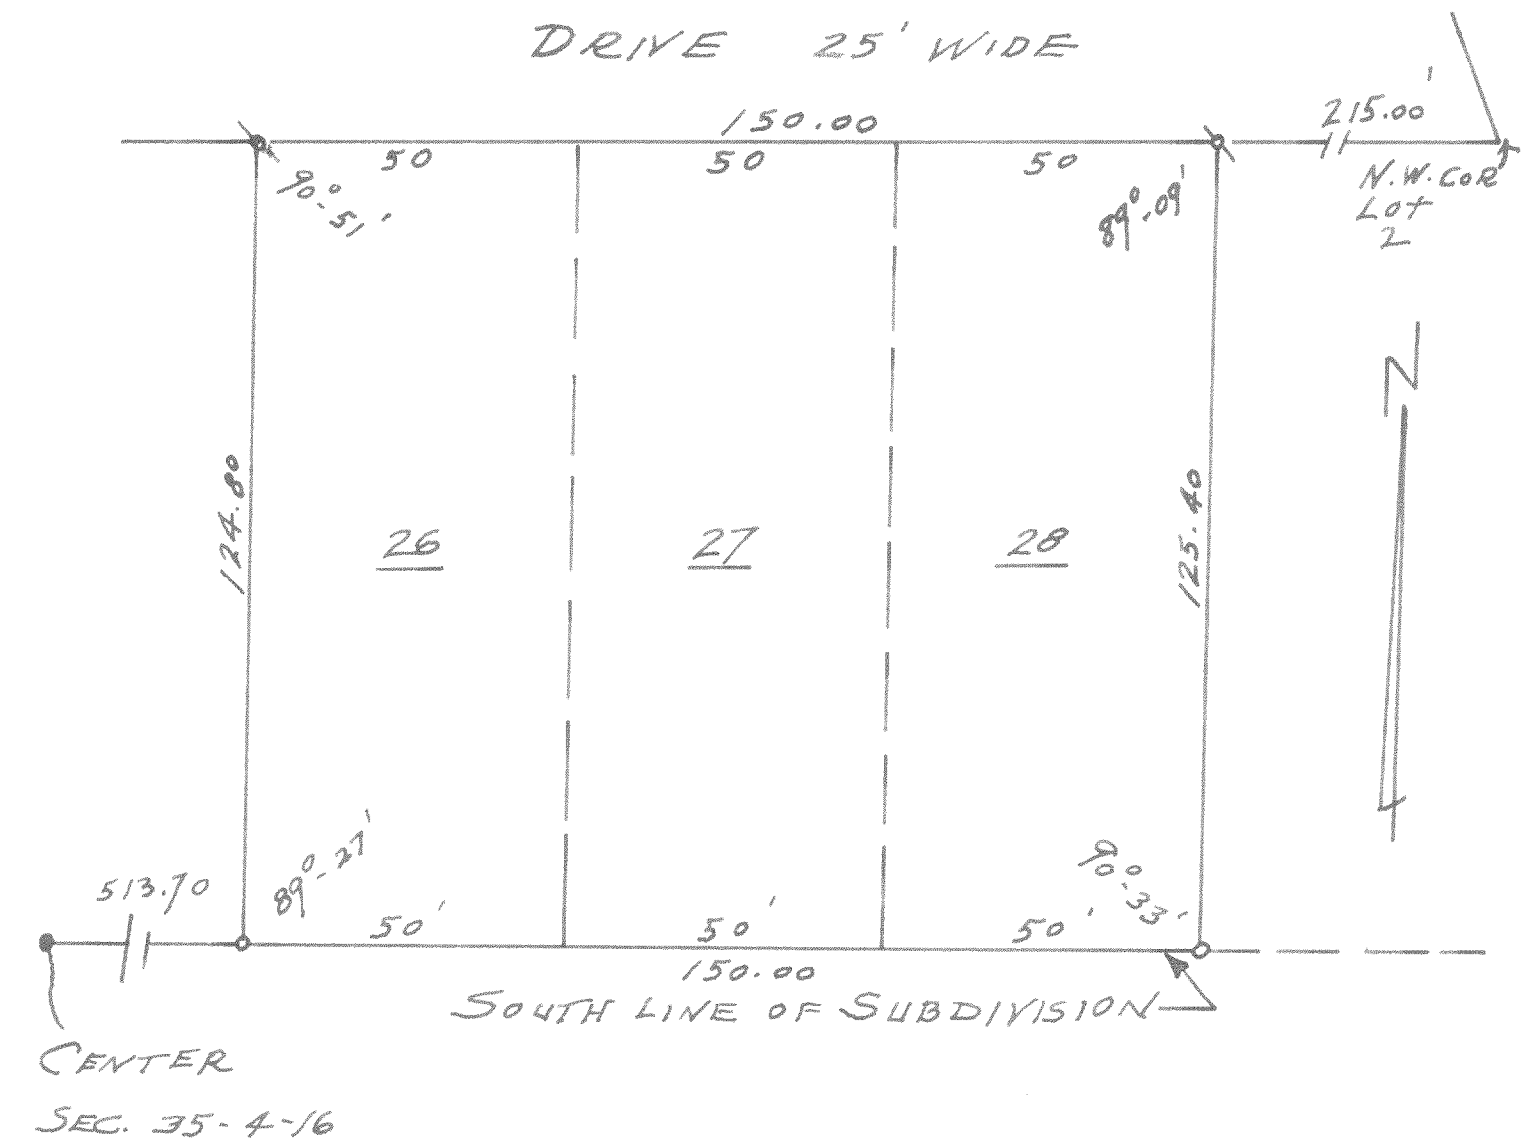

NOV. 1966

Lloyd Jensen
COUNTY SURVEYOR