


#4486

PLAT OF SURVEY
OF

Land located in NW $\frac{1}{4}$ Section 12
T3N R17E

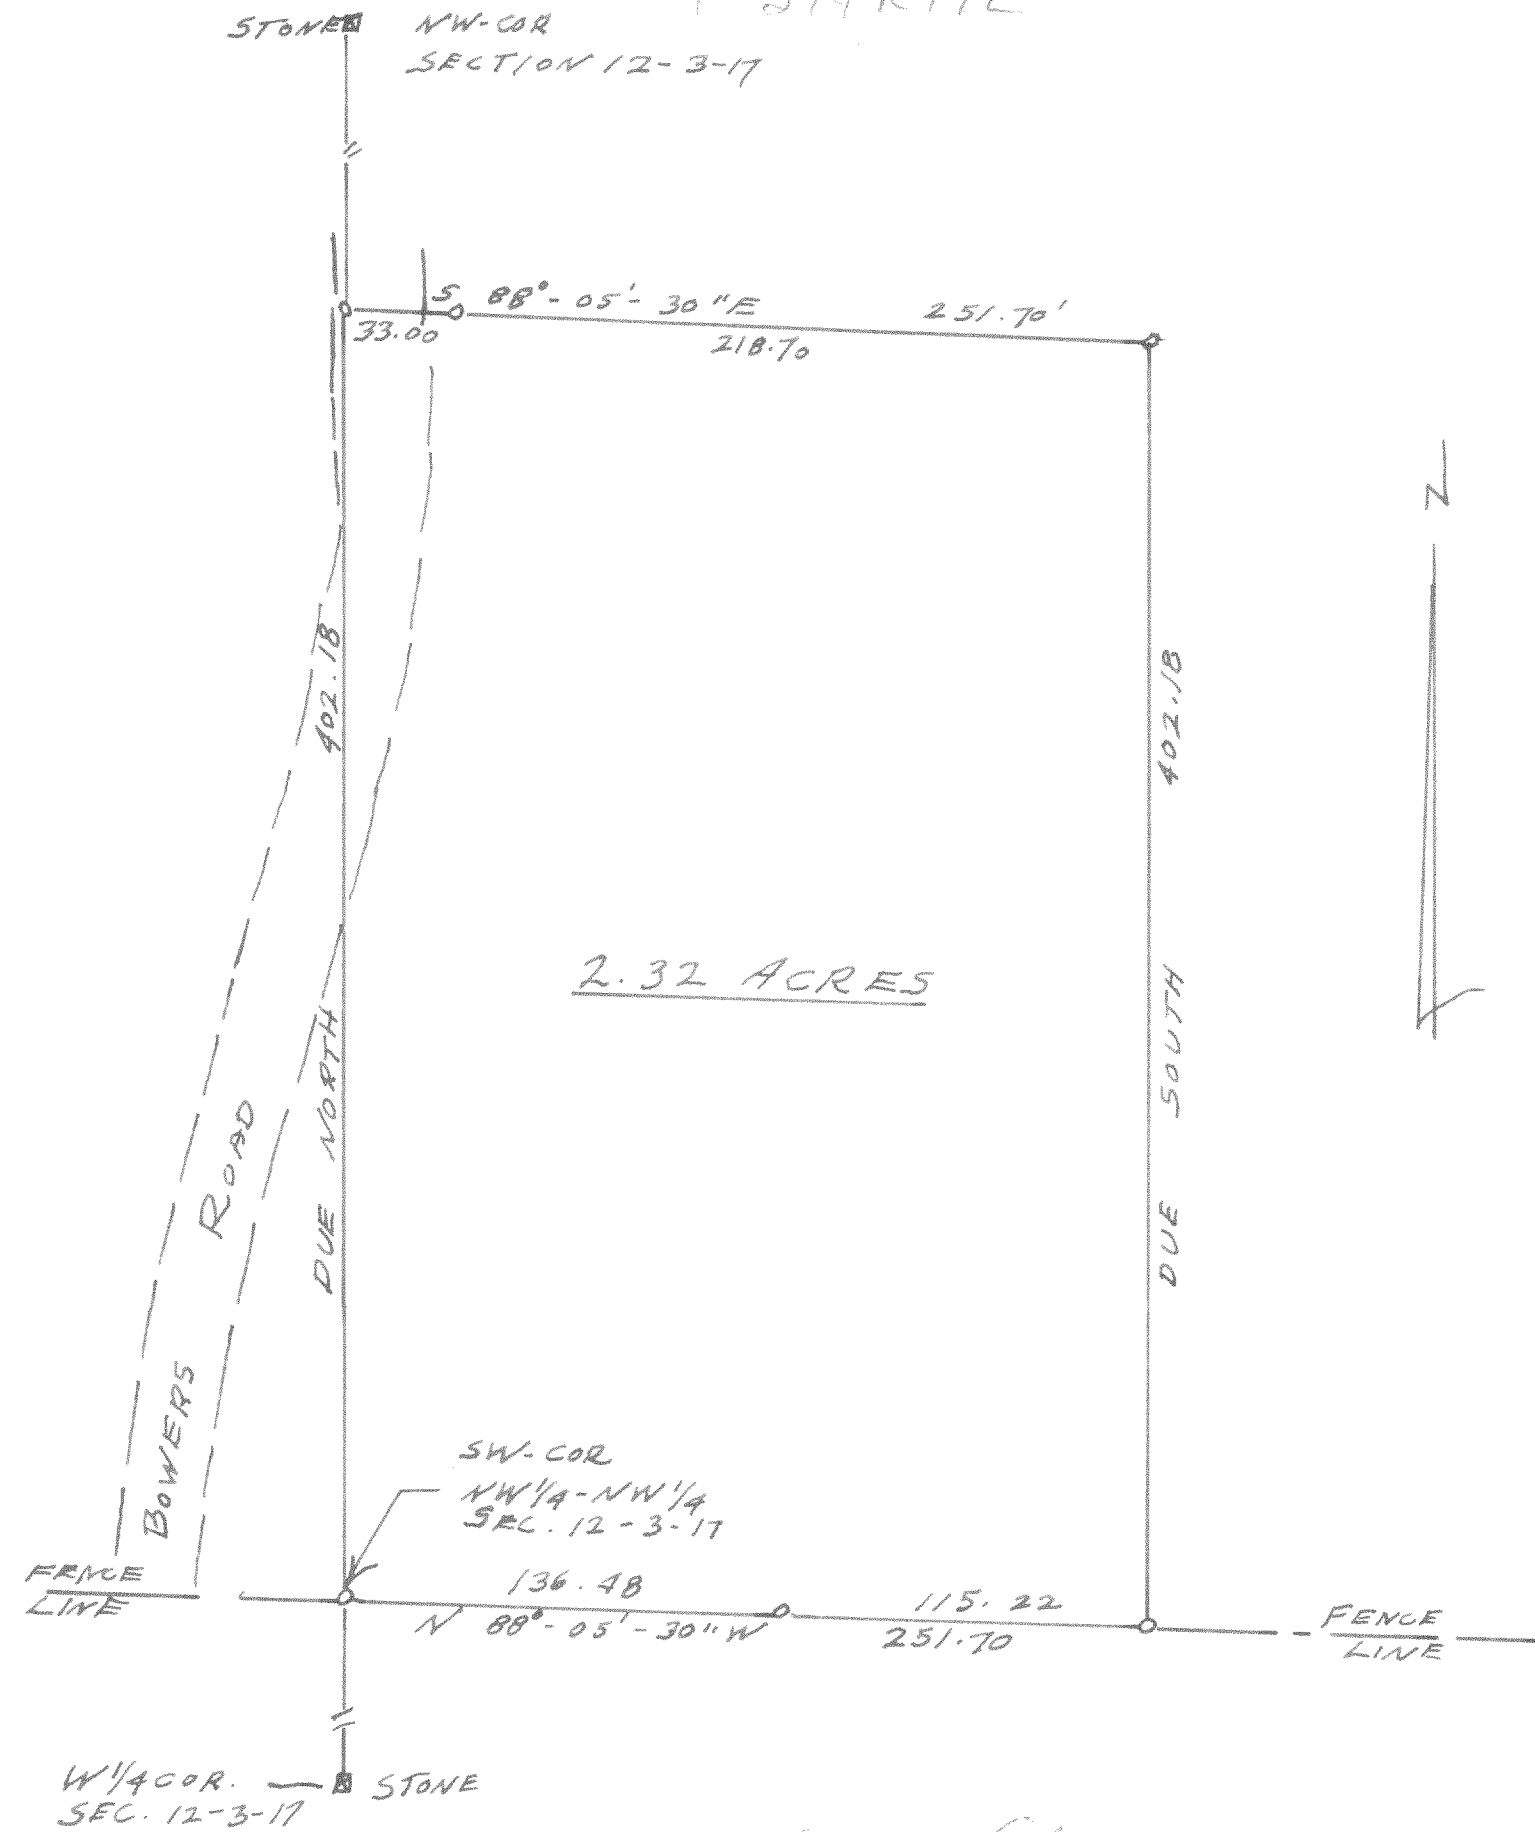


Lloyd Jensen
COUNTY SURVEYOR

#4487

PLAT OF SURVEY
OF

WEST 59 FEET OF THE EAST 191 FEET
OF THE SOUTH 110 FEET OF LOT 1
BLOCK 4, ORIGINAL PLAT OF WILLIAMS
BAY, WALWORTH COUNTY, WISCONSIN.

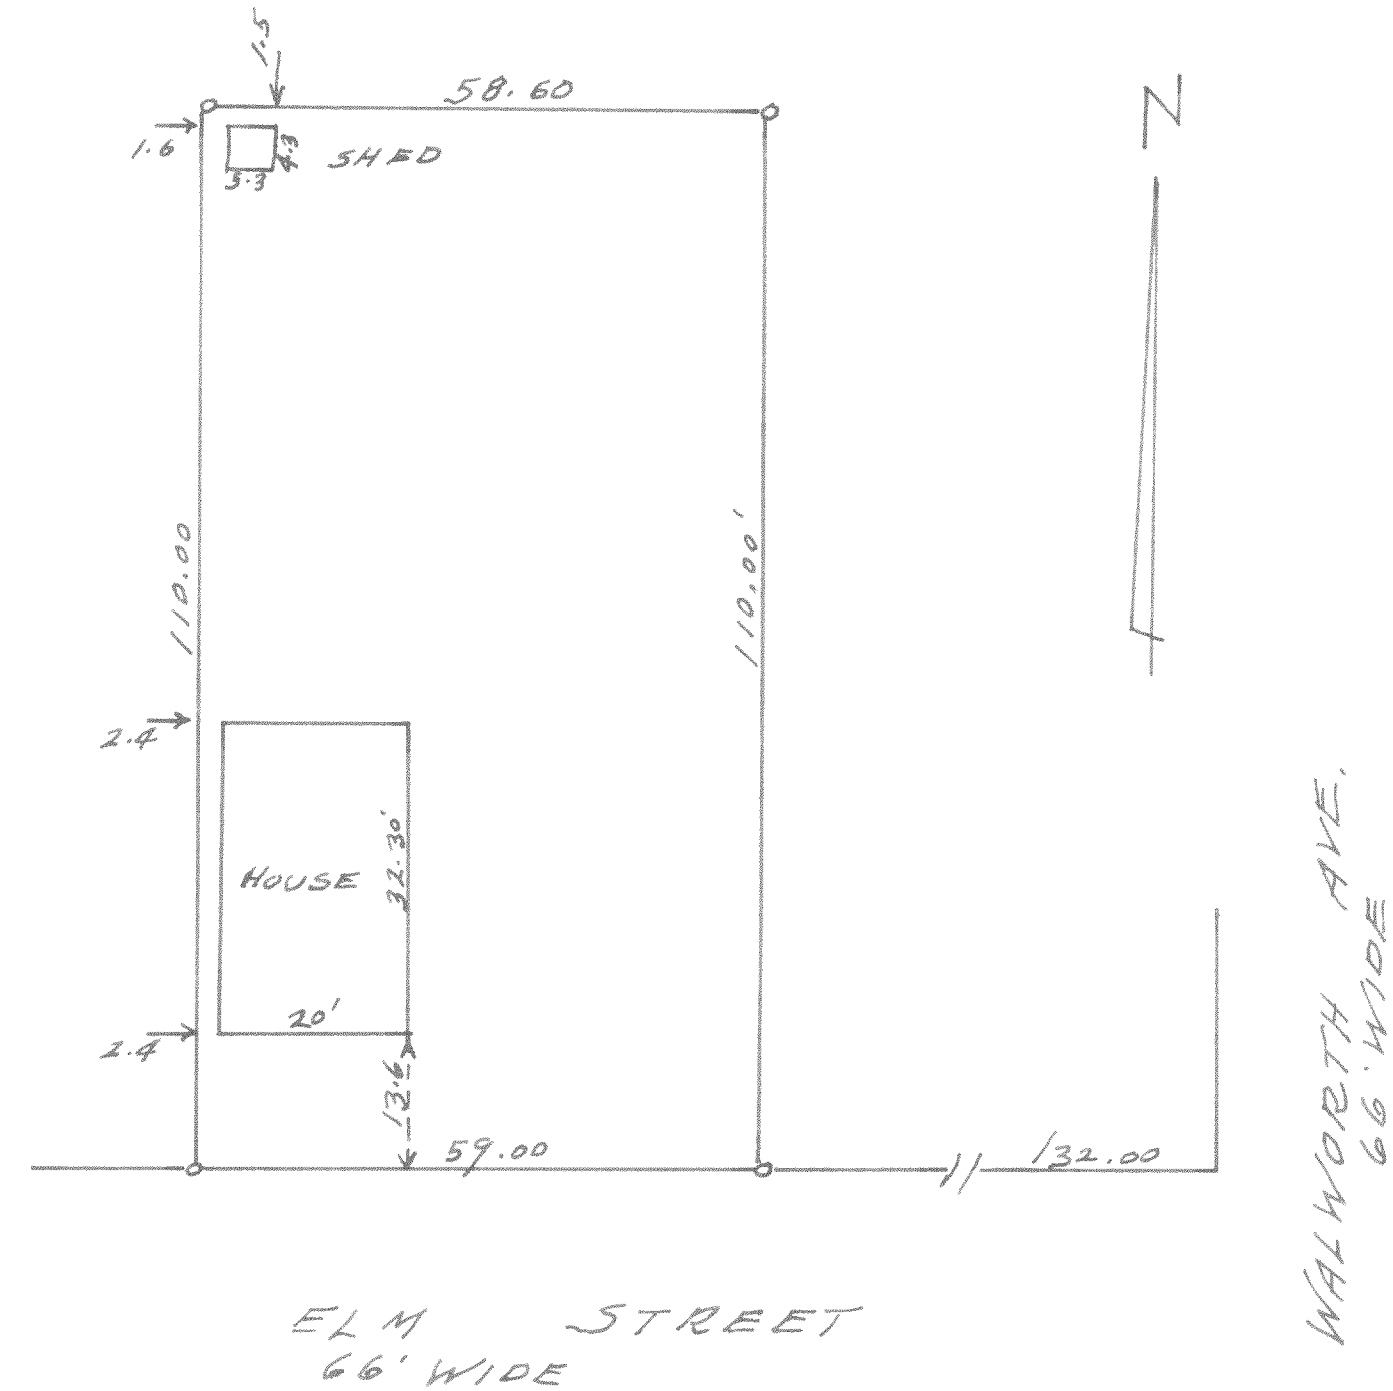

NOV. 1966

Lloyd Jensen
COUNTY SURVEYOR