


#4538

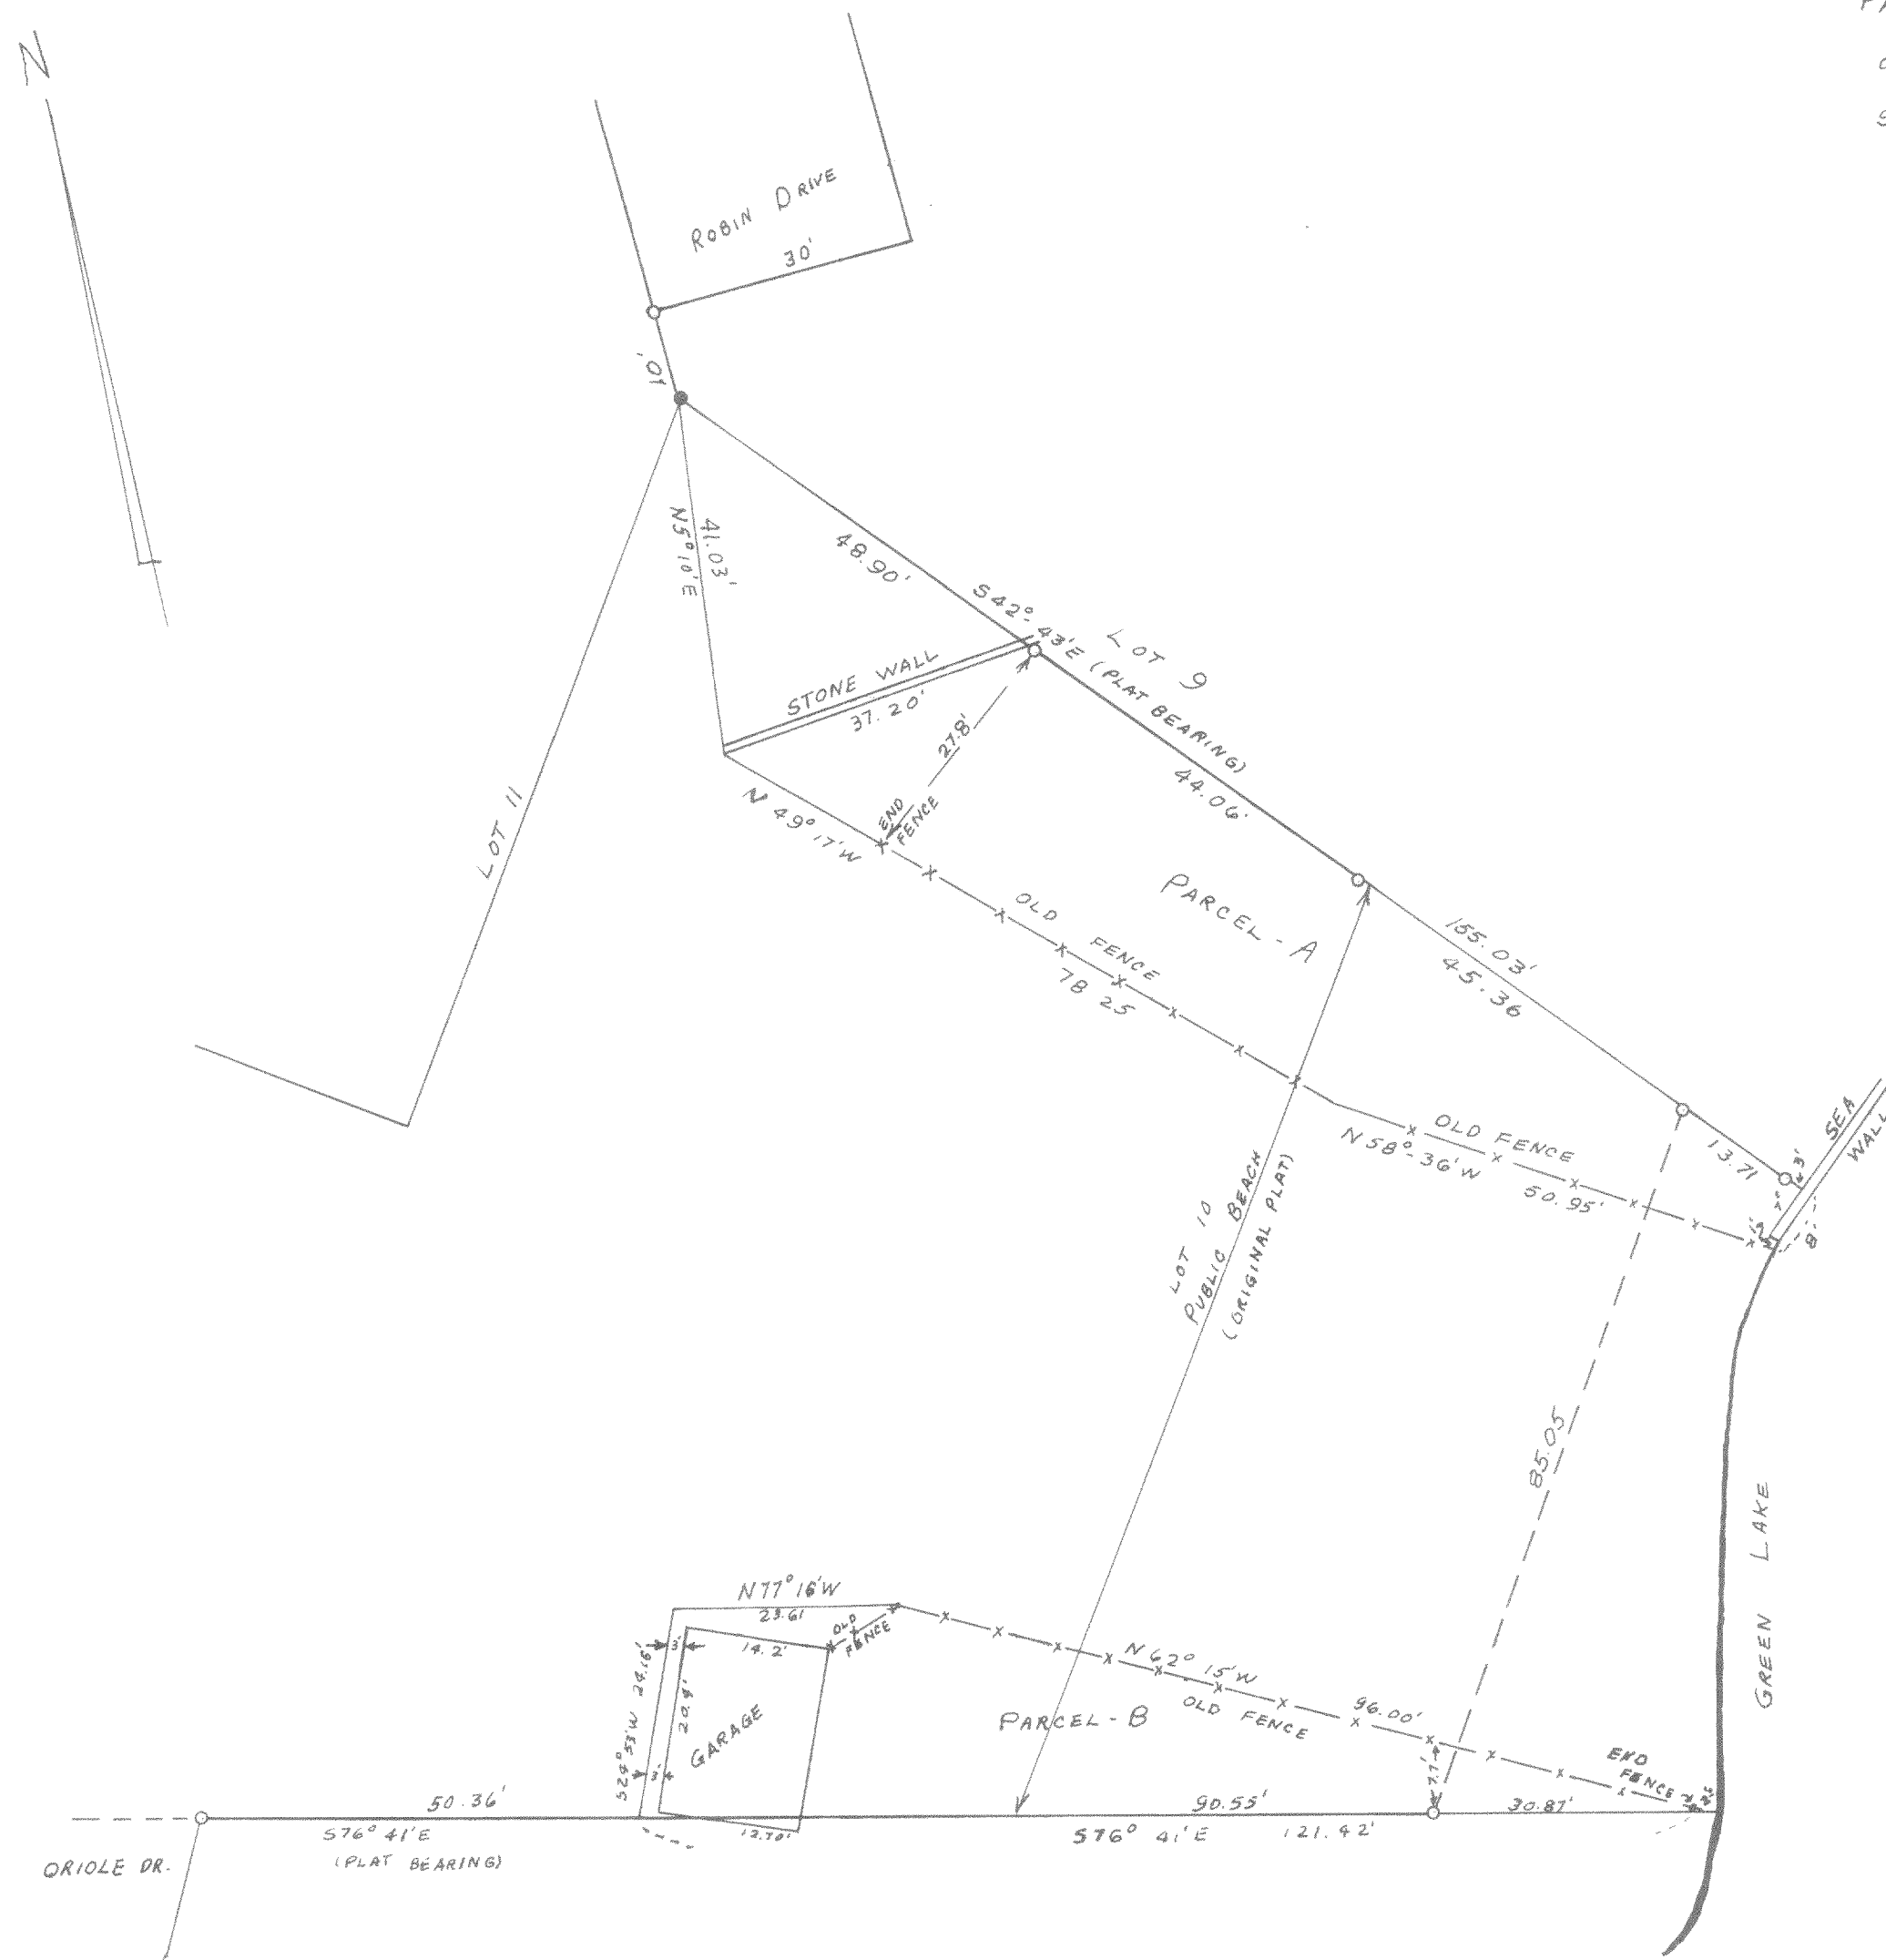

PART OF LOT 10 (PUBLIC BEACH)
OF FROEDTERTS GREEN LAKE PARK
SECTION 26, T4N-R16E, WALWORTH CO.
WISCONSIN

Hoyd K. Jensen
SURVEYOR
Aug. 1965

LEGEND

- POST IN CONCRETE
- IRON STAKE
- x-x- FENCE