


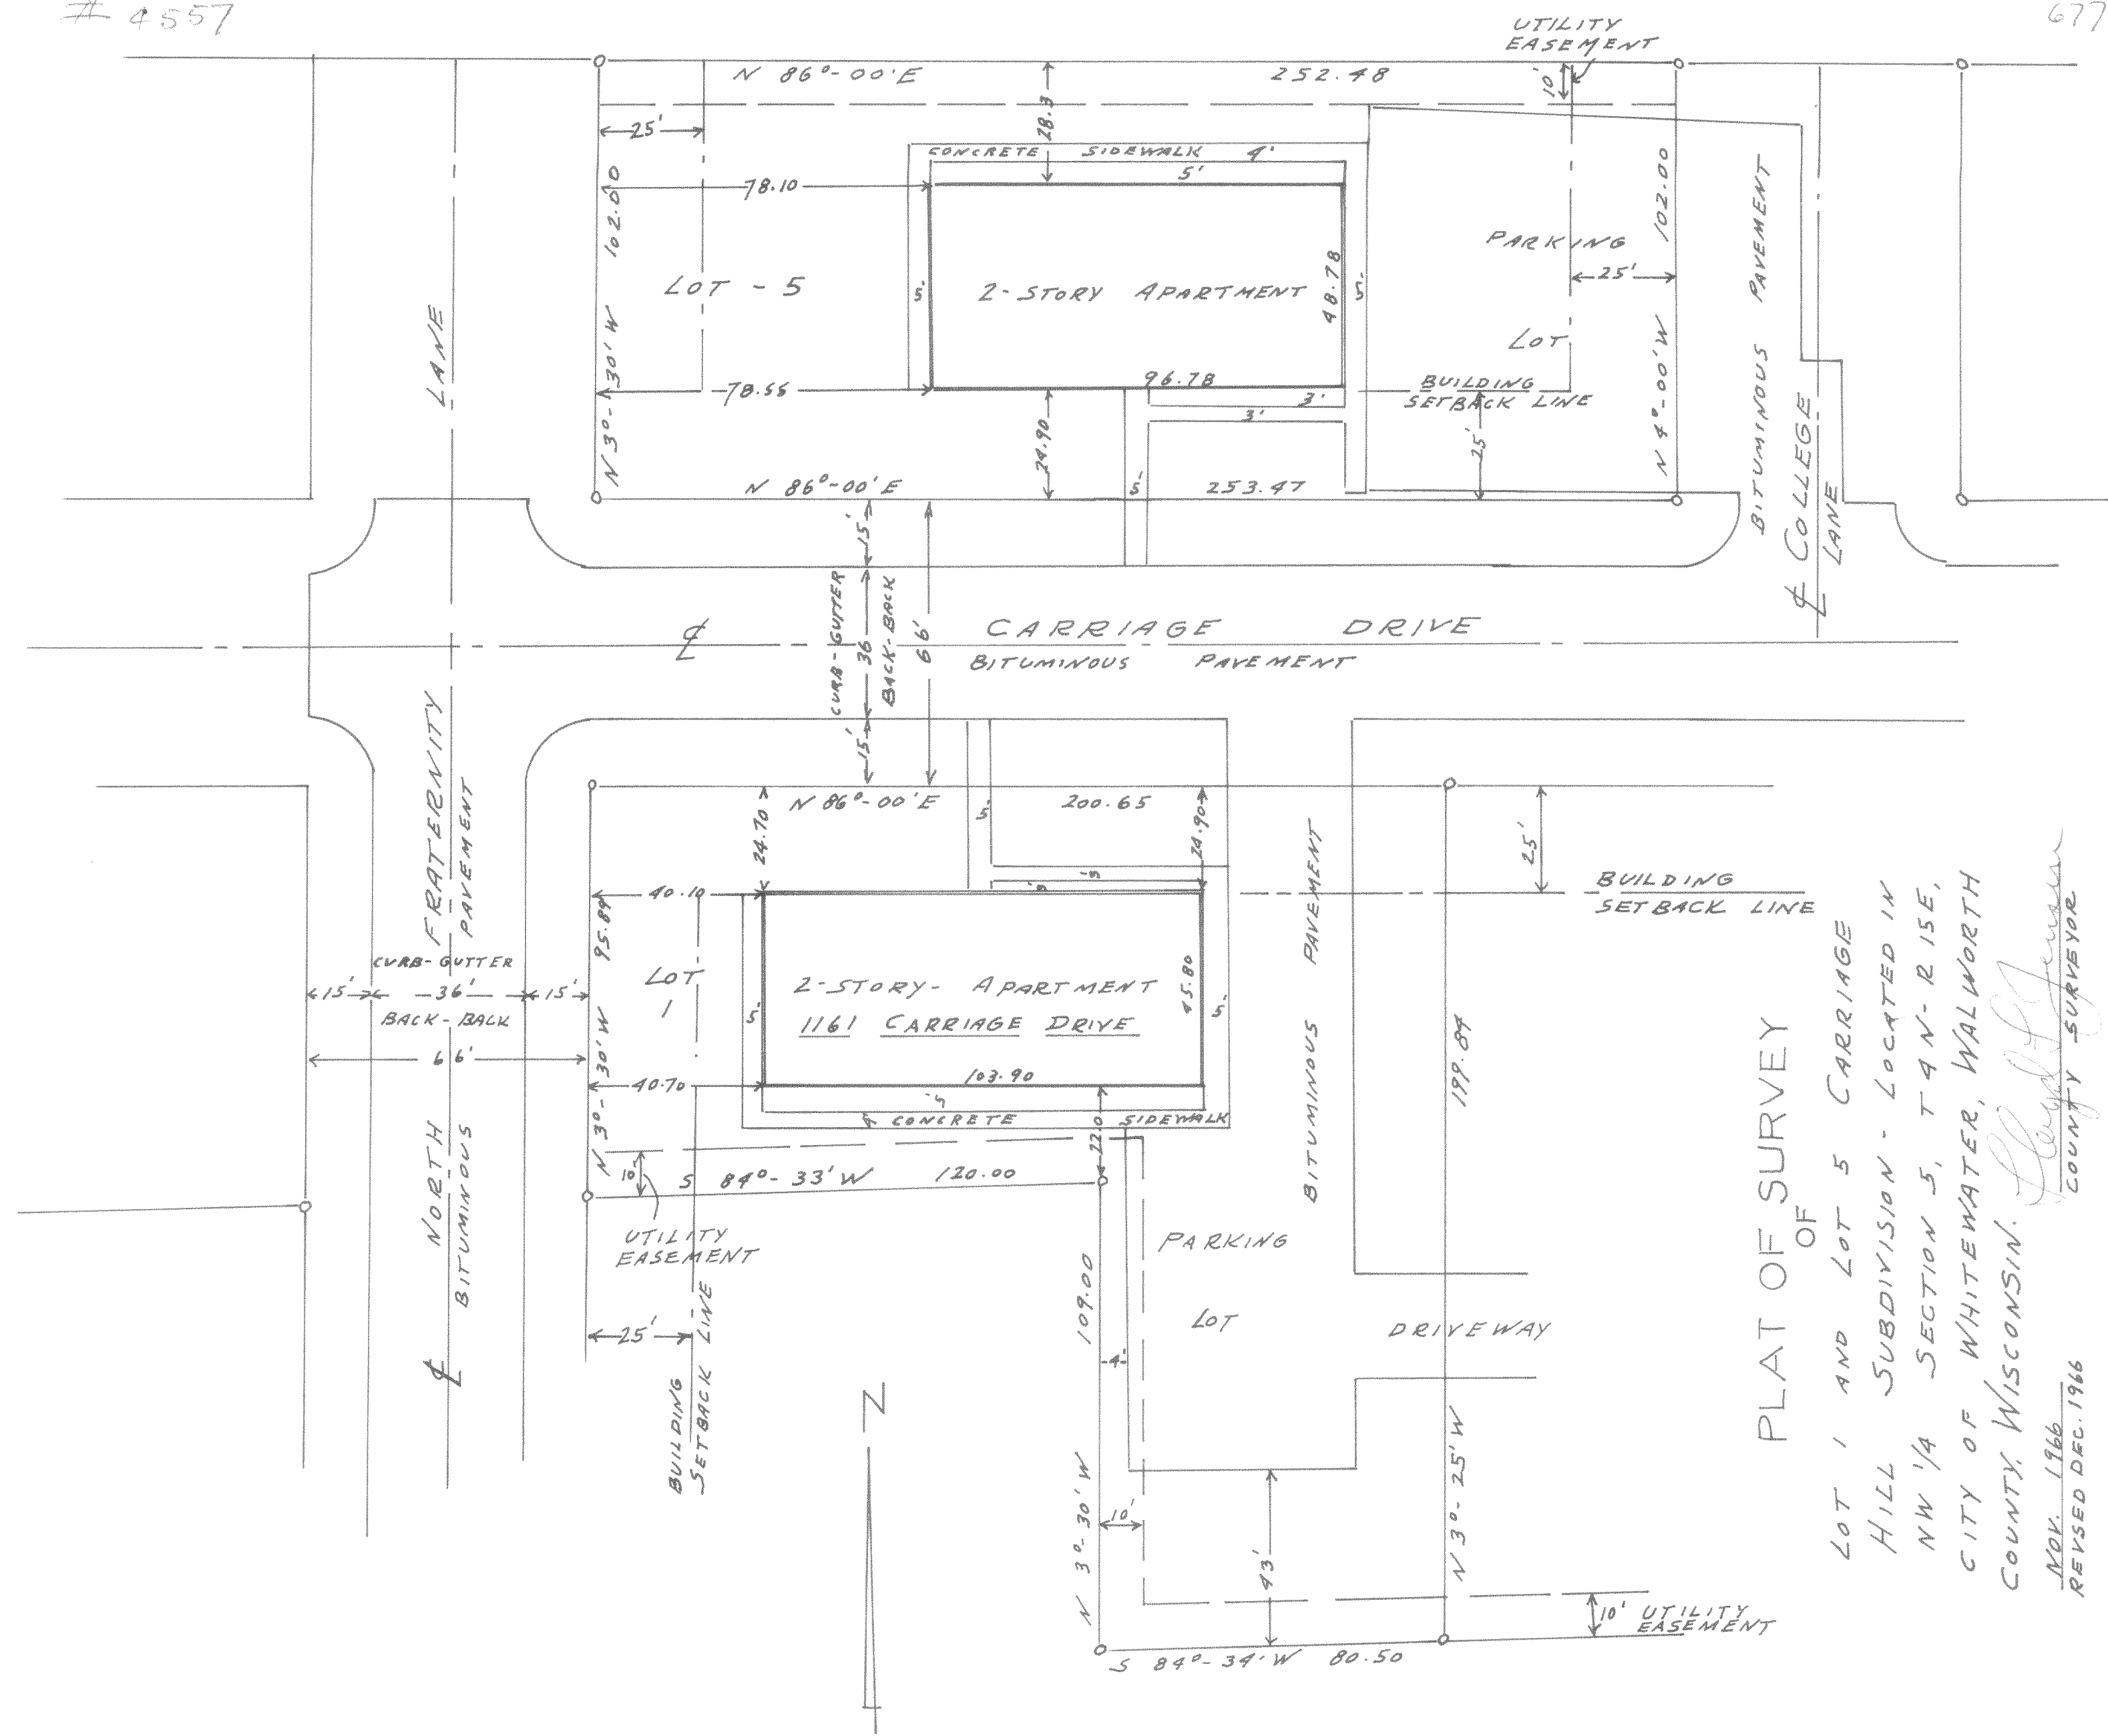

PLAT OF SURVEY
OF

LOT 1 AND LOT 5 CARRIAGE
HILL SUBDIVISION - LOCATED IN
NW 1/4 SECTION 5, T4N-R15E,
CITY OF WHITEWATER, WALWORTH
COUNTY, WISCONSIN.

David J. Jensen
COUNTY SURVEYOR

NOV. 1966
REVISED DEC. 1966