


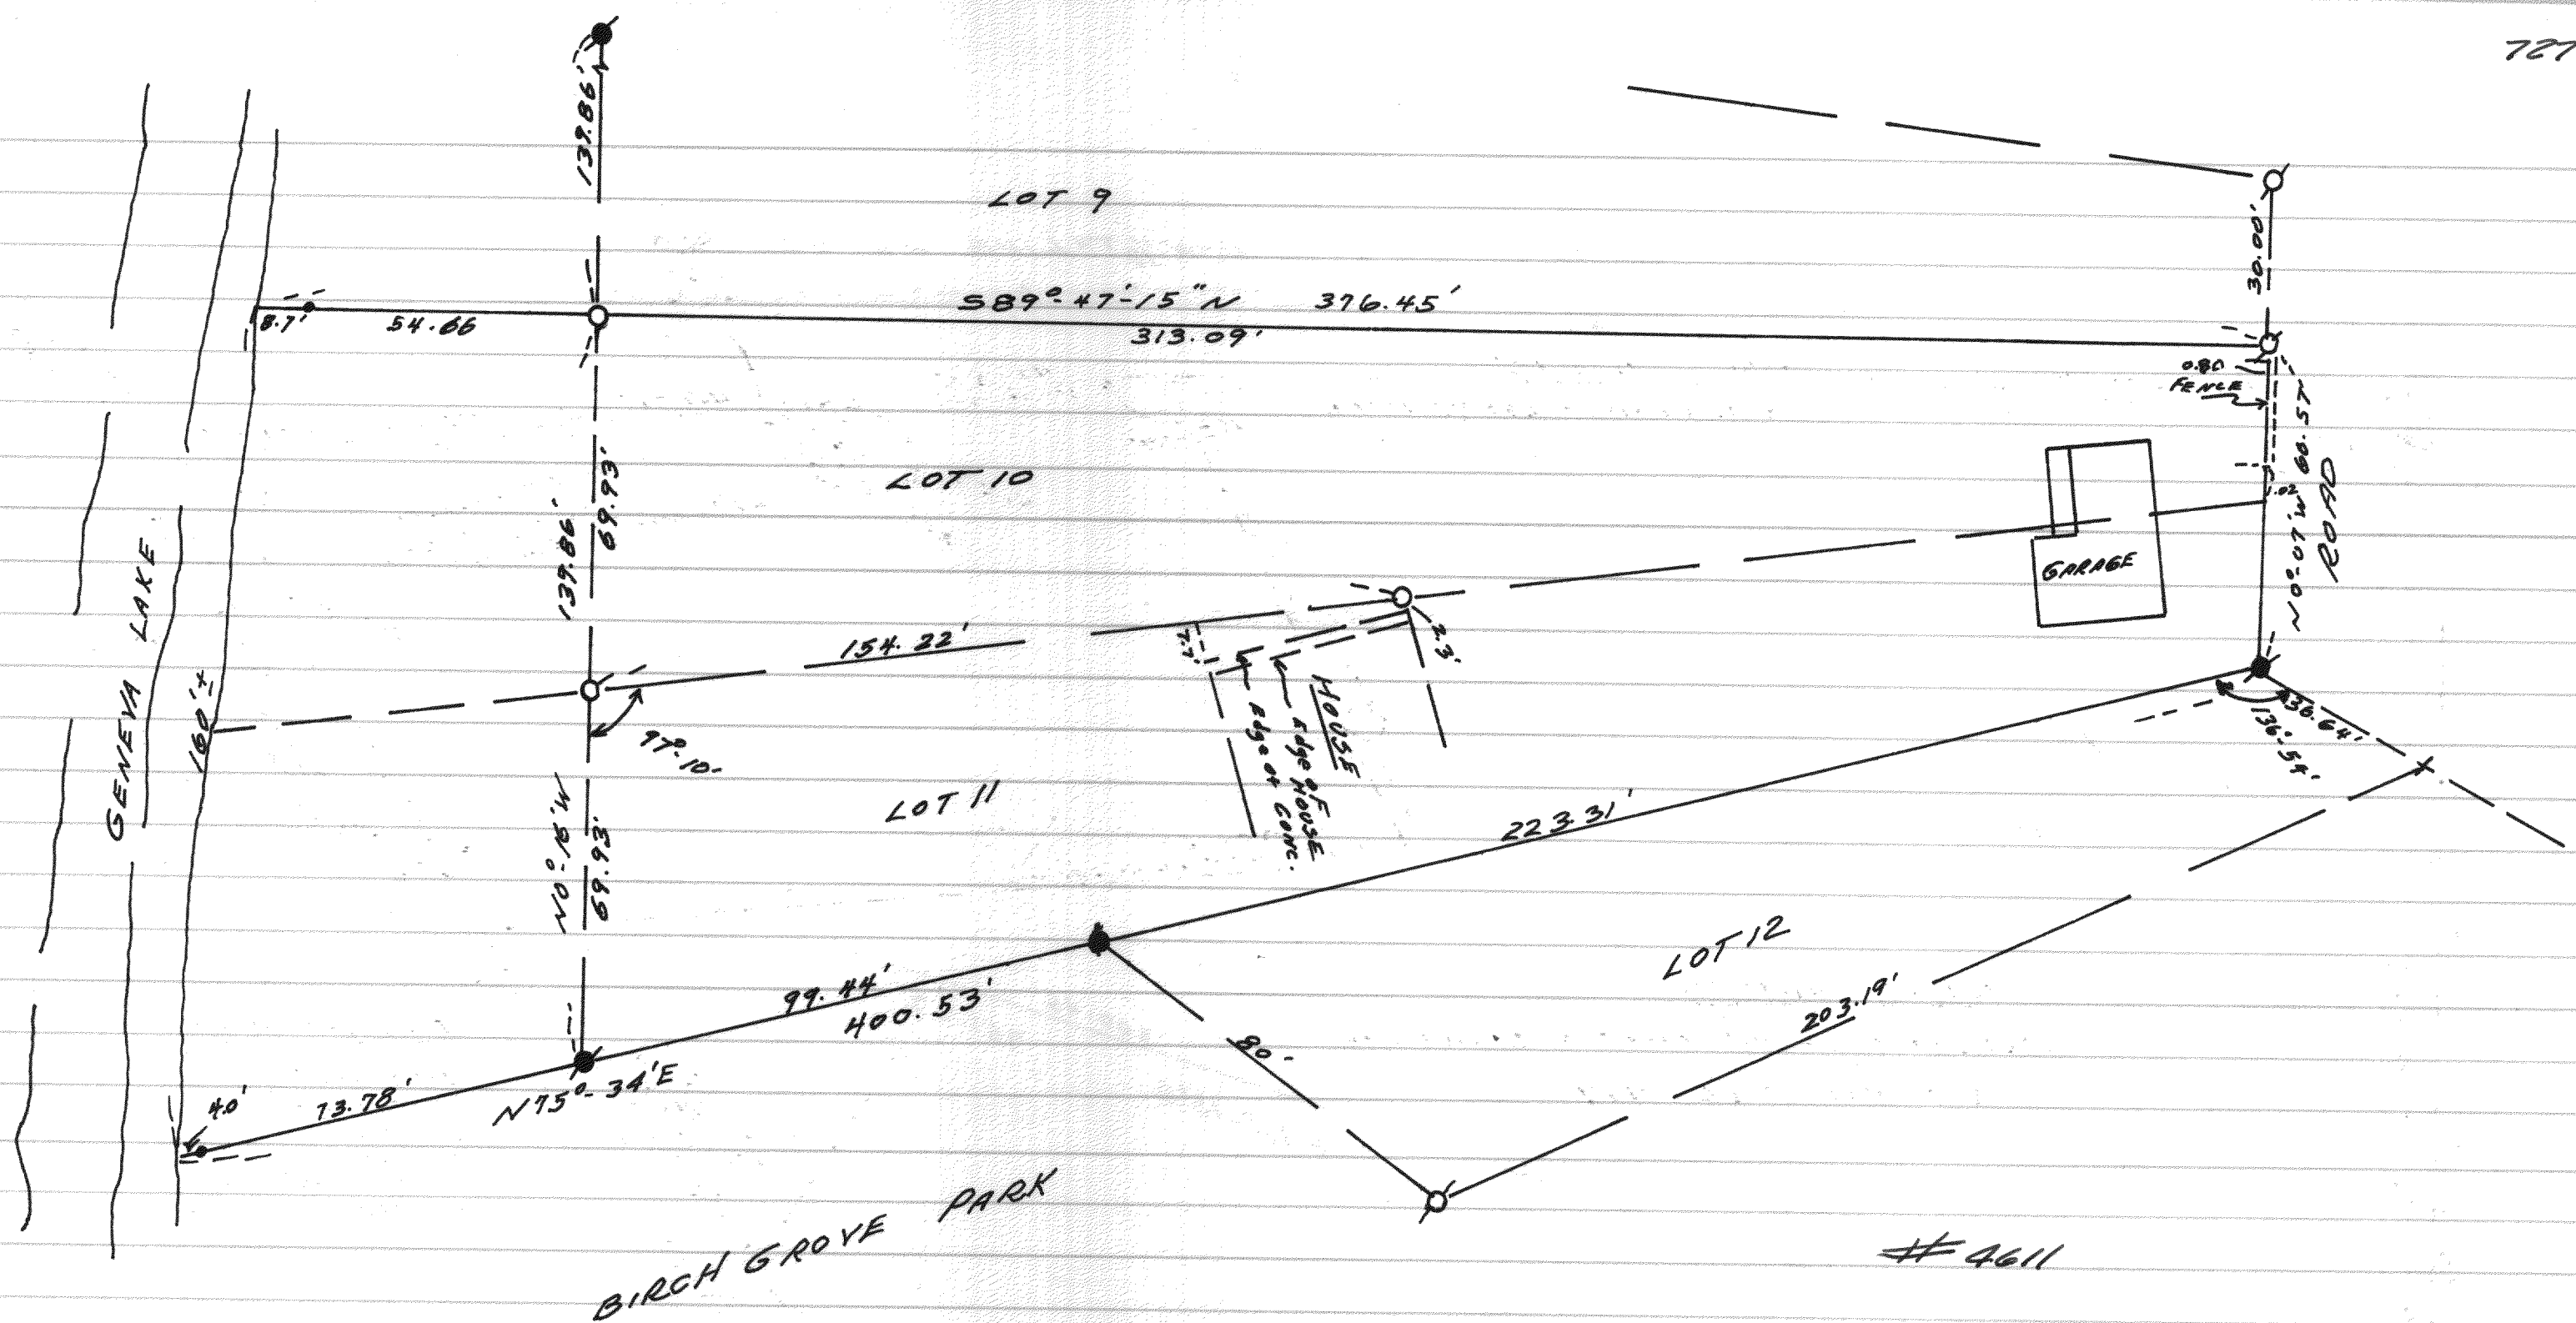

PLAT OF SURVEY
OF
LOTS 10 & 11 OF FIRST ADDITION
CEDAR POINT PARK, VILLAGE OF
WILLIAMS BAY, WISCONSIN.
MARCH 1969
Lloyd L. Jensen
COUNTY SURVEYOR