

4667


4668

PLAT OF SURVEY

05

LOTS 147 → 151 AND 125 → 131
PELL LAKE ADDITION SUBD.
SW 1/4 SECTION 19, TIN-RIBE
WALWORTH COUNTY, WISCONSIN
JUNE 1969

Hayden L. Jensen
SURVEYOR

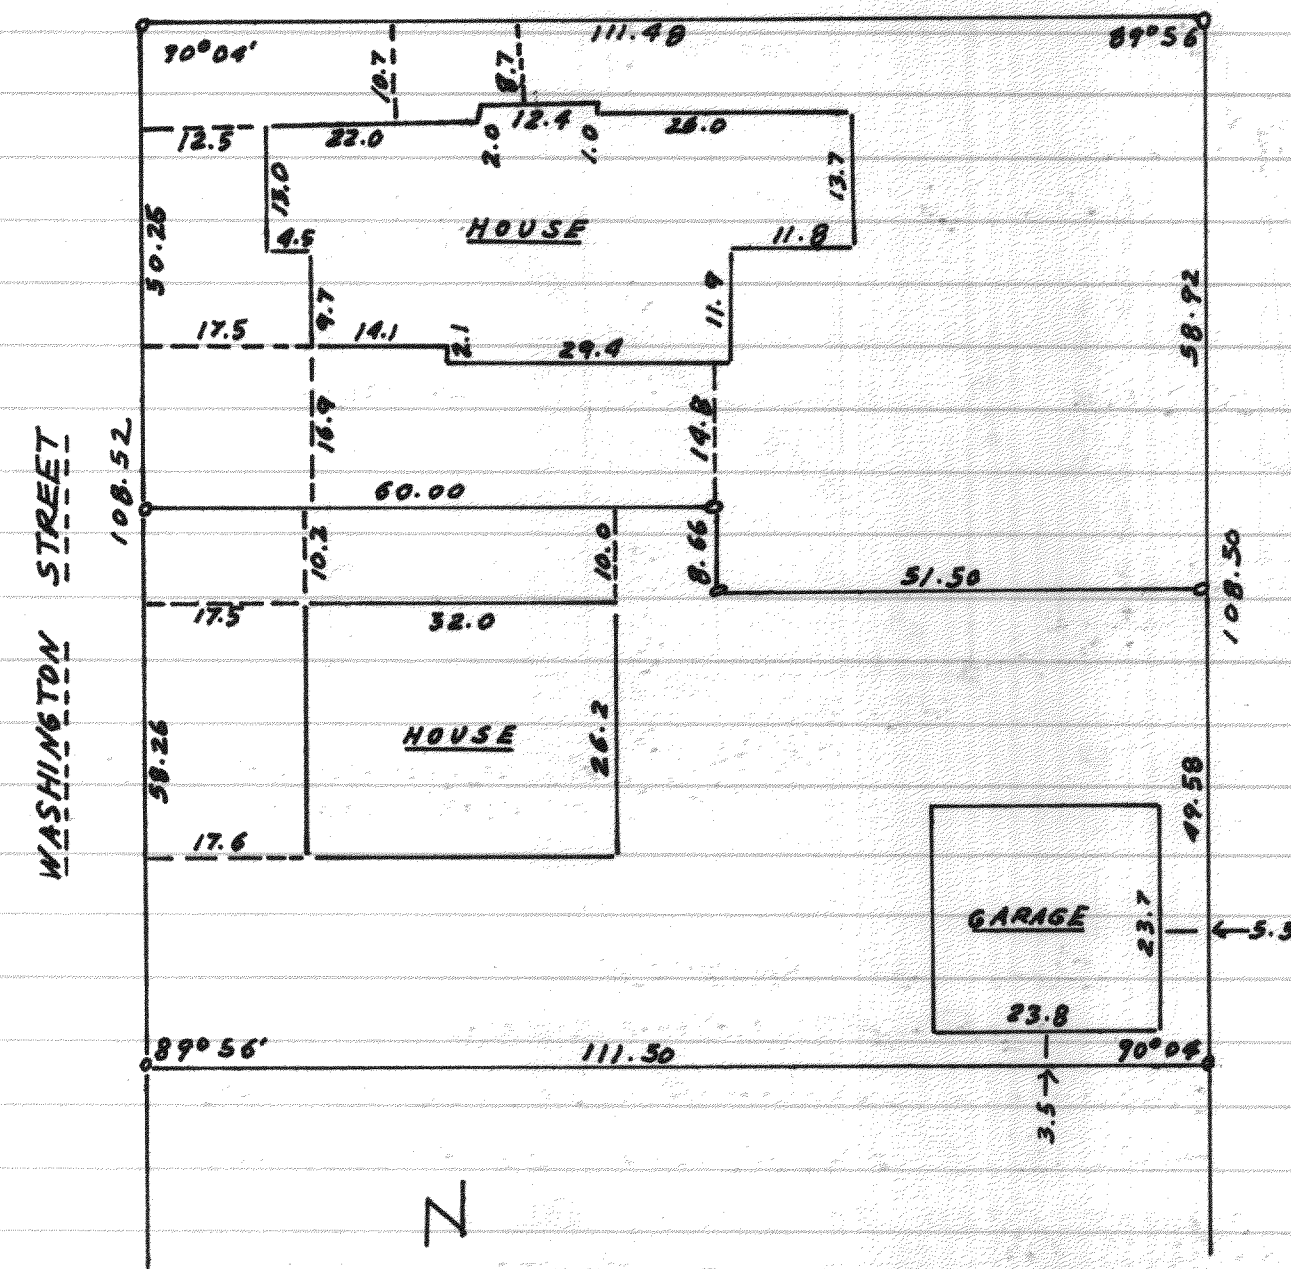


N

PLAT OF SURVEY
OF

THE NORTH 108.50' OF THE WEST 111.50'
BLOCK 14, OF THE ORIGINAL PLAT, CITY
OF ELKHORN, WALWORTH COUNTY, WISCONSIN.

MAY 27, 1969

Lloyd L. Jensen
SUPERVISOR

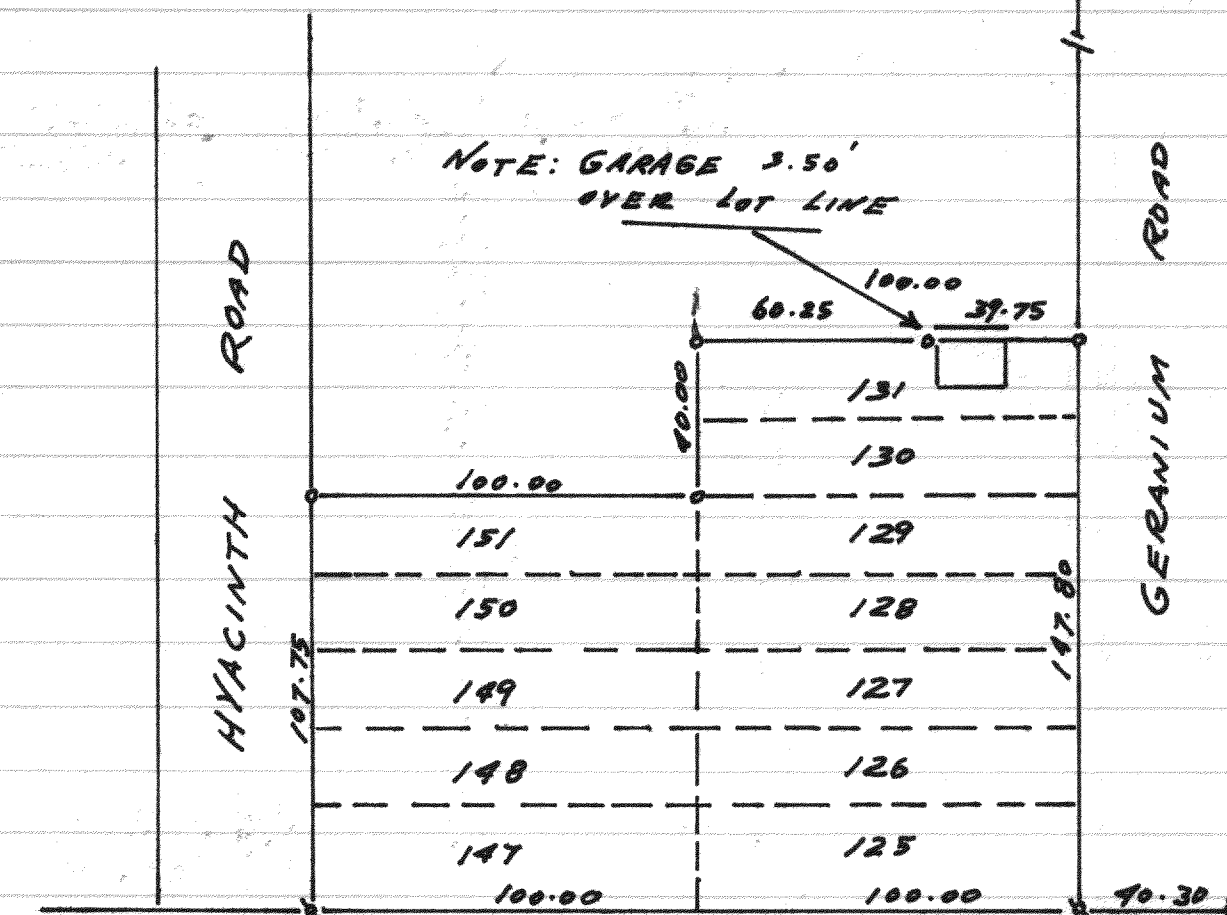

NOTE: GARAGE 3.50'
OVER LOT LINE

UNPLATTED LAND