


2954

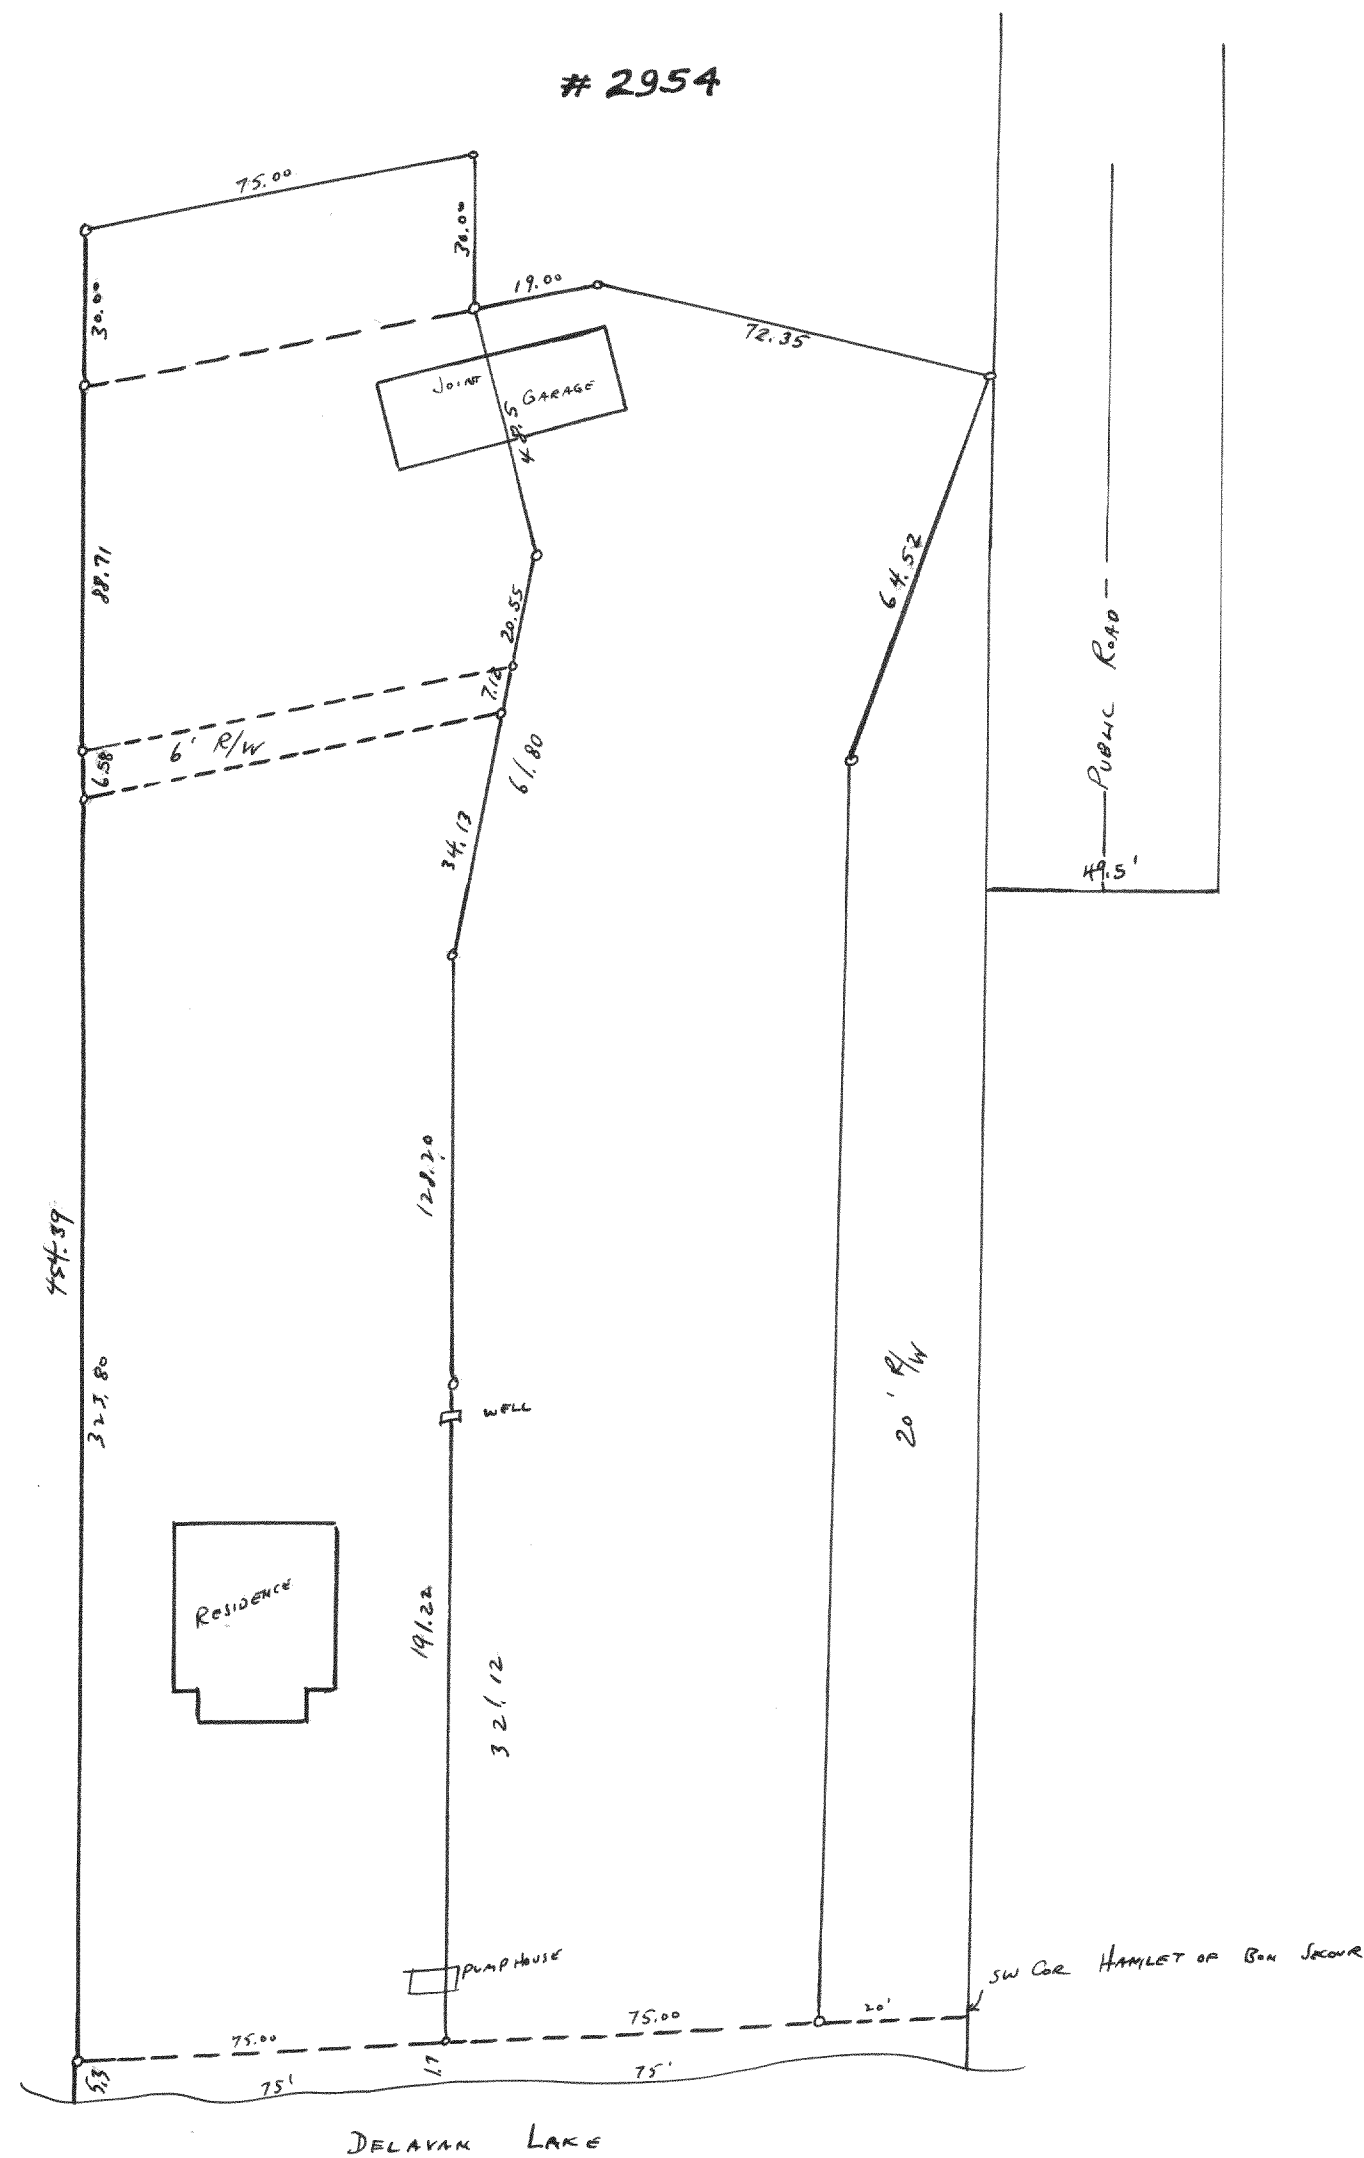


PLAT OF SURVEY OF LAND IN SE 1/4 of SECTION 29
T3N R16E WALWORTH COUNTY WISCONSIN

June 1954


Lloyd L. Jensen
County Surveyor

2955

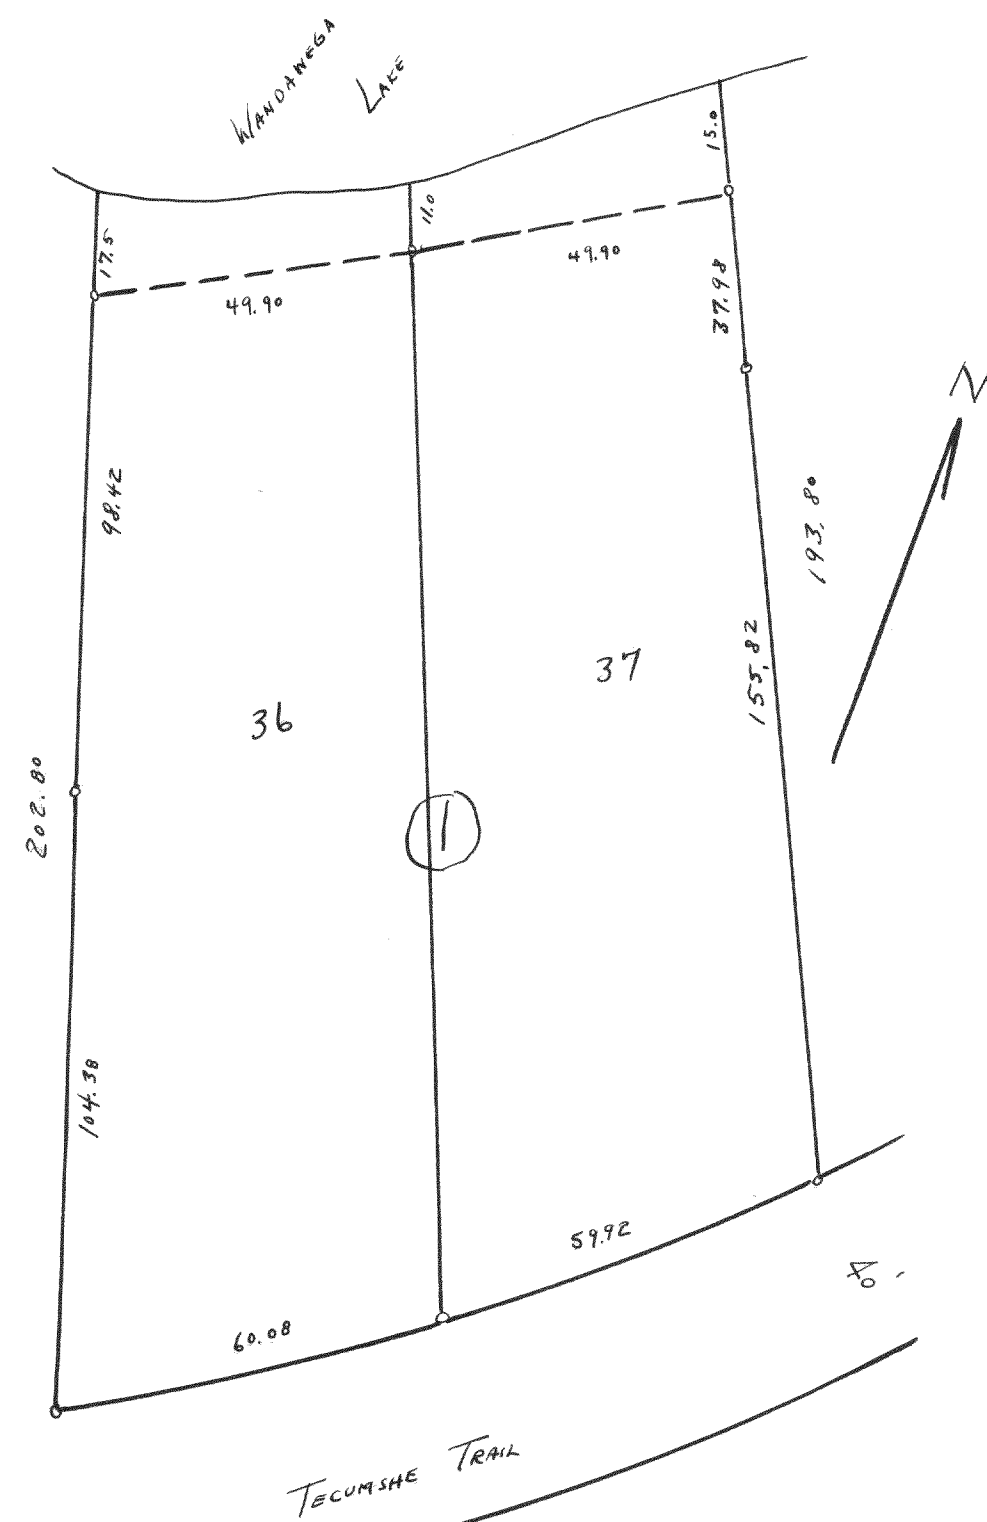

PLAT OF SURVEY OF LOTS 36 & 37
BLOCK 1 LAKE WANDAUAGA HIGHLANDS
T3N R16E WALWORTH COUNTY WIS.
May 1950
Lloyd L. Jensen
County Surveyor

2956

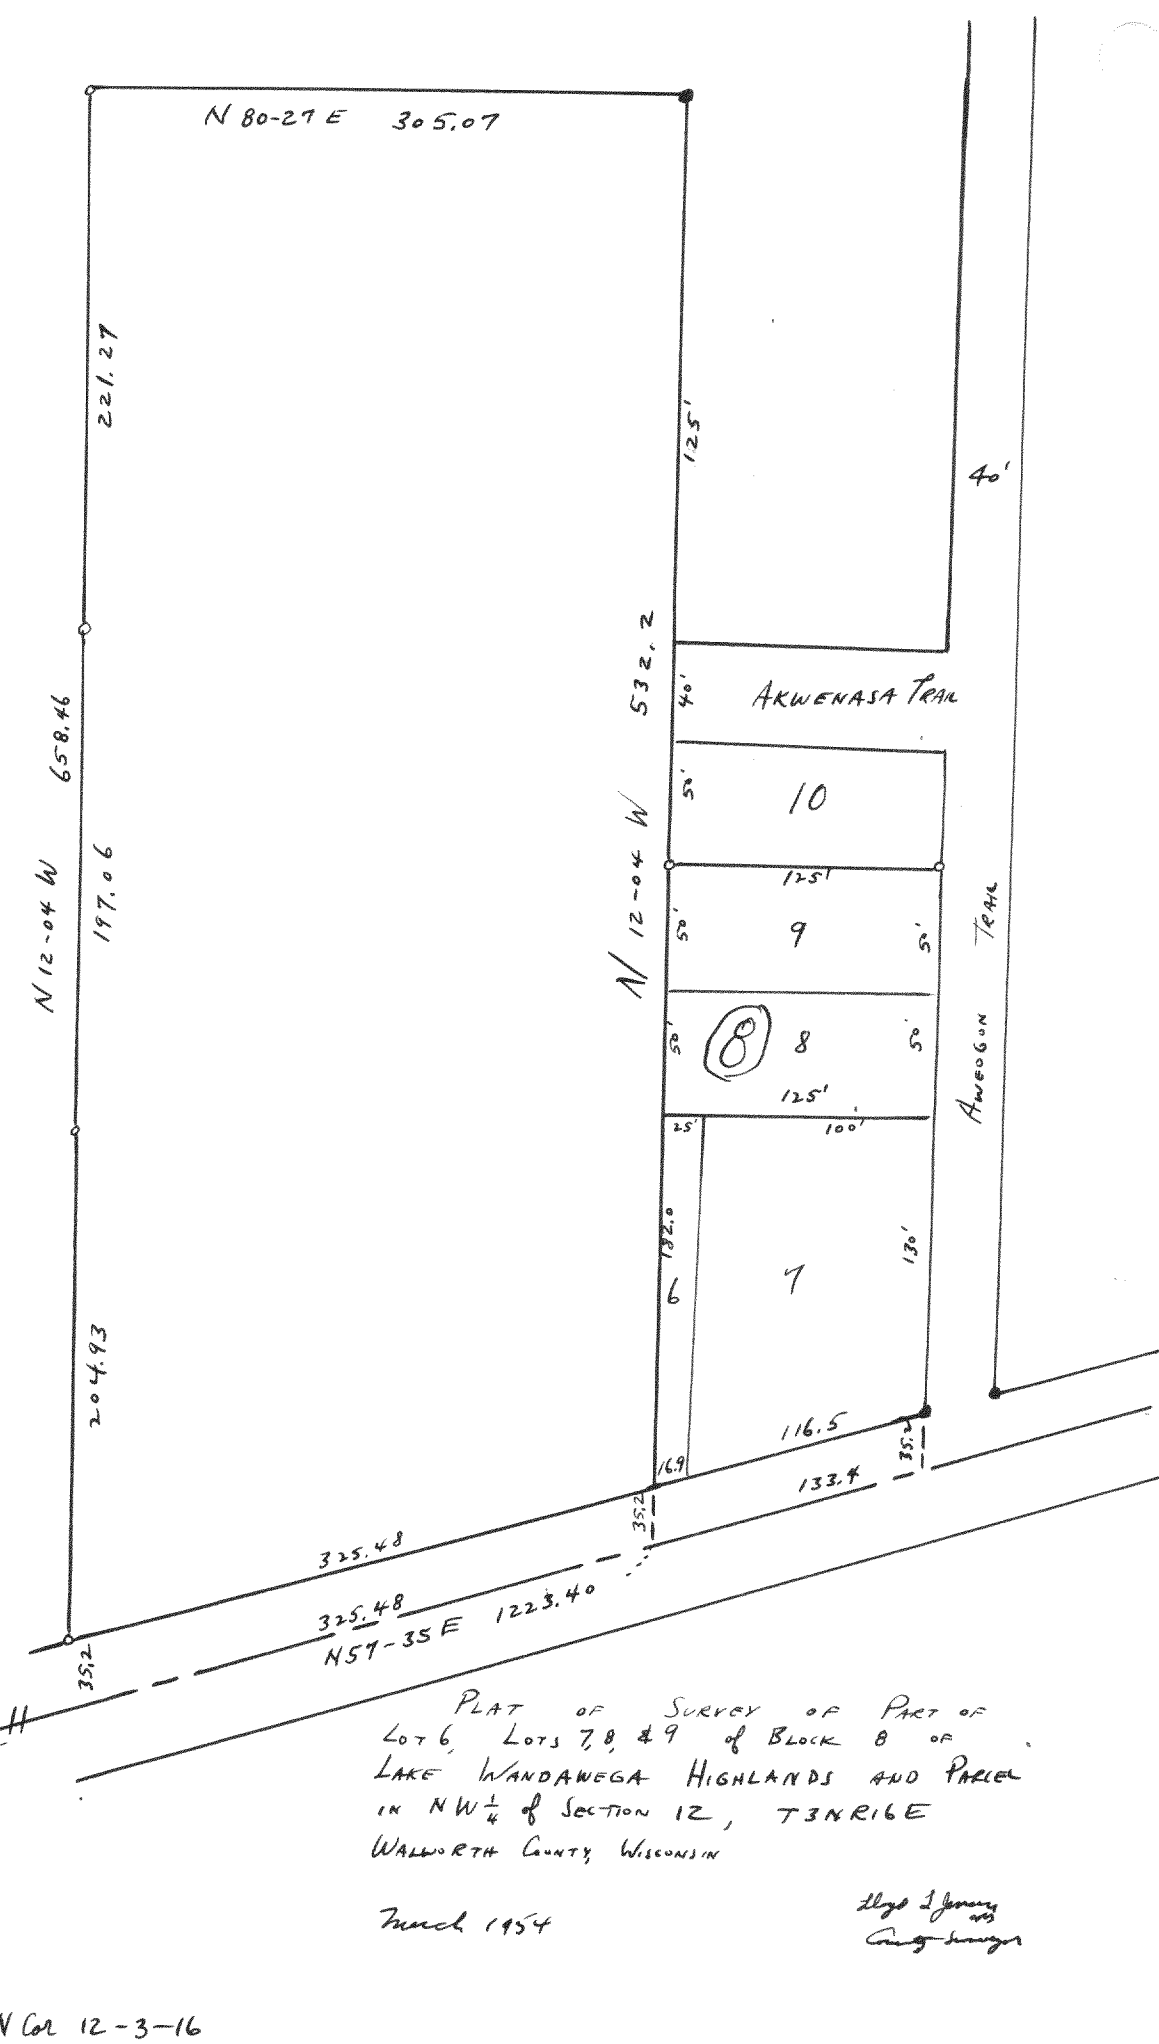

PLAT OF SURVEY OF PART OF
LOT 6, LOTS 7, 8, & 9 OF BLOCK 8 OF
LAKE WANDAUAGA HIGHLANDS AND PARCEL
IN NW 1/4 of SECTION 12, T3N R16E
WALWORTH COUNTY WISCONSIN

March 1954

Lloyd L. Jensen
County Surveyor

SW COR 12-3-16