

#4808


PLAT OF SURVEY

OF

TELEPHONE LINE LOCATION
FOR "THE ABBEY", FONTANA-
ON-GENEVA LAKE, WISCONSIN.

ОСТ. 1962

Lloyd L Jensen
CO. SURVEYOR

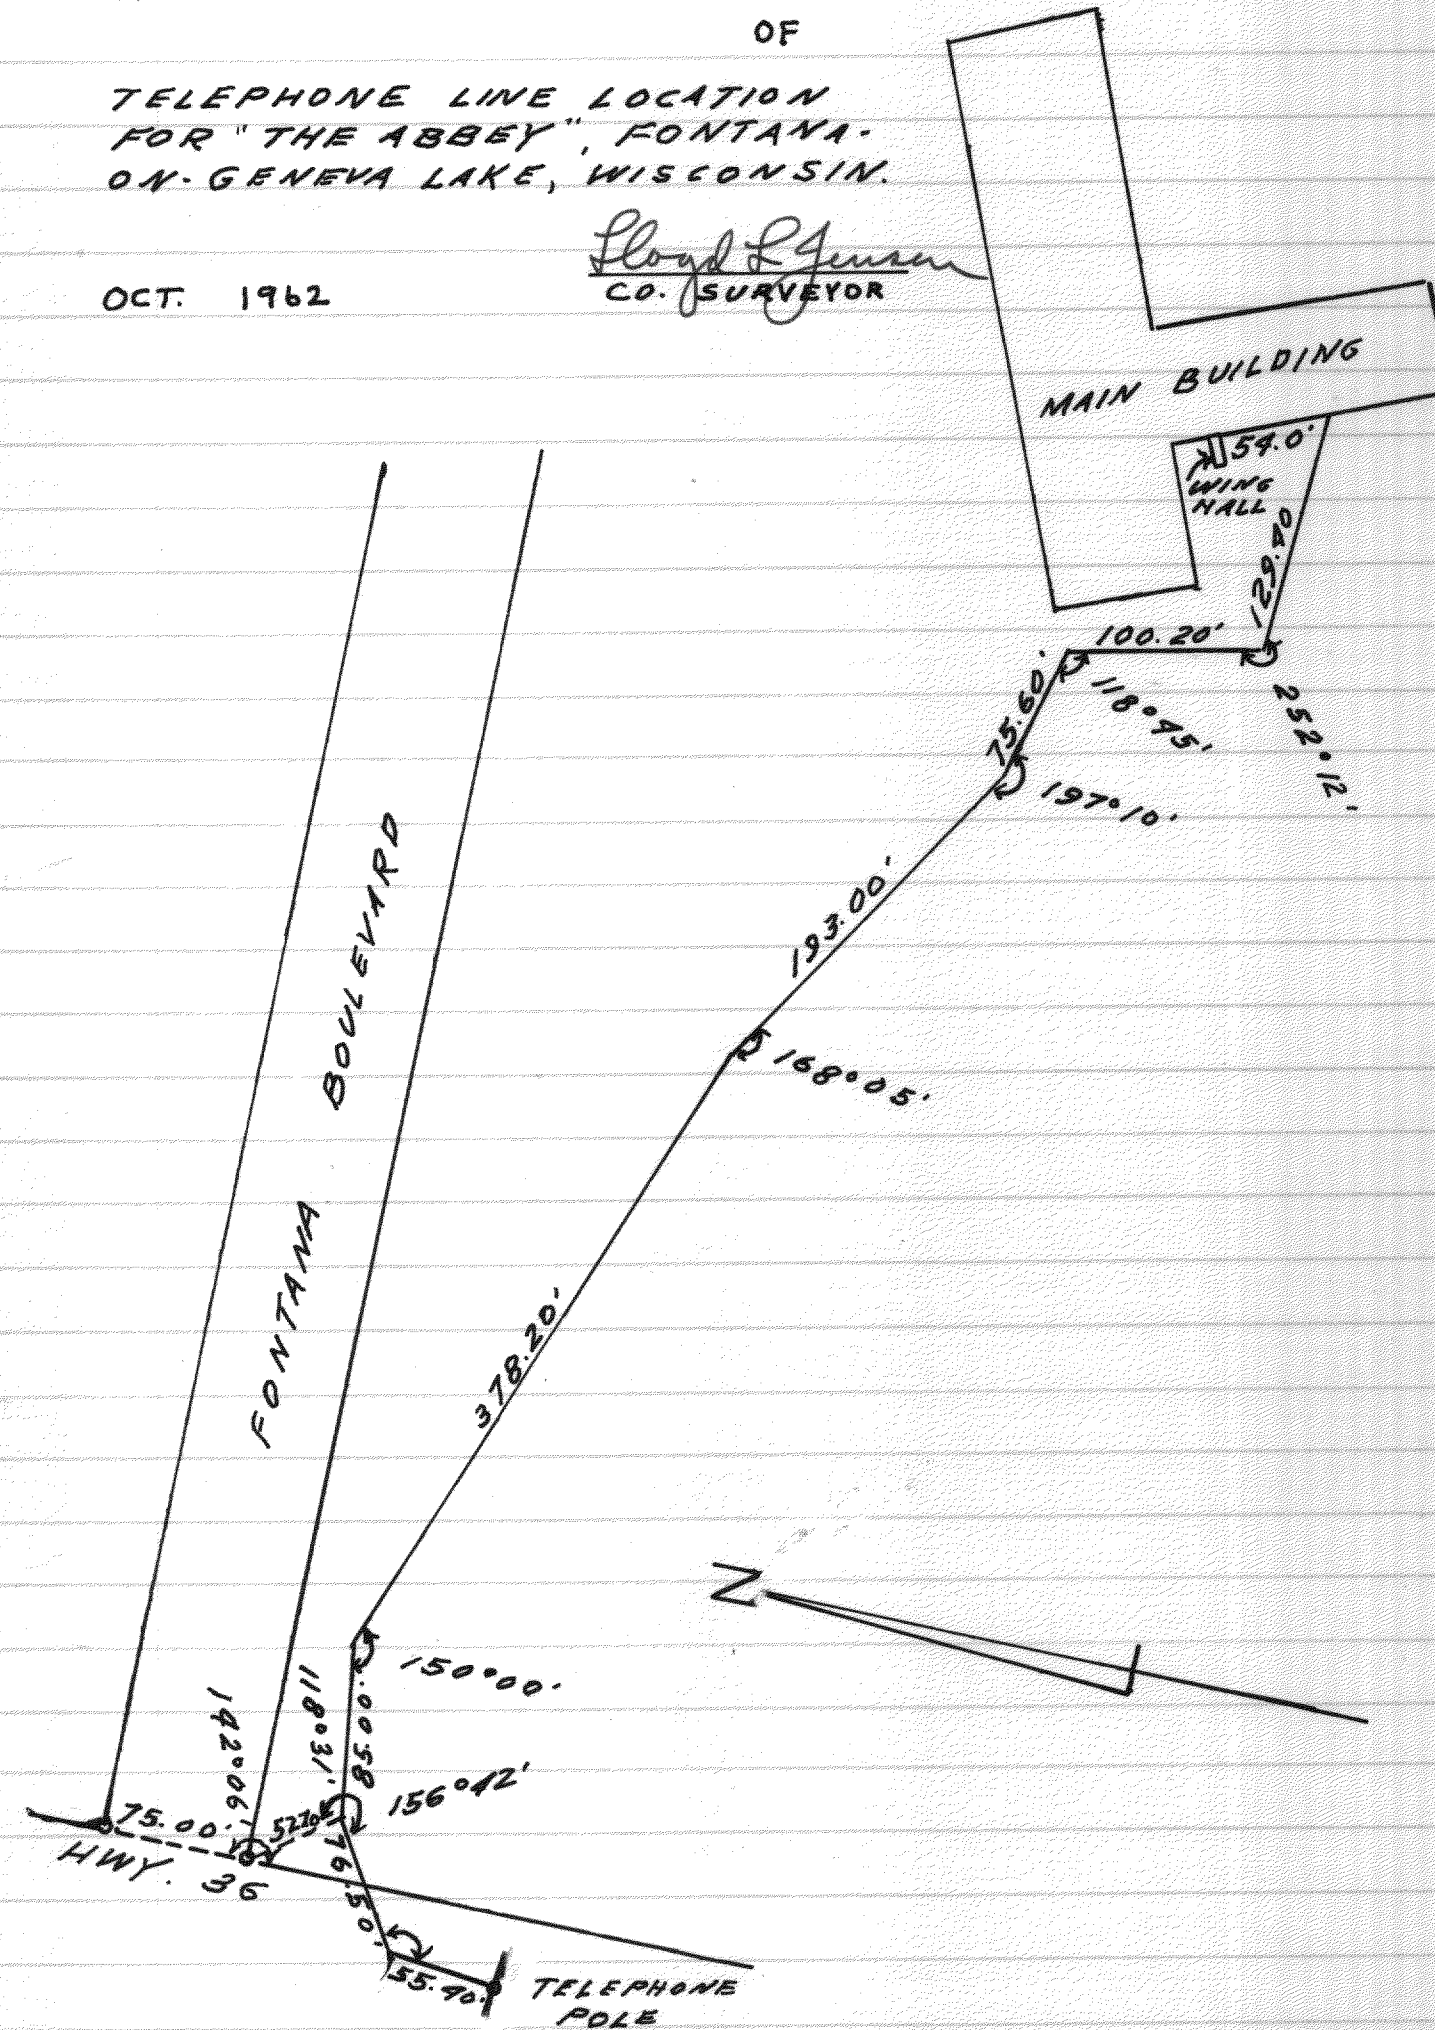

#4809

PLAT OF SURVEY

LOT 13 - LYNNDALE SUBDIVISION,
LOCATED IN THE NW 1/4 OF SECTION
20, T4N. R18E, VILLAGE OF EAST
TROY, WALWORTH COUNTY, WISCONSIN.

MAY 1965

Floyd L. Jensen
CO. SURVEYOR

