


PLAT OF SURVEY OF
THE REEK SCHOOL IN THE
NW 1/4 SECTION 16, T1N R1E
WALWORTH COUNTY, WIS.
#4828 MAY 1966
Lloyd L. Jensen
COUNTY SURVEYOR

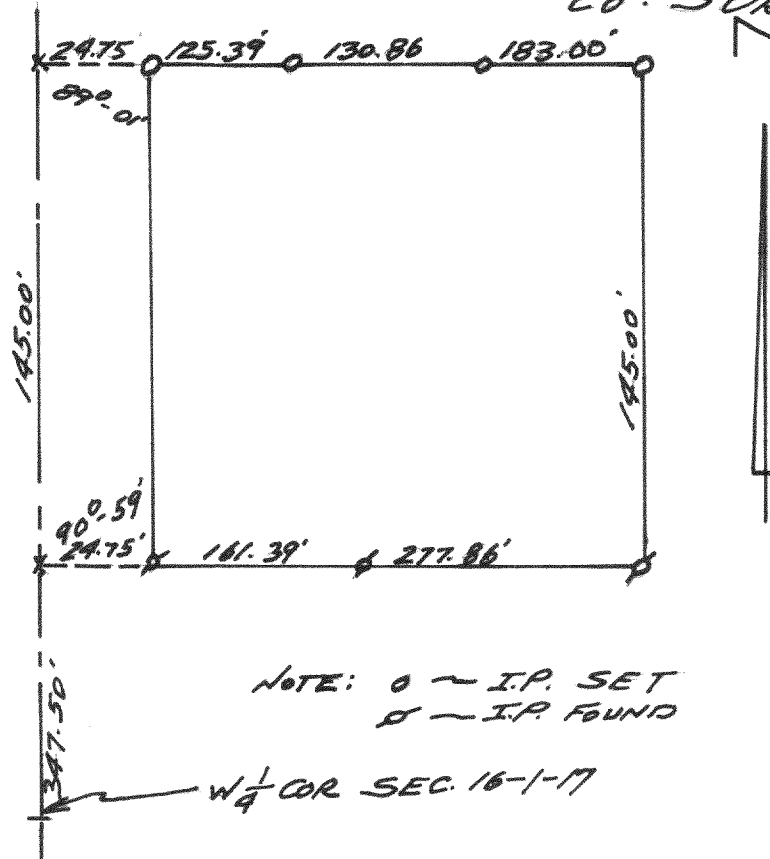

PLAT OF SURVEY
OF
LOTS 3 & 4 BLOCK 18, ORIGINAL PLAT, CITY OF
ELKHORN, WALWORTH COUNTY, WISCONSIN
#4829
FEB. 1968
Lloyd L. Jensen
COUNTY SURVEYOR

