




#4854
 PLAT OF SURVEY
 OF
 LOTS 8 SUNSET HILLS SHORES
 LOCATED IN GOV. LOT 3, W $\frac{1}{2}$ SEC 4
 T2N R17E WAL. CO. WIS.
 July 20, 1966

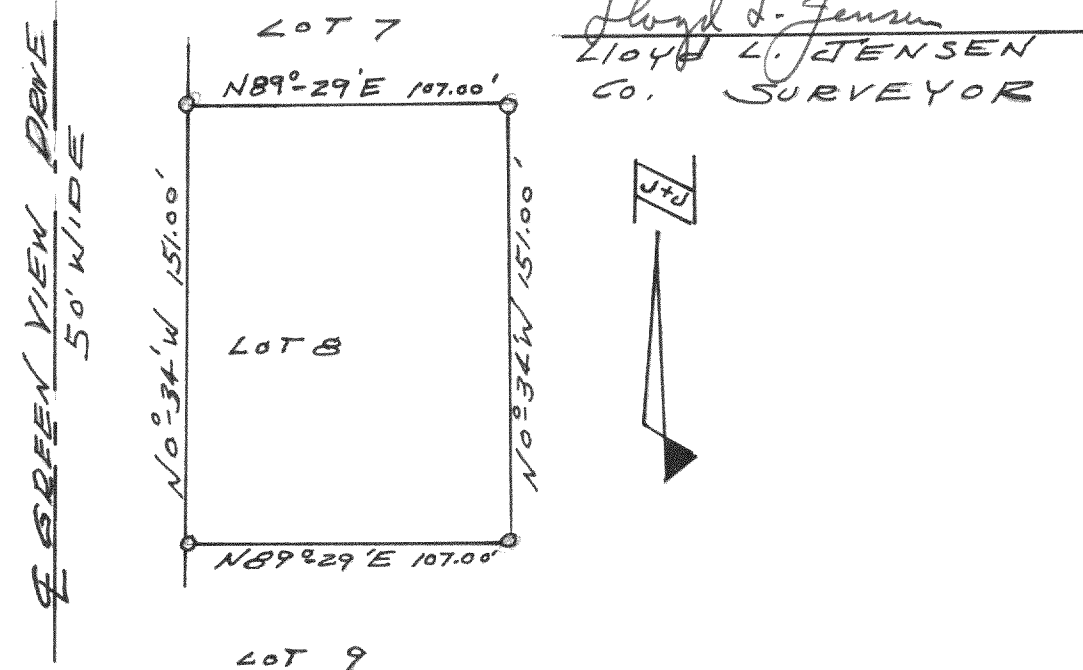

PLAT OF SURVEY
 OF
 LOTS 3562 & 3563 BLK 62
 LAKE COMO BEACH SUBD.
 T2N R17E WAL. CO. WIS.
 MAY 1967

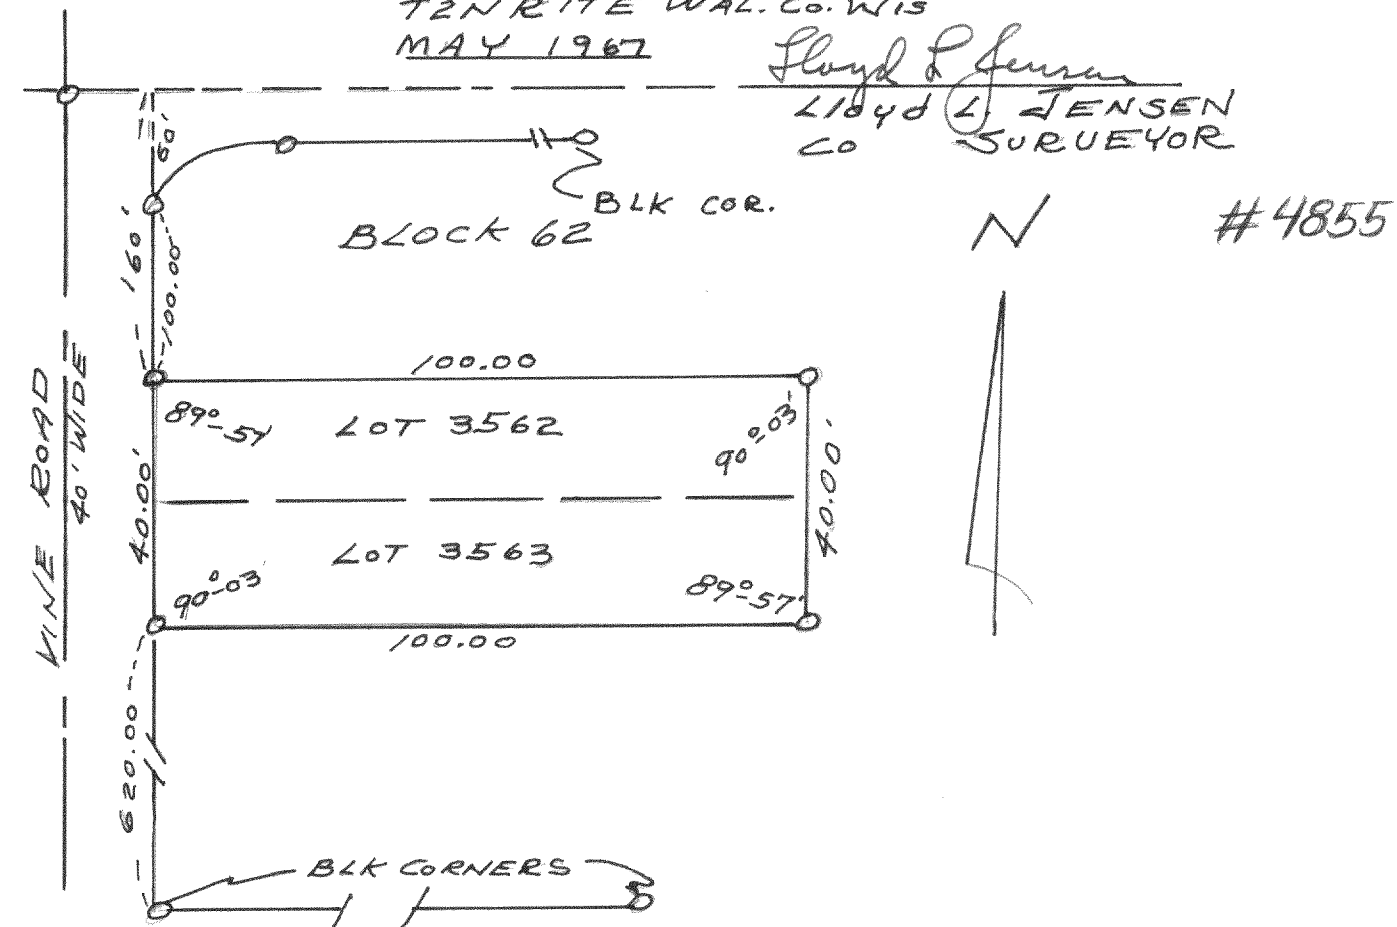


#4856

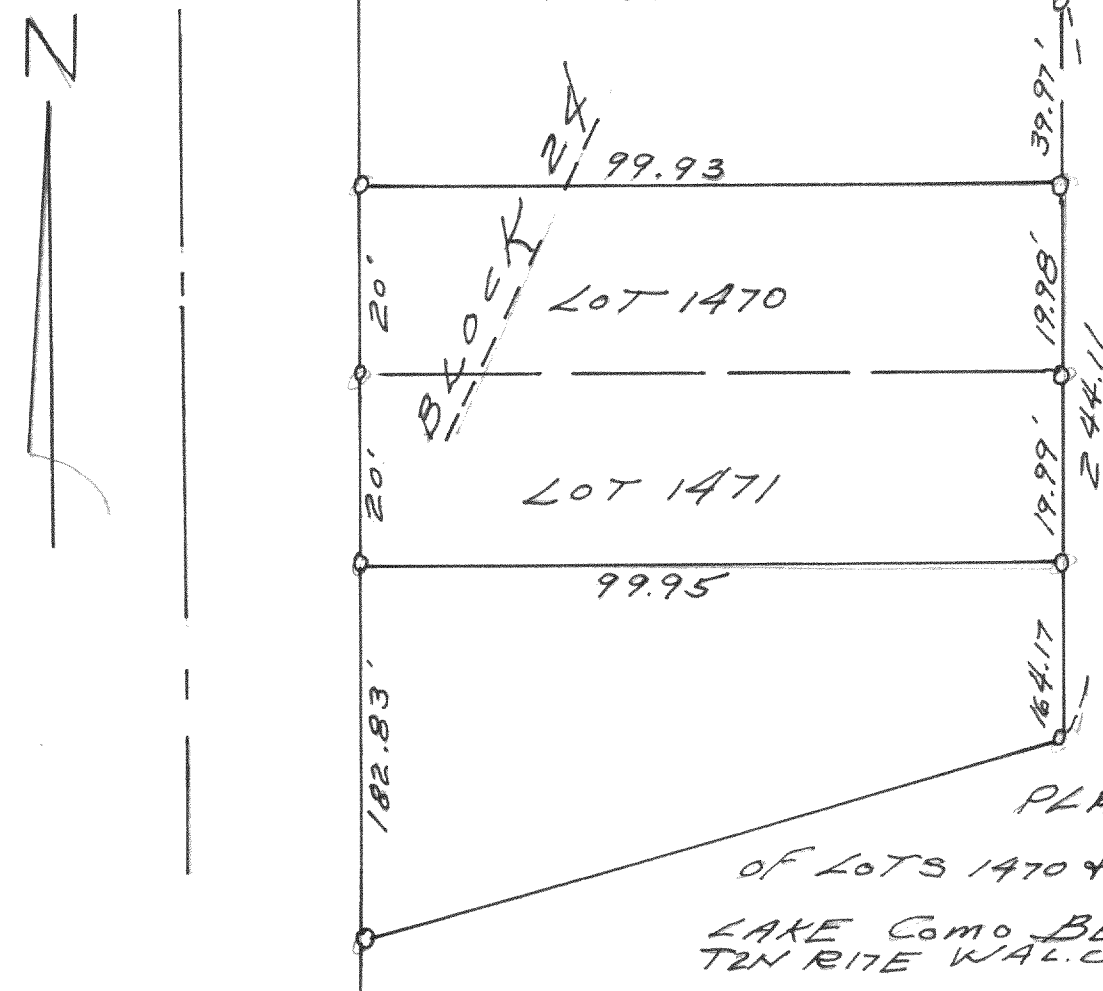

PLAT OF SURVEY
 OF LOTS 1470 & 1471 BLOCK 24
 LAKE COMO BEACH SUBD.
 T2N R17E WAL. CO. WIS.
 APRIL 1967

Lloyd L. Jensen
 LLOYD L. JENSEN
 COUNTY SURVEYOR

#4857

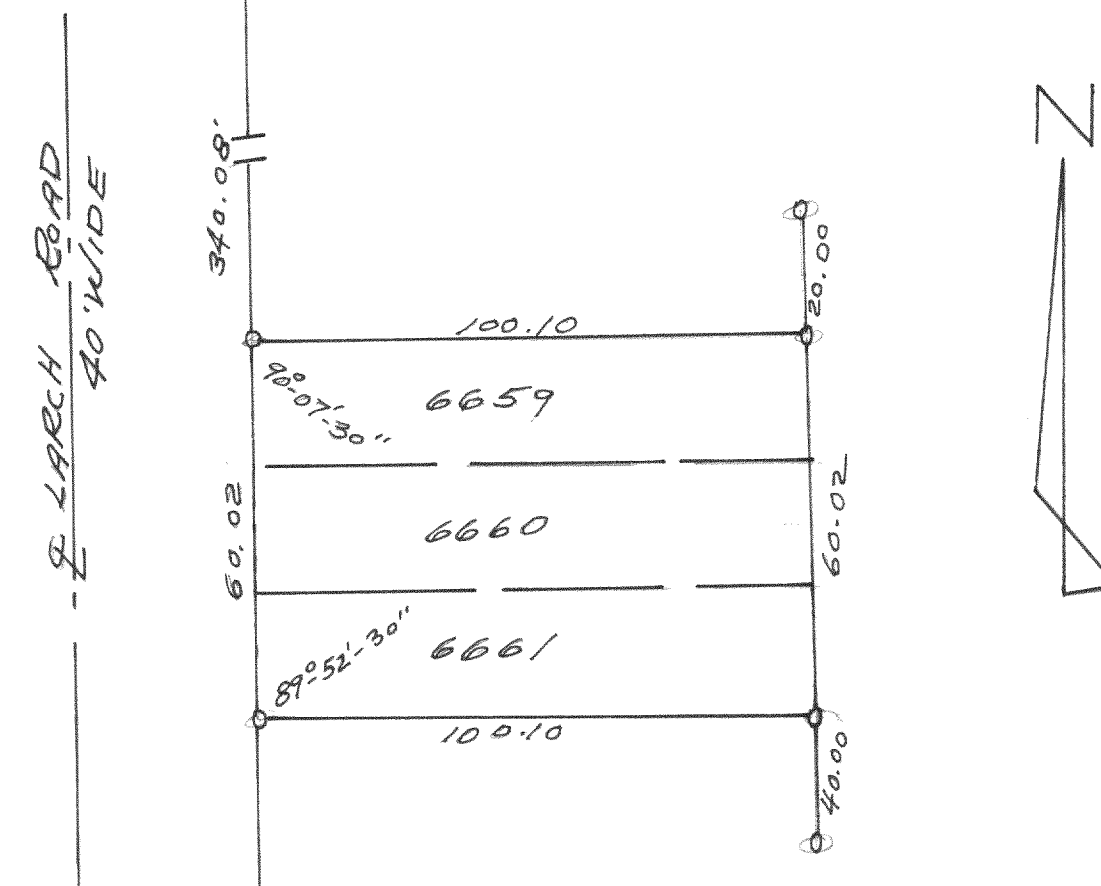

PLAT OF SURVEY
 OF
 LOTS 6659-6661 BLK 114
 LAKE COMO BEACH SUBD. T2N R17E
 WAL. CO. WIS.
 JULY 5, 1966

Lloyd L. Jensen
 LLOYD L. JENSEN
 CO. SURVEYOR