

#4858

SURVEY OF Lot 6 BLK 4
FREEMANS 2ND ADD.
GENOA CITY, WAL CO. WIS.

OCT. 1963

Floyd L. Jensen
LLOYD L. JENSEN
CO. SURVEYOR




ON IAPES SET
I.P. FOUND

#4859

PLAT OF SURVEY OF THE N. 114.66' OF THE WEST
50.00' OF LOT 2 BLK 10 ORIGINAL PLAT, CITY OF
LAKE GENEVA - NW 1/4 SEC. 36, T2N-R17E WAL CO. WIS.
DEC 2, 1967

DODGE STREET

Floyd L. Jensen
LLOYD L. JENSEN
COUNTY SURVEYOR

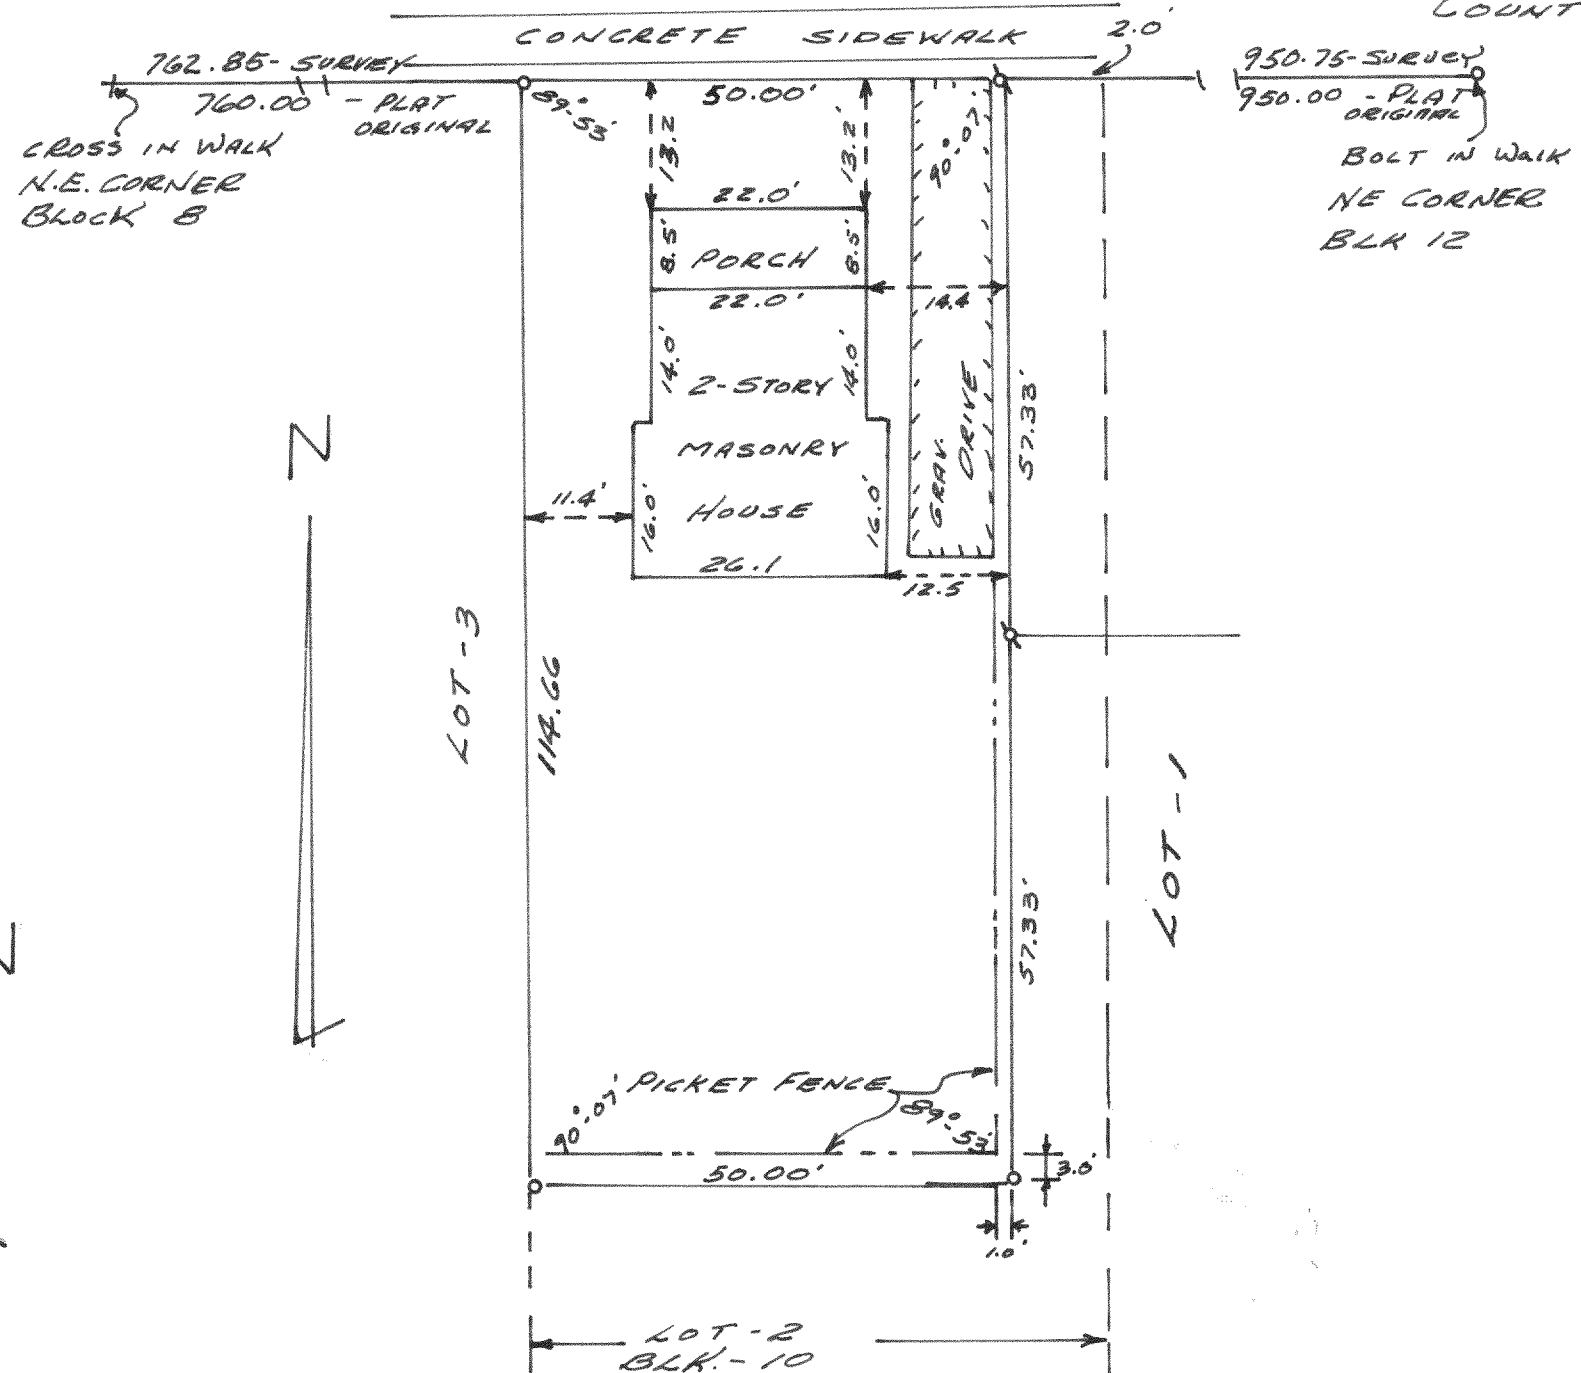

#4860

PLAT OF SURVEY
OF
LOT 12 OF JEWELL'S SUBD.
LOCATED IN THE SE 1/4 SEC. 1,
T19R16 WILLIAMS BAY, WIS.

OCT. 7, 1966

Floyd L. Jensen
LLOYD L. JENSEN
COUNTY SURVEYOR

