


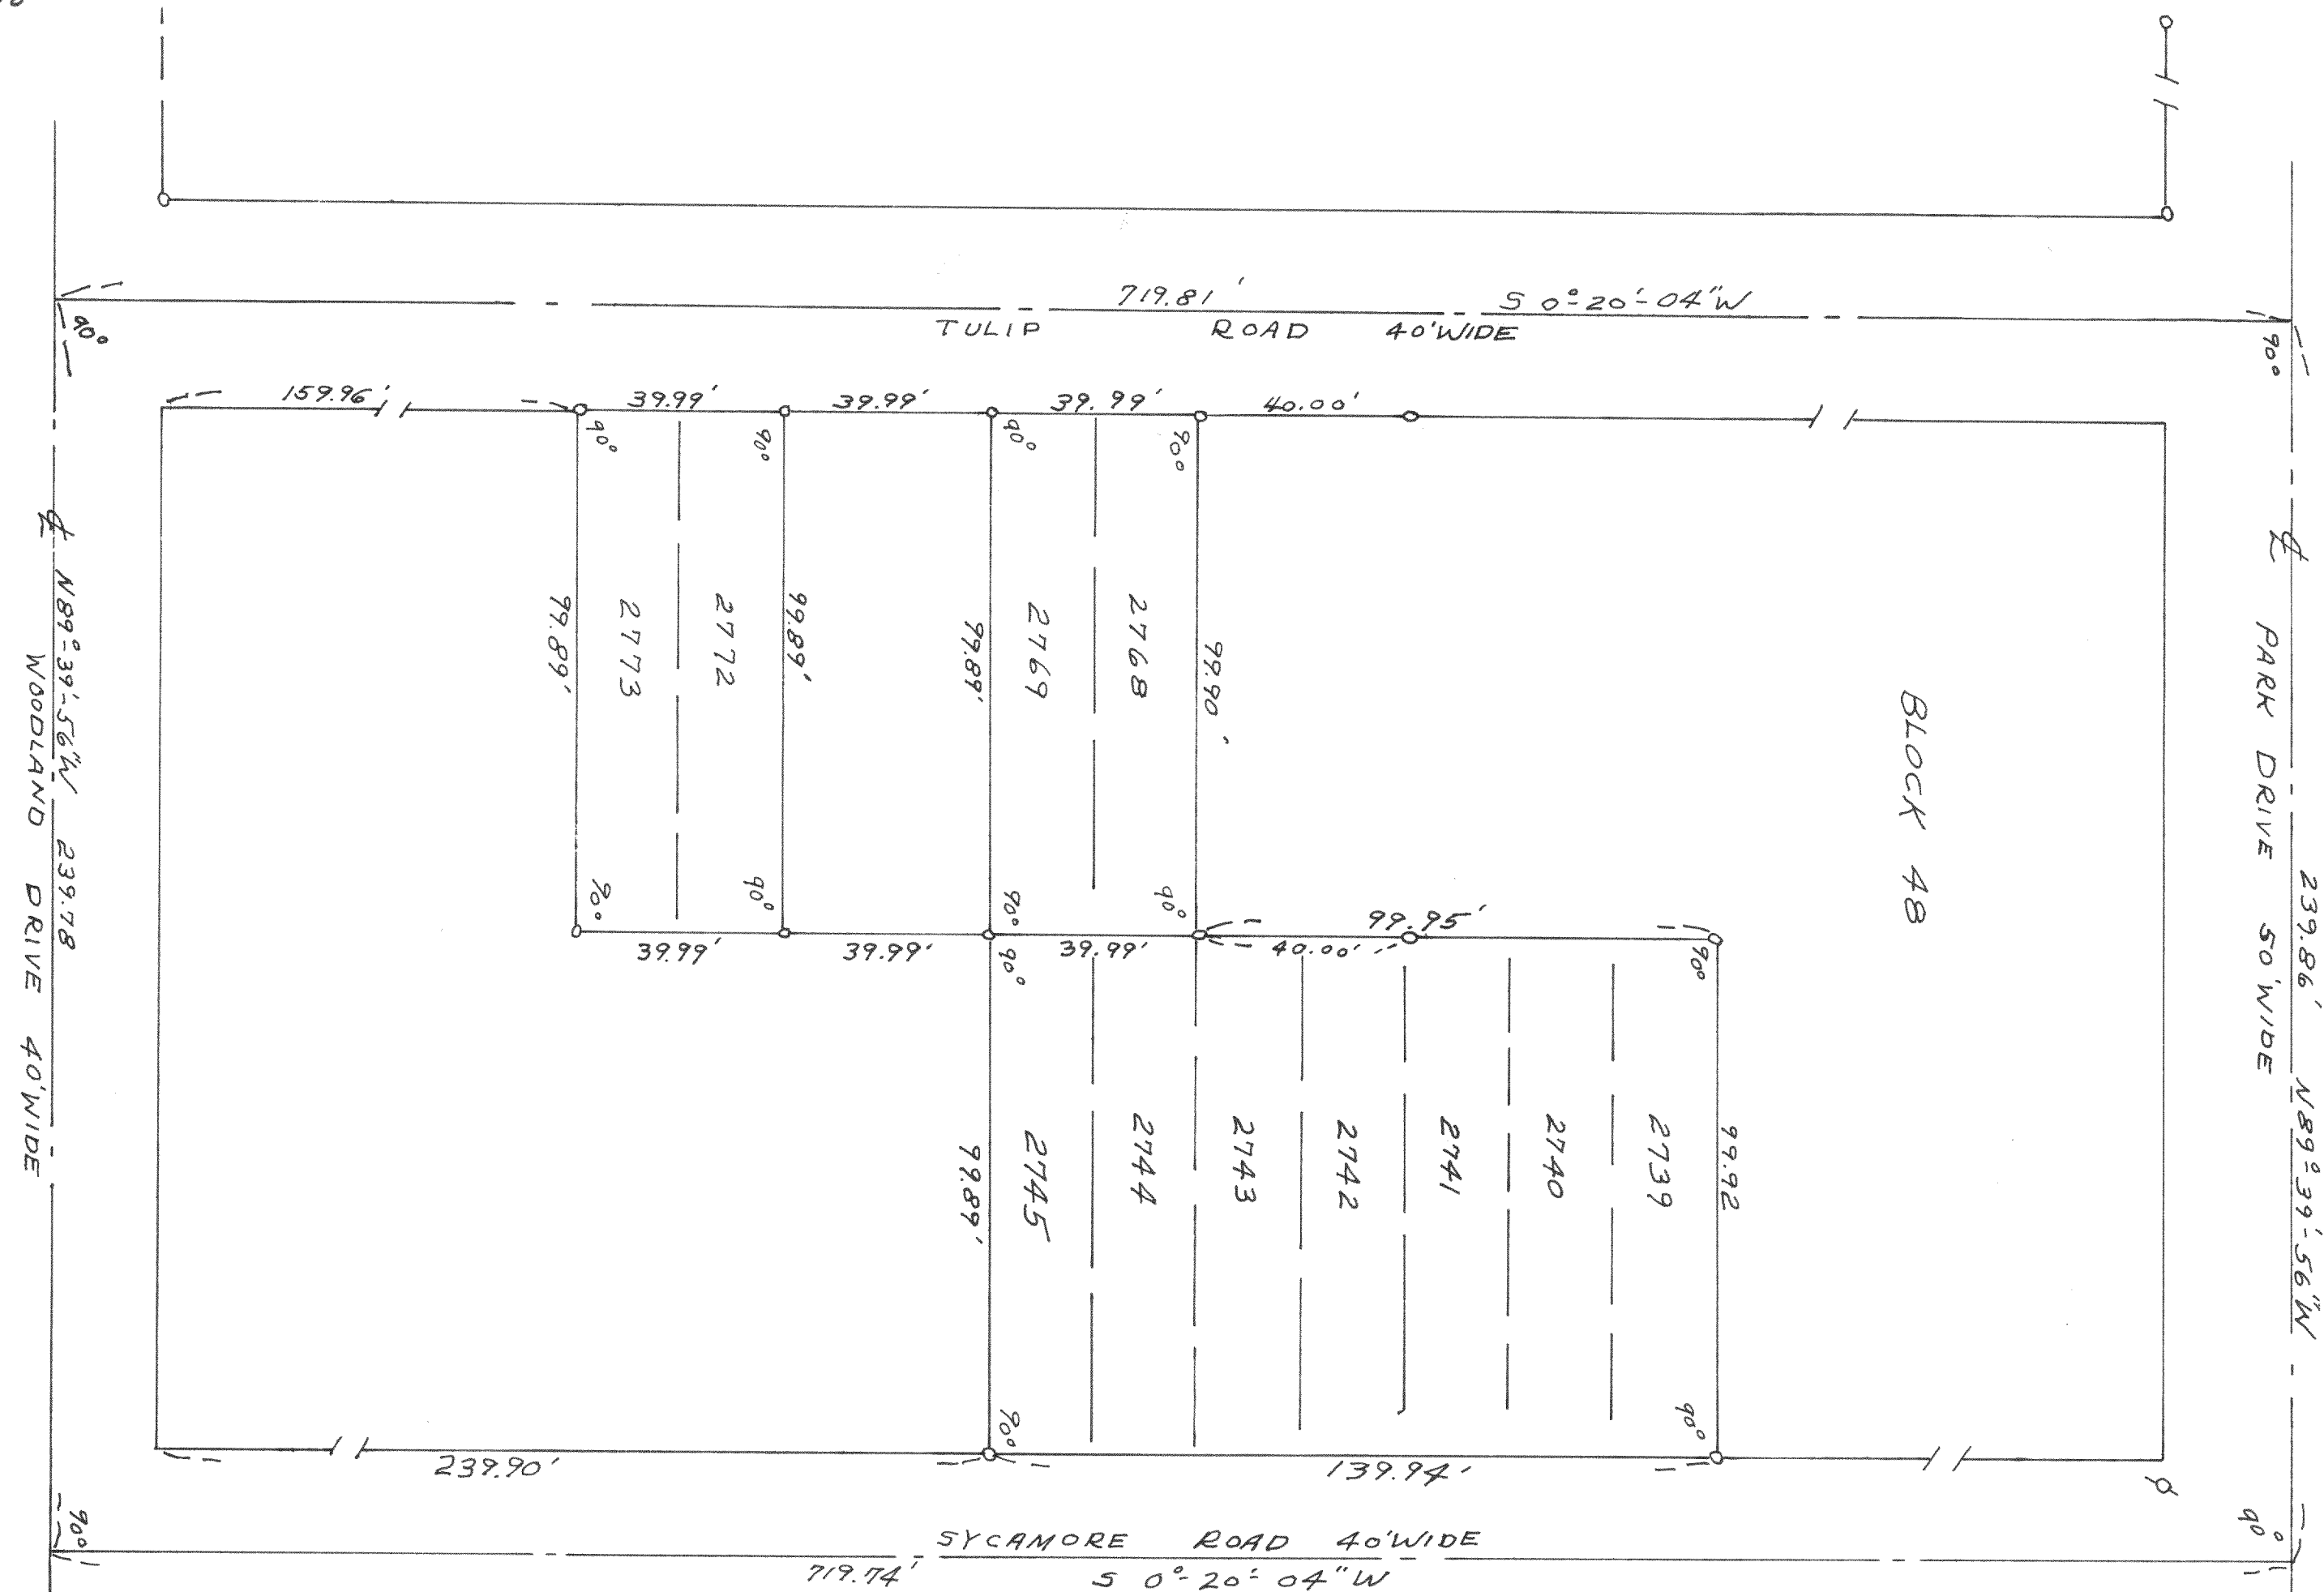

PLAT OF SURVEY OF

#4868

LOTS 2739, 2740, 2741, 2742, 2743, 2744,
2745, 2768, 2769, 2772, 2773, BLOCK 48
LAKE COMO SUBD, LOCATED IN T2N R17E
WALWORTH COUNTY WISCONSIN.

MAY 1967

Lloyd Jensen
COUNTY SURVEYOR

