




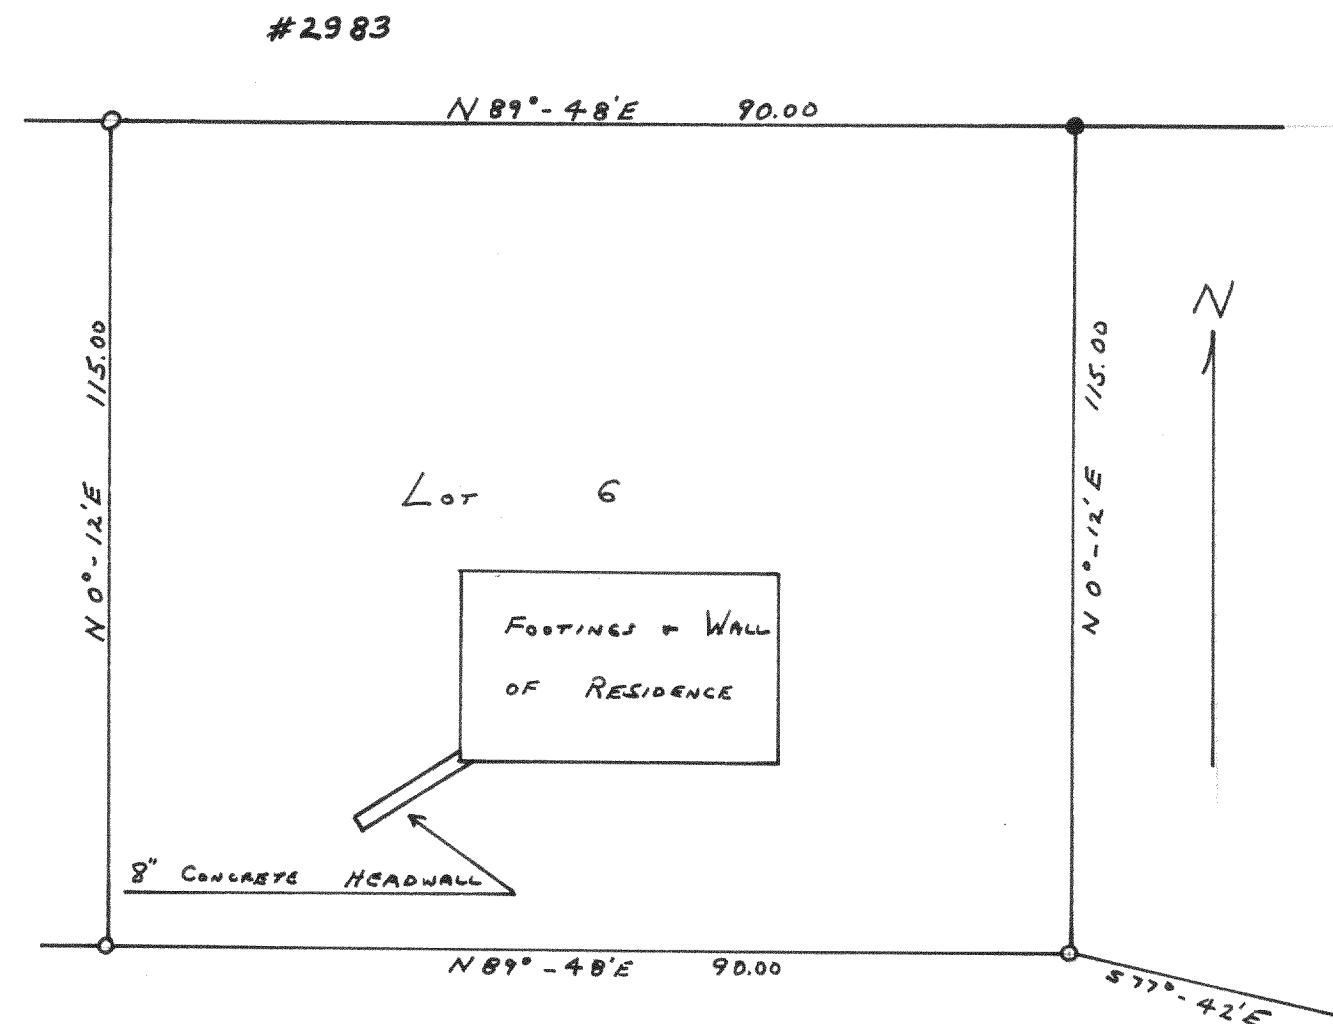

PLAT OF SURVEY OF LOT 6 OF ADDITION D TO
COUNTRY CLUB ESTATES LOCATED IN THE VILLAGE
OF FONTANA-ON-GENEVA LAKE WALWORTH COUNTY, WISCONSIN
NOVEMBER 1954
LLOYD L. JENSEN
SA.
COUNTY SURVEYOR

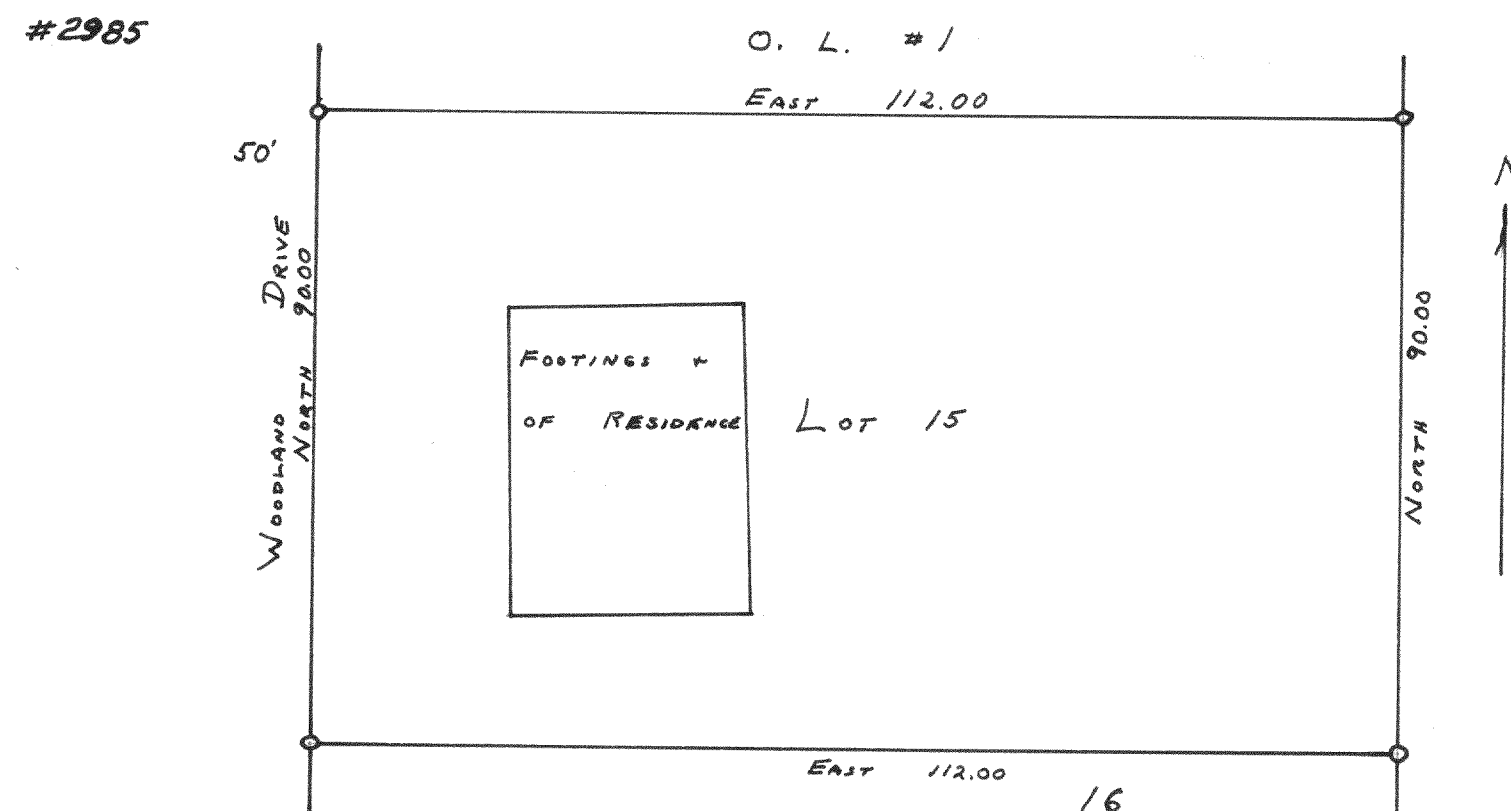

PLAT OF SURVEY OF LOT 15 OF ADDITION D TO
COUNTRY CLUB ESTATES LOCATED IN THE VILLAGE OF
FONTANA-ON-GENEVA LAKE WALWORTH COUNTY, WISCONSIN.
NOVEMBER 1954
LLOYD L. JENSEN
SA
COUNTY SURVEYOR

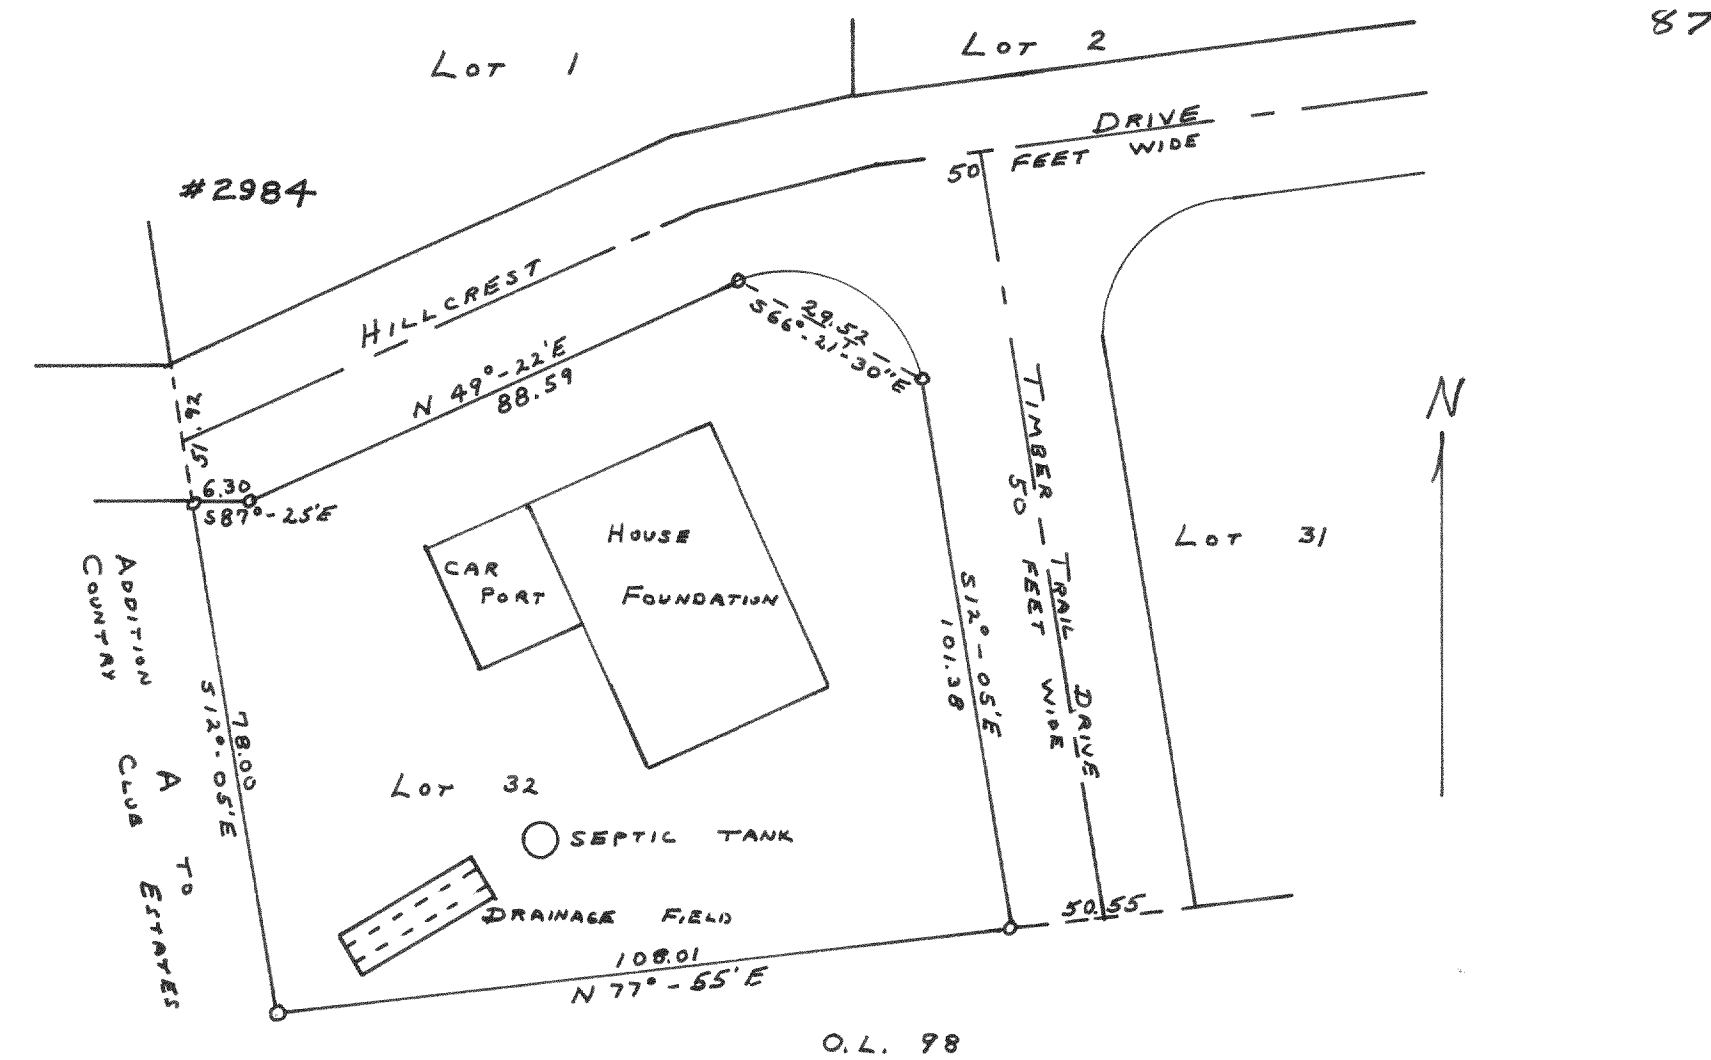

PLAT OF SURVEY OF LOT 32 OF ADDITION "D" TO COUNTRY
CLUB ESTATES LOCATED IN THE VILLAGE OF FONTANA-ON-GENEVA
LAKE WALWORTH COUNTY, WISCONSIN.
DECEMBER 1954
LLOYD L. JENSEN
SA
COUNTY SURVEYOR



PLAT OF SURVEY OF LOT 27 ADDITION D
TO COUNTRY CLUB ESTATES
VILLAGE OF FONTANA
WALWORTH COUNTY WIS
NOV 1954
Lloyd L. Jensen
County Surveyor