



#2987

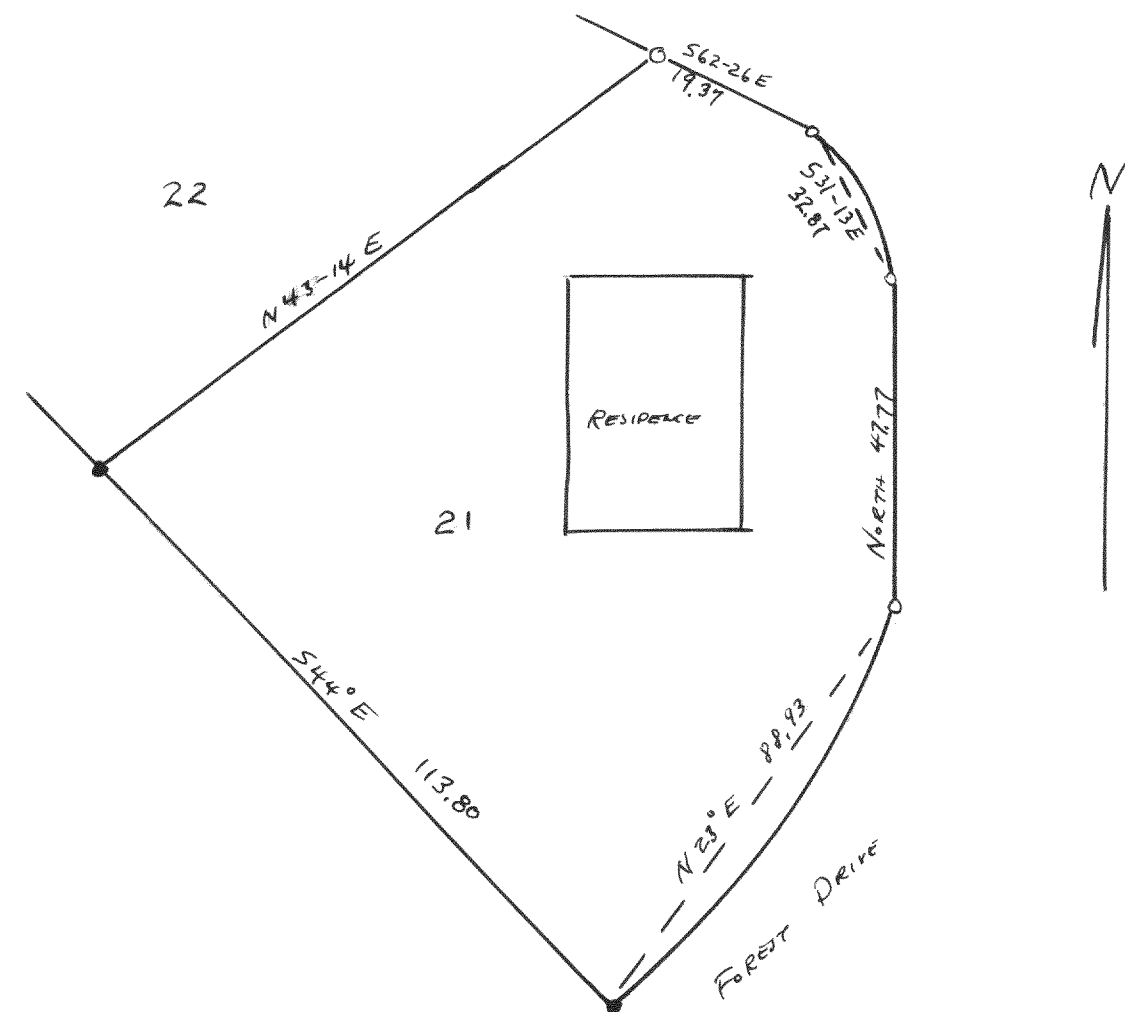

PLAT OF SURVEY OF LOT 21 ADDITION "D" TO COUNTRY CLUB ESTATES
VILLAGE OF FONTANA - ON - GENEVA LAKE
WALWORTH COUNTY, WISCONSIN
Nov 1954
Lloyd J. Jensen
County Surveyor


For Survey of Addition "E" to
Country Club Estates Part of O.K. 98
Village of Fontana, Wisconsin Located in
Sections 14 & 23, See Volume 12
pages 101 & 102 in Register of
Deeds Office, Walworth County, Wisconsin.

#2988

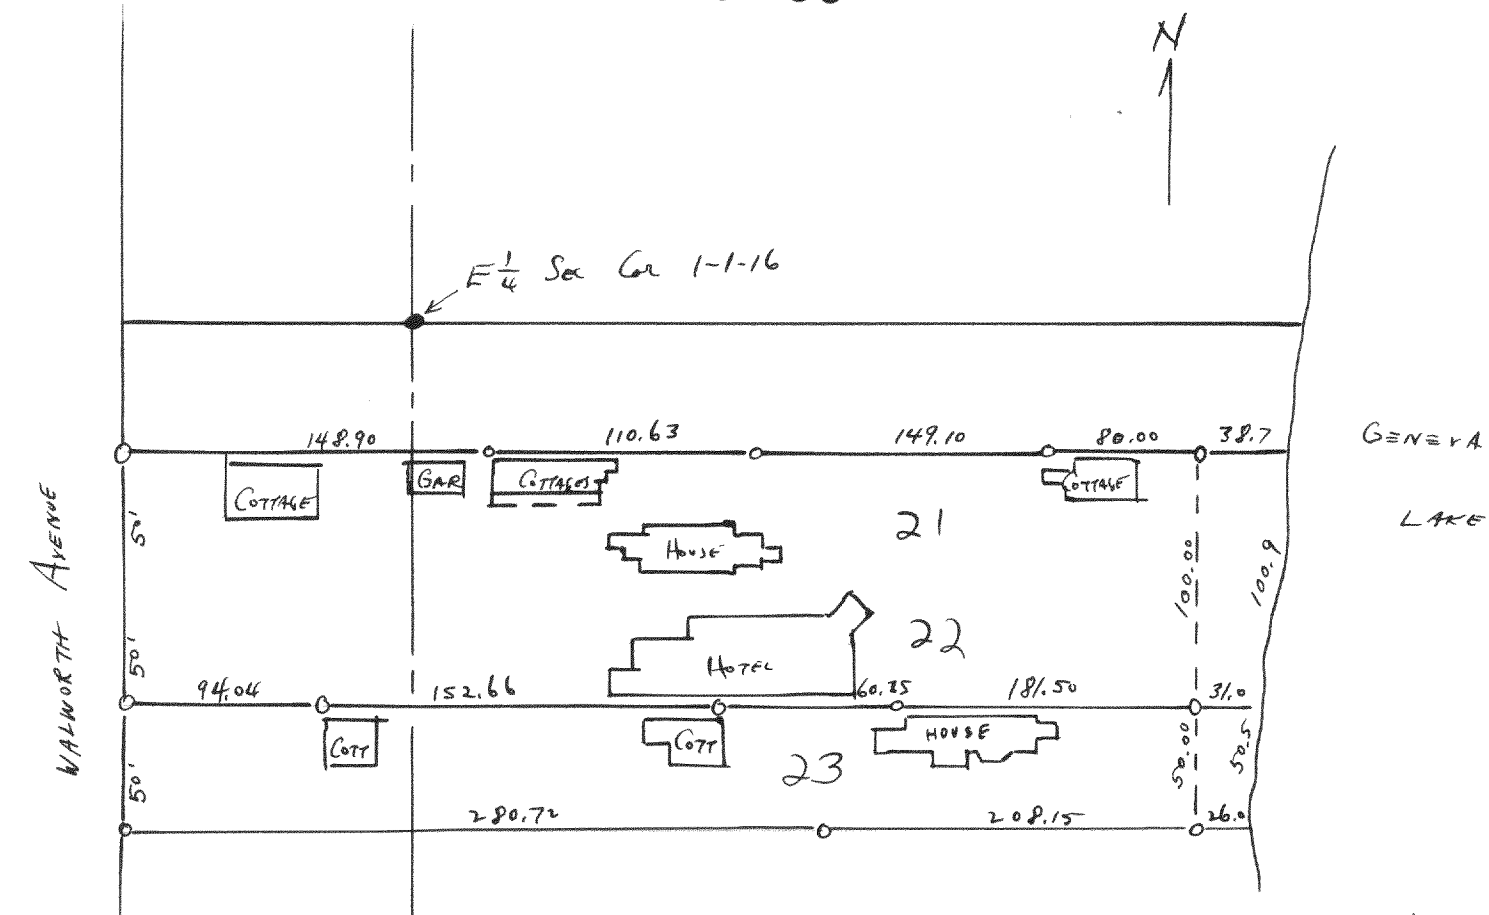

PLAT OF SURVEY OF LOTS 21-23, BLOCK 7 OF WILLIAMS THIRD ADDITION
VILLAGE OF WILLIAMS BAY, WALWORTH COUNTY, WIS
Dec 1954
Lloyd J. Jensen
County Surveyor

#2989

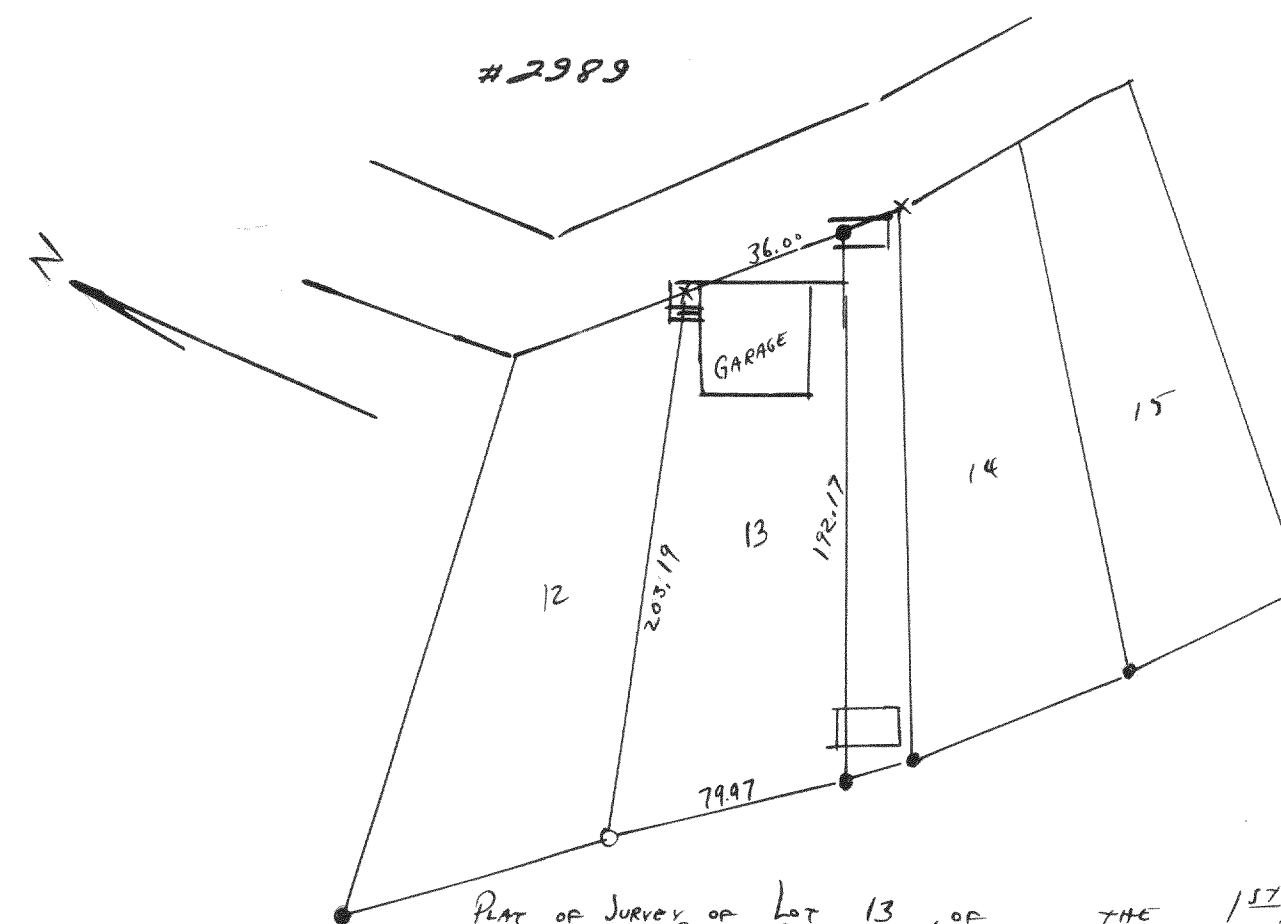

PLAT OF SURVEY OF LOT 13 OF THE 1ST ADDITION
TO CEDAR POINT PARK, VILLAGE OF WILLIAMS BAY
WALWORTH COUNTY, WIS
Oct 1954
Lloyd J. Jensen
County Surveyor