


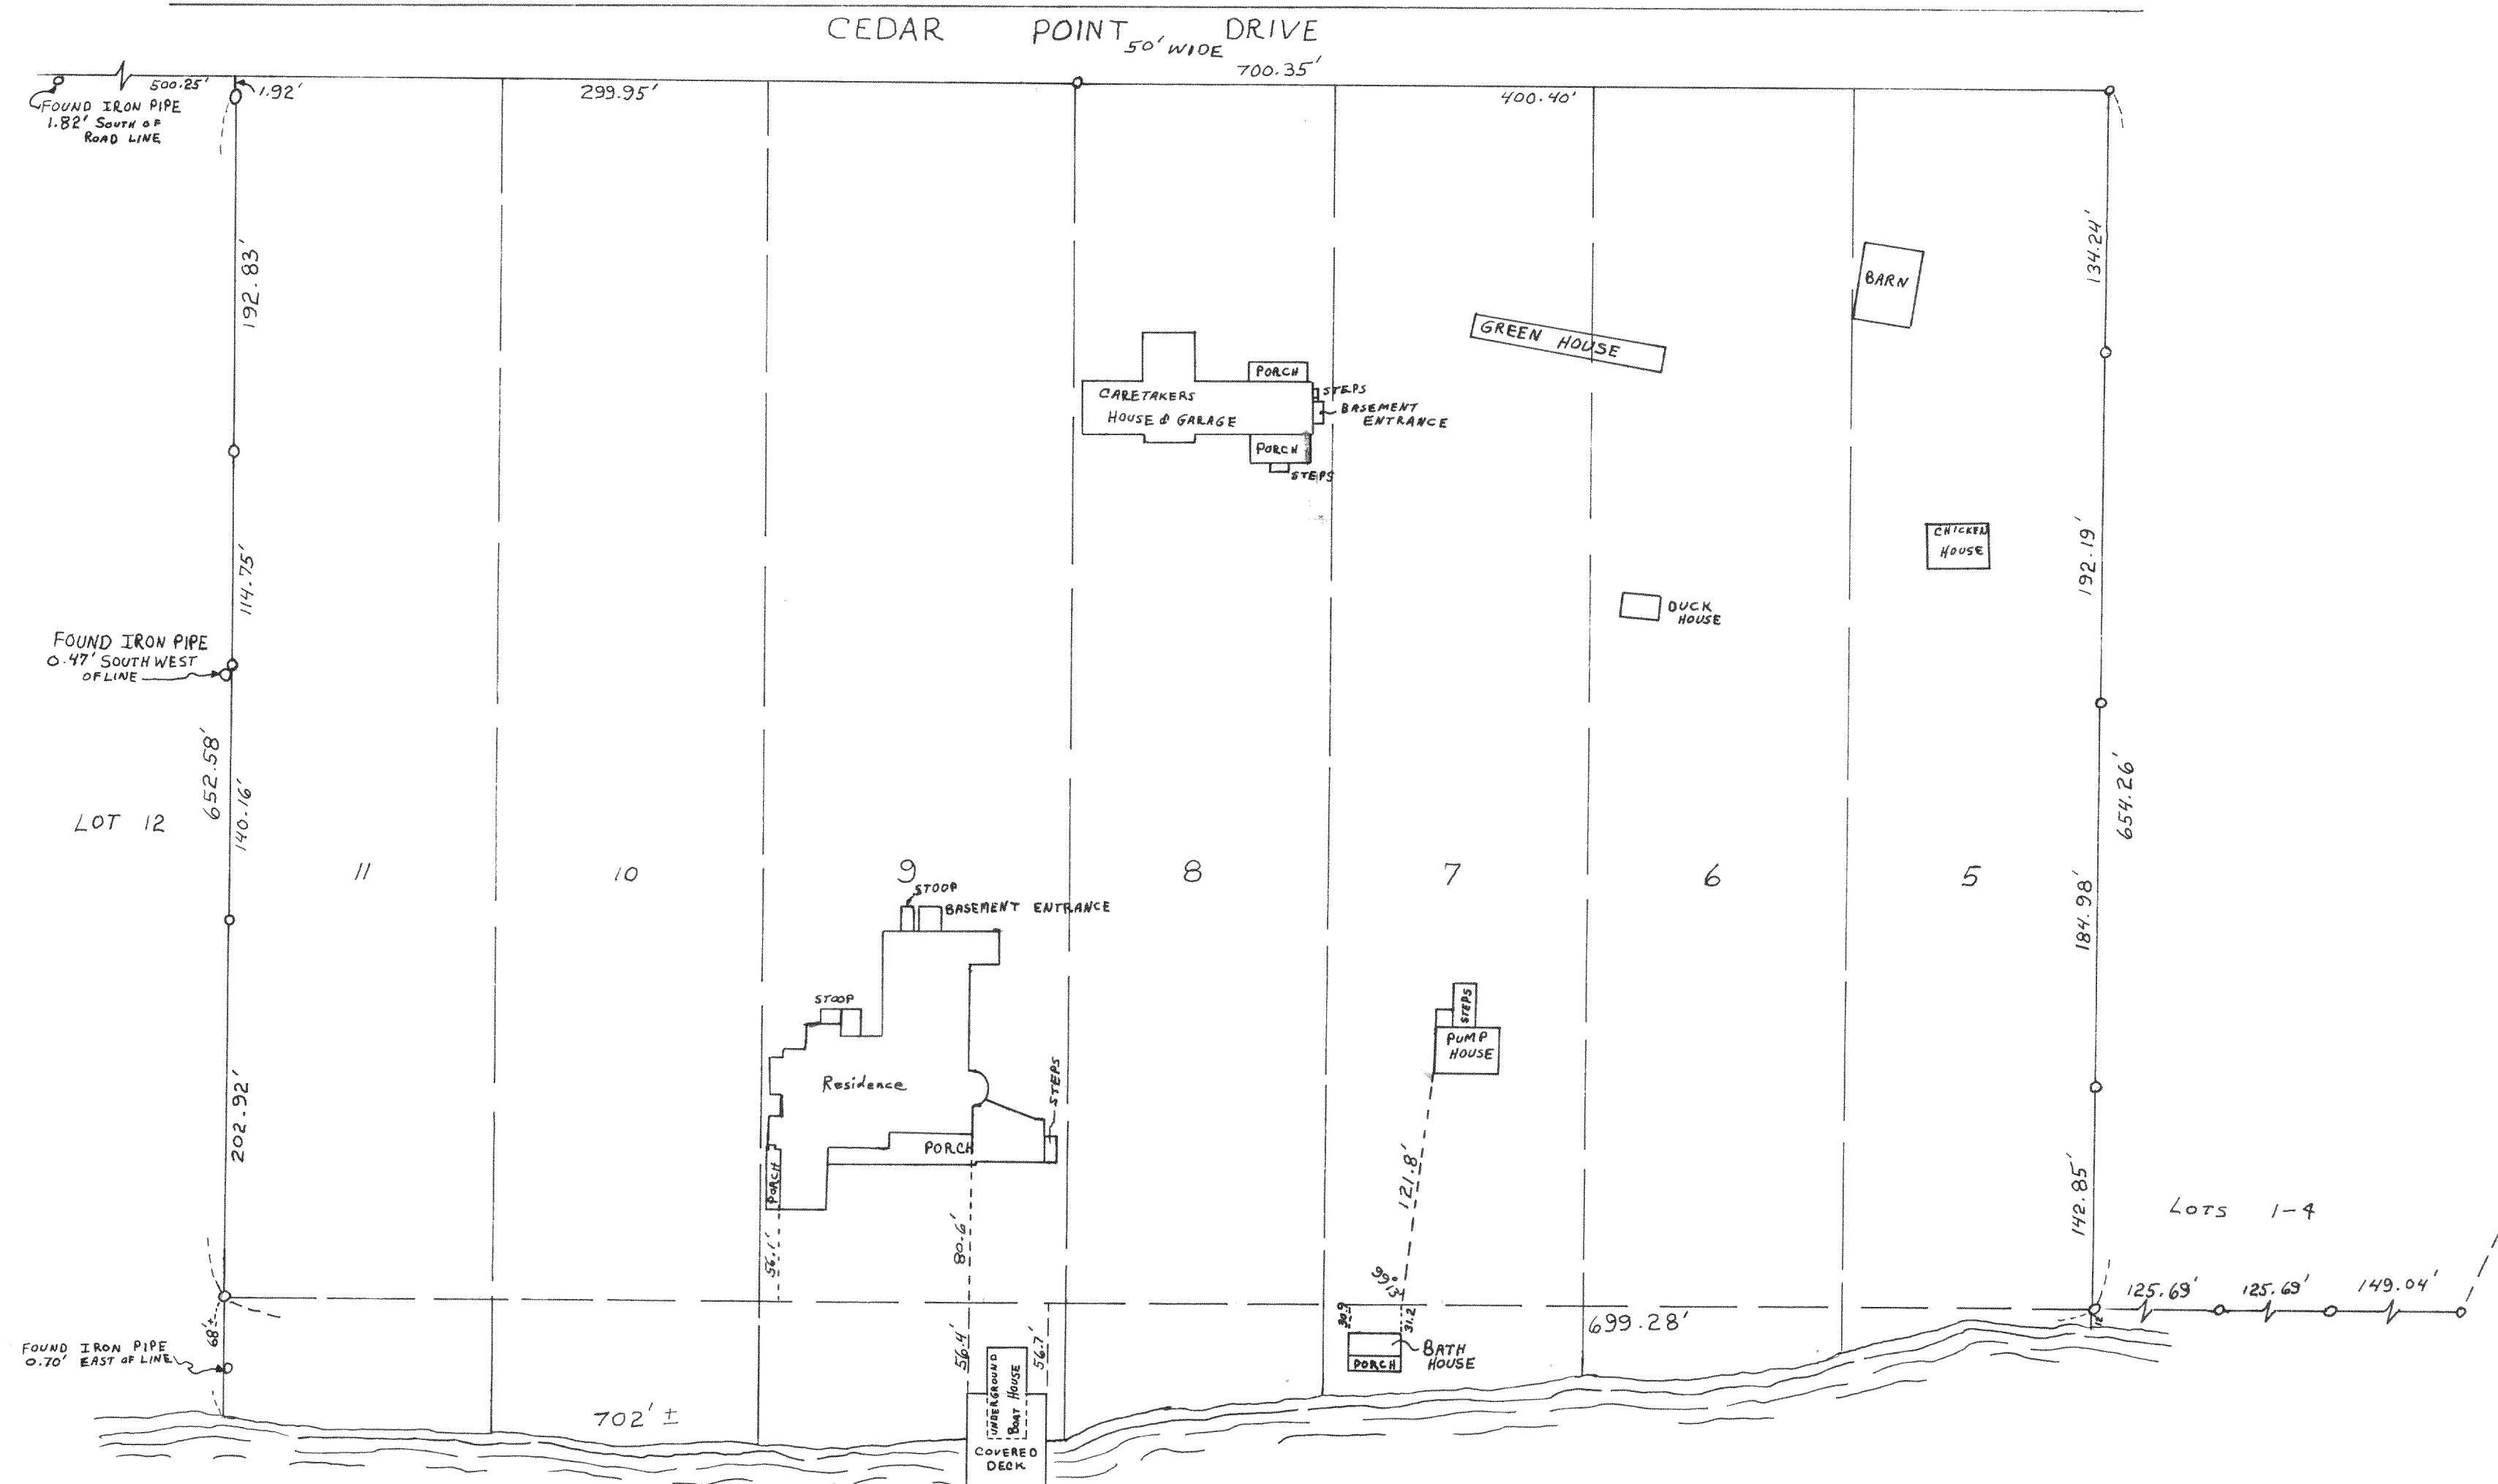

PLAT OF SURVEY #4913
OF

LOTS 5, 6, 7, 8, 9, 10 AND 11 OF CEDAR
POINT SUBDIVISION LOCATED IN THE
VILLAGE OF WILLIAMS BAY
AND TOWN 1 NORTH RANGE 17 EAST
OF WALWORTH COUNTY WISCONSIN

SEPT 1967

Lloyd Jensen
COUNTY SURVEYOR