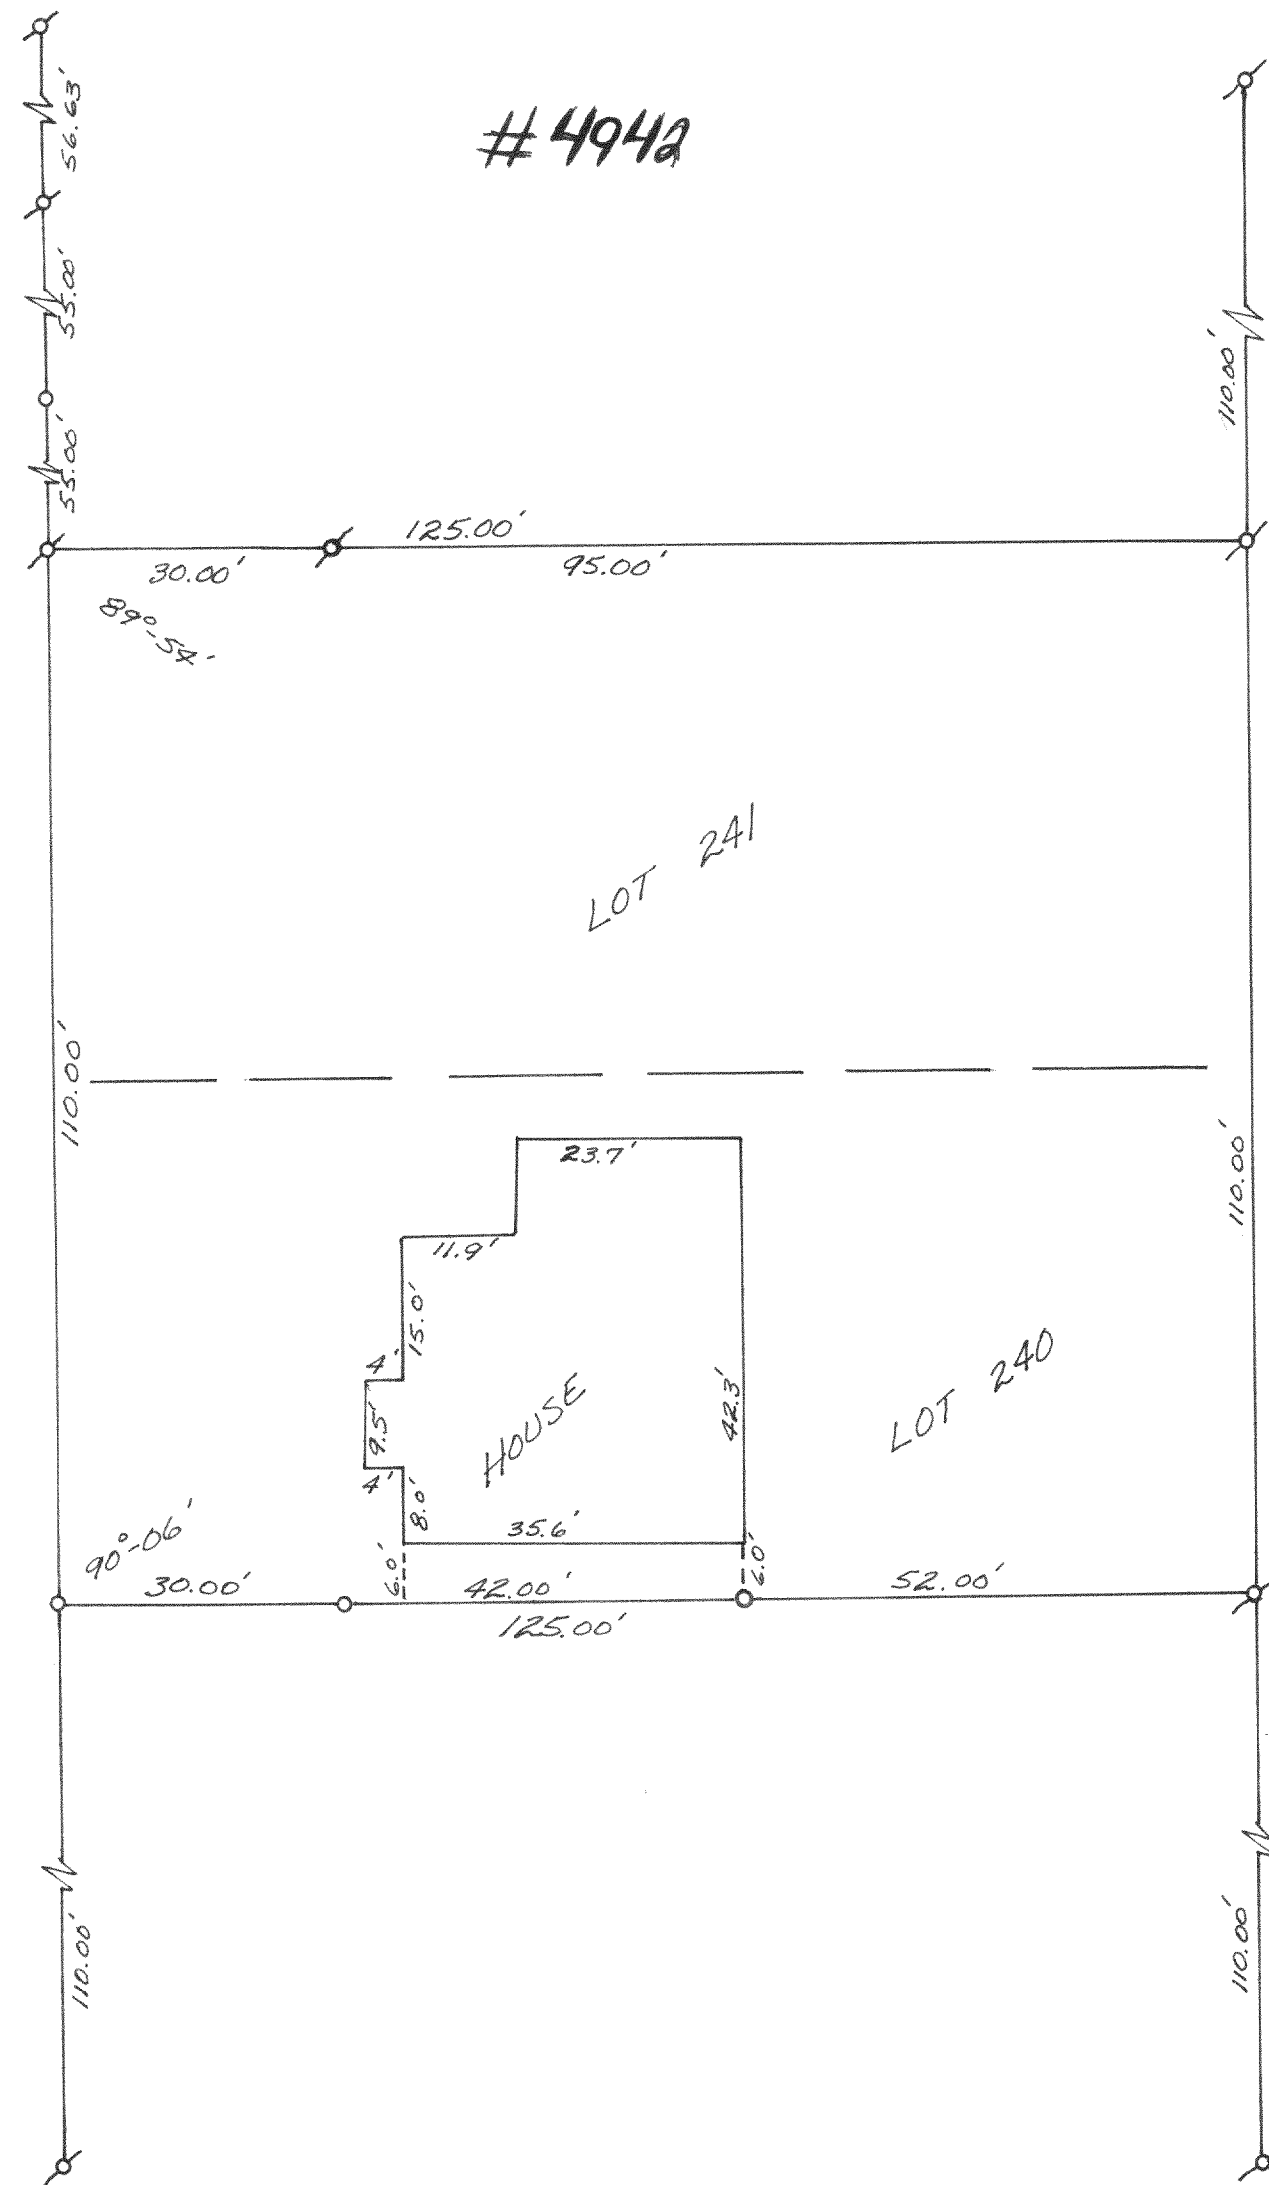


#4942

CIRCLE PARKWAY
40' WIDEPLAT OF SURVEY
OF

LOTS 241 & 240 OF CEDAR POINT PARK
3RD ADDITION, LOCATED IN WILLIAMS
BAY, WALWORTH COUNTY, WISCONSIN.

JULY 1970

Lloyd L Jensen
SURVEYOR

- ⊗ — IRON PIPE FOUND
○ — IRON PIPE SET