


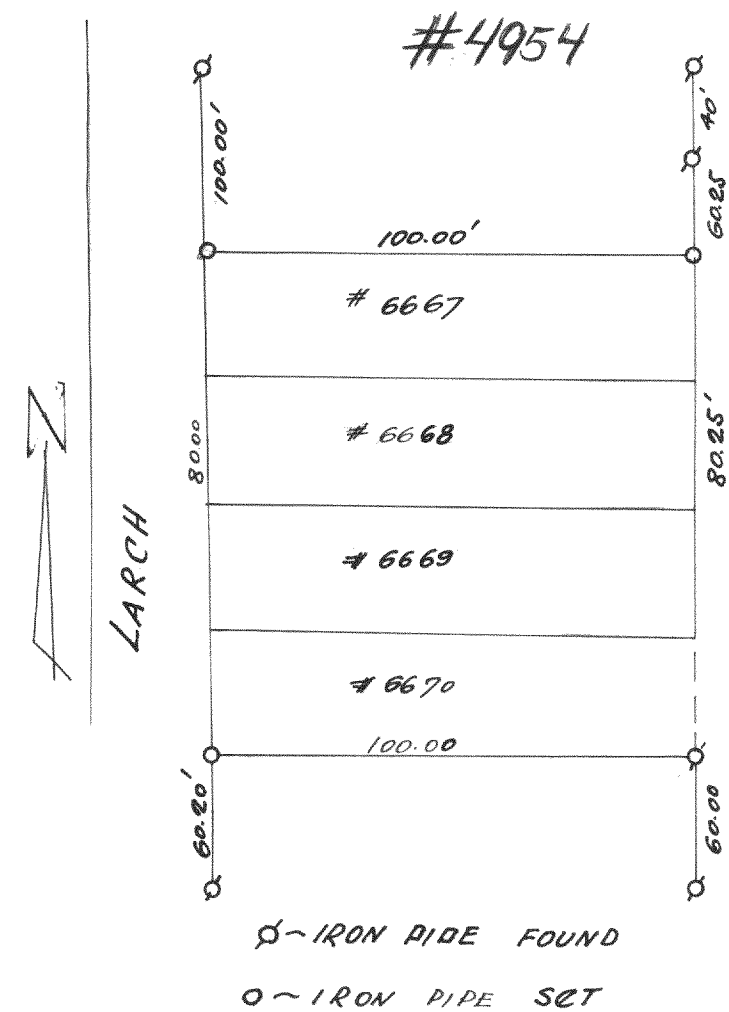

PLAT OF SURVEY OF
LOTS 6667 TO 6670 LAKE
COMO BEACH SUBD.
T2N R1E, WAL. CO. WIS.
JULY 1969

Lloyd L. Jensen
Co. SURVEYOR

