


2618

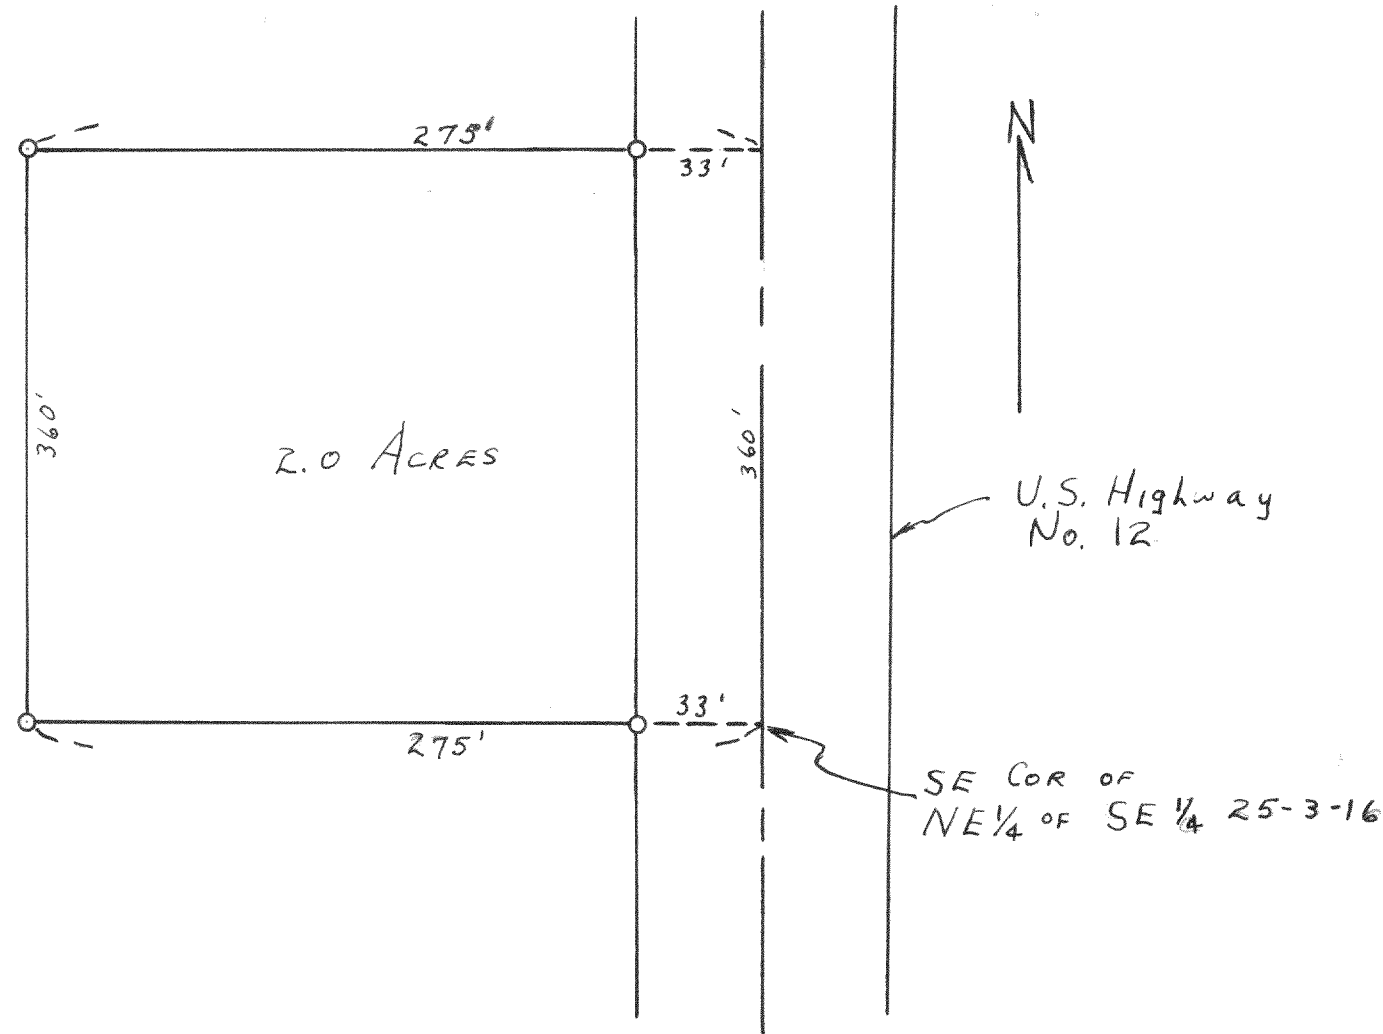


PLAT OF SURVEY OF A PARCEL OF
 LAND LOCATED IN THE NE 1/4
 OF THE SE 1/4 OF SECTION 25,
 T3N R16E

Nov. 24, 1952

Lloyd L. Jensen
 County Surveyor

2619

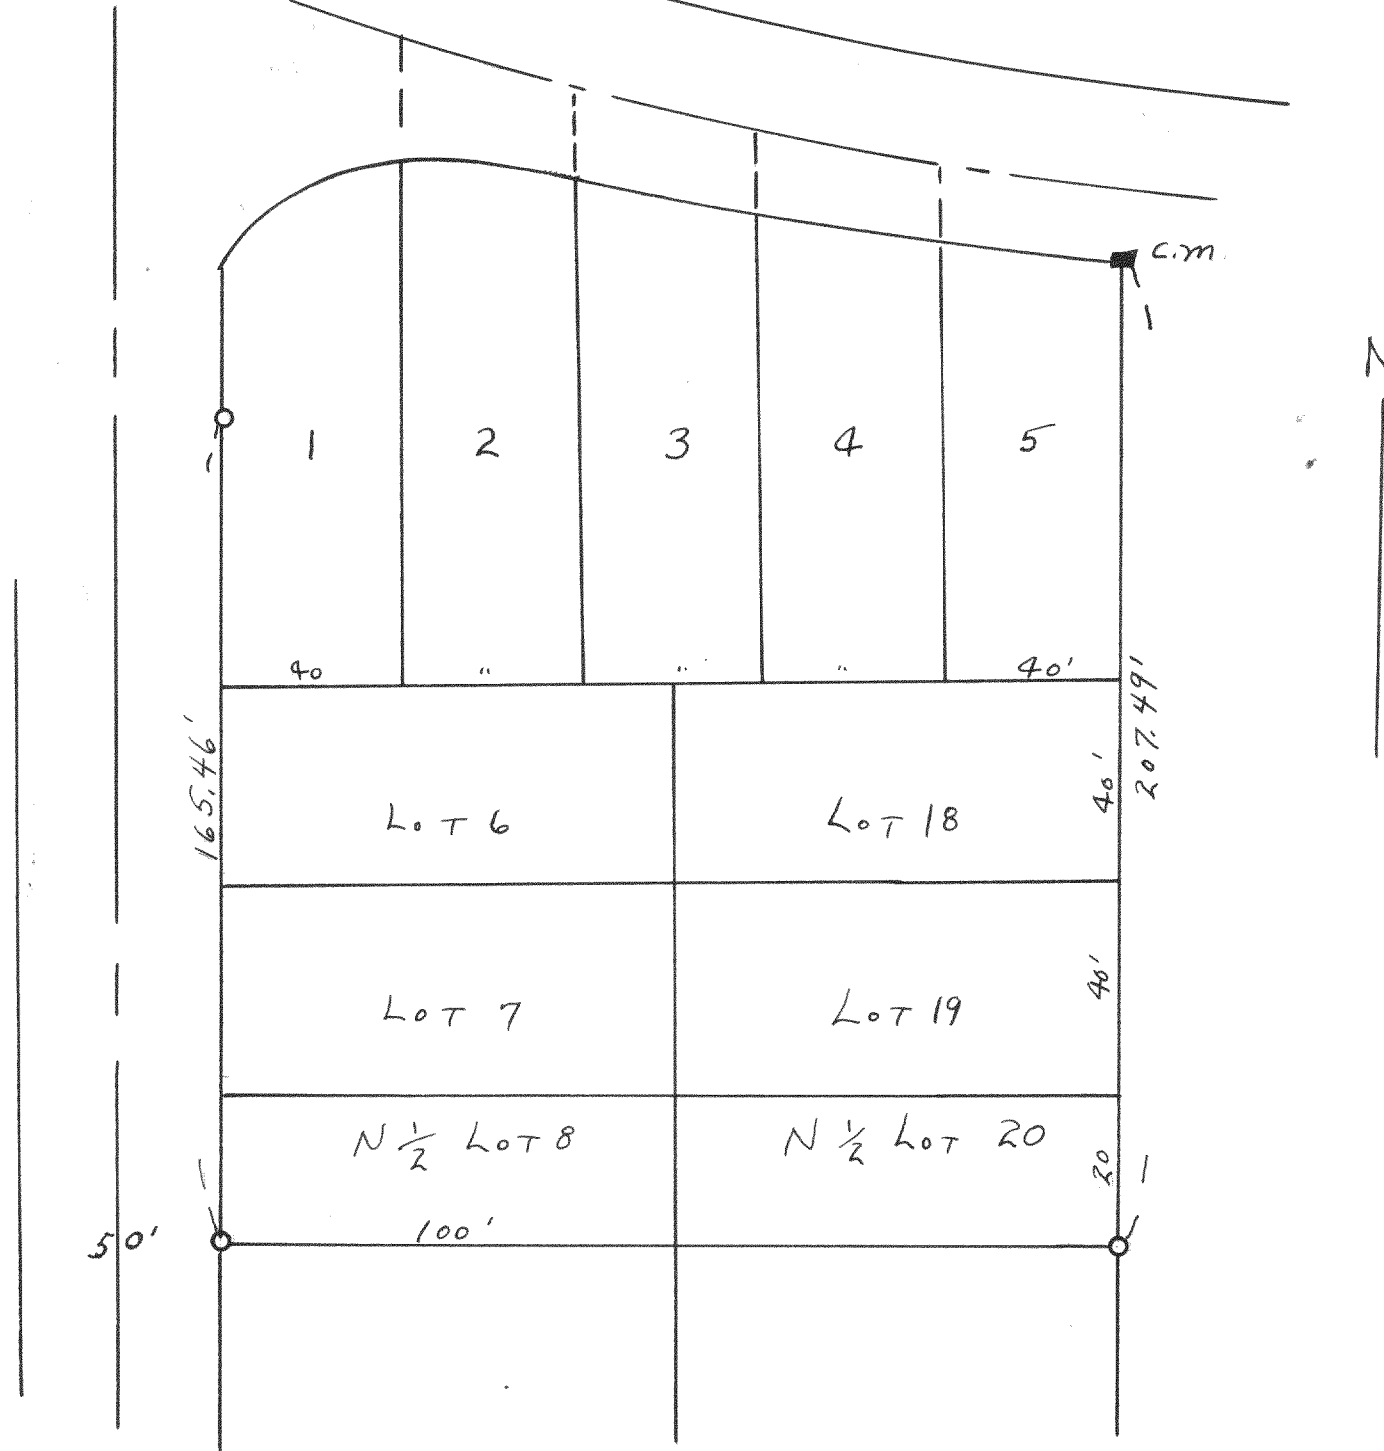

PLAT OF SURVEY OF LOTS 1, 2, 3, 4, 5, 6,
 7, N 1/2 LOT 8, 18, 19 AND THE N 1/2
 OF LOT 20 OF BLOCK 18 OF THE SECOND
 MAP OF INTERLAKEN SUBDIVISION,
 LOCATED IN SECTION 11, T3N R16E

Dec. 6, 1952

Lloyd L. Jensen
 County Surveyor