


2662

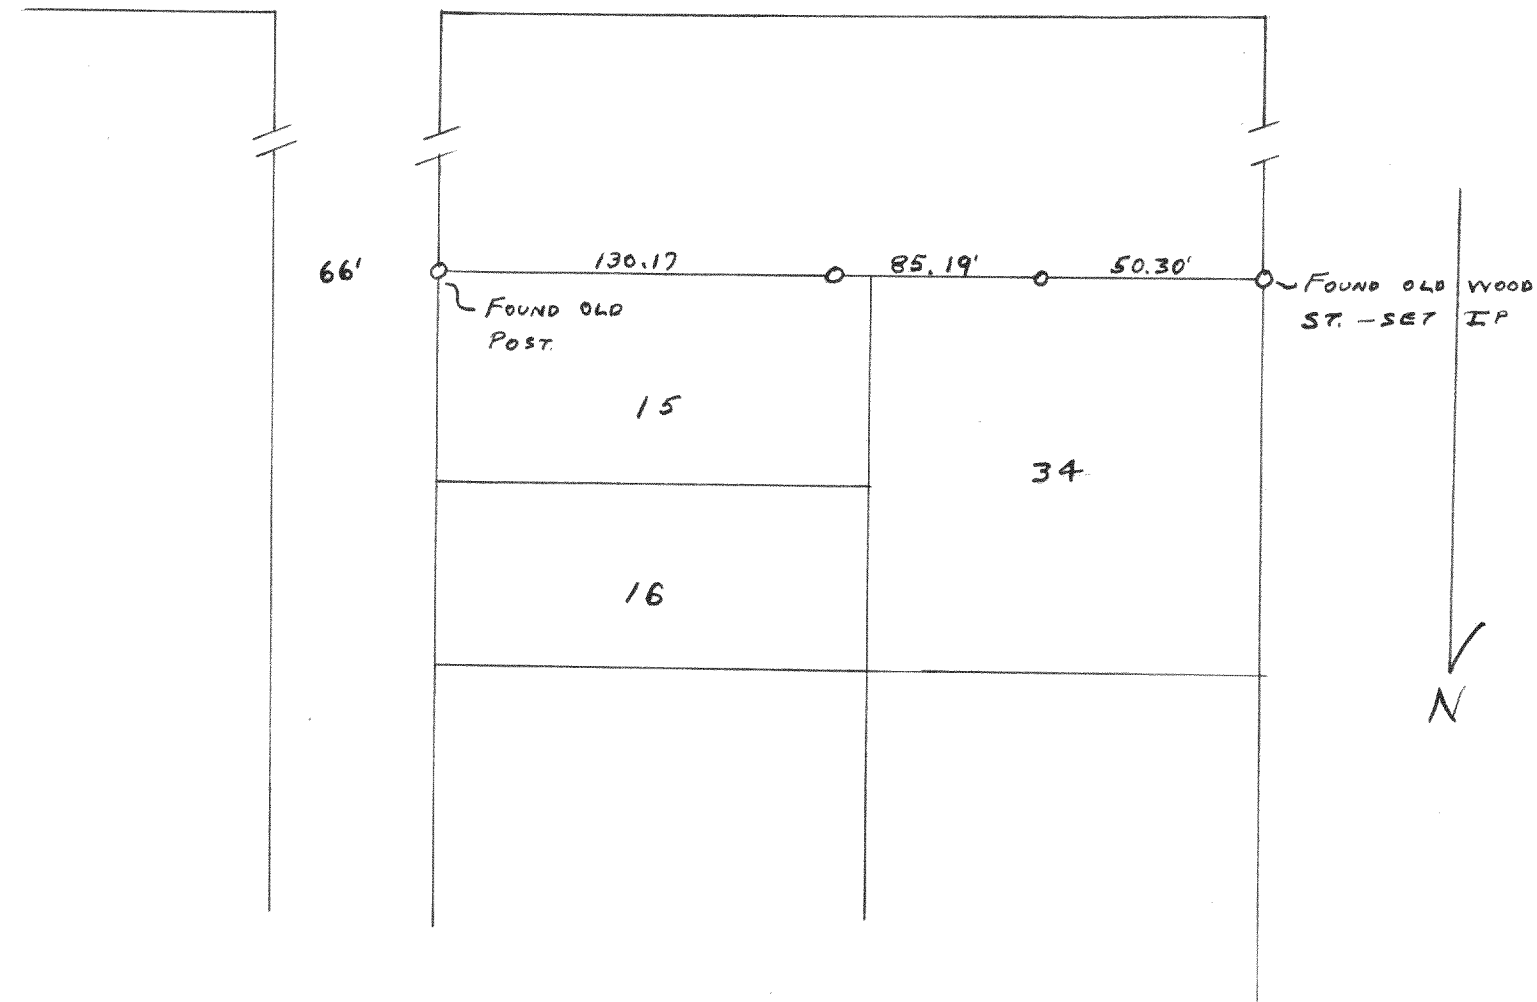


PLAT OF SURVEY OF THE SOUTH LINE OF
 LOTS 15 AND 34 OF BLOCK 2 OF SIDNEY
 ALLEN'S ADDITION TO ALLENS GROVE.

OCT 1, 1952

LLOYD L. JENSEN
 COUNTY SURVEYOR

2663

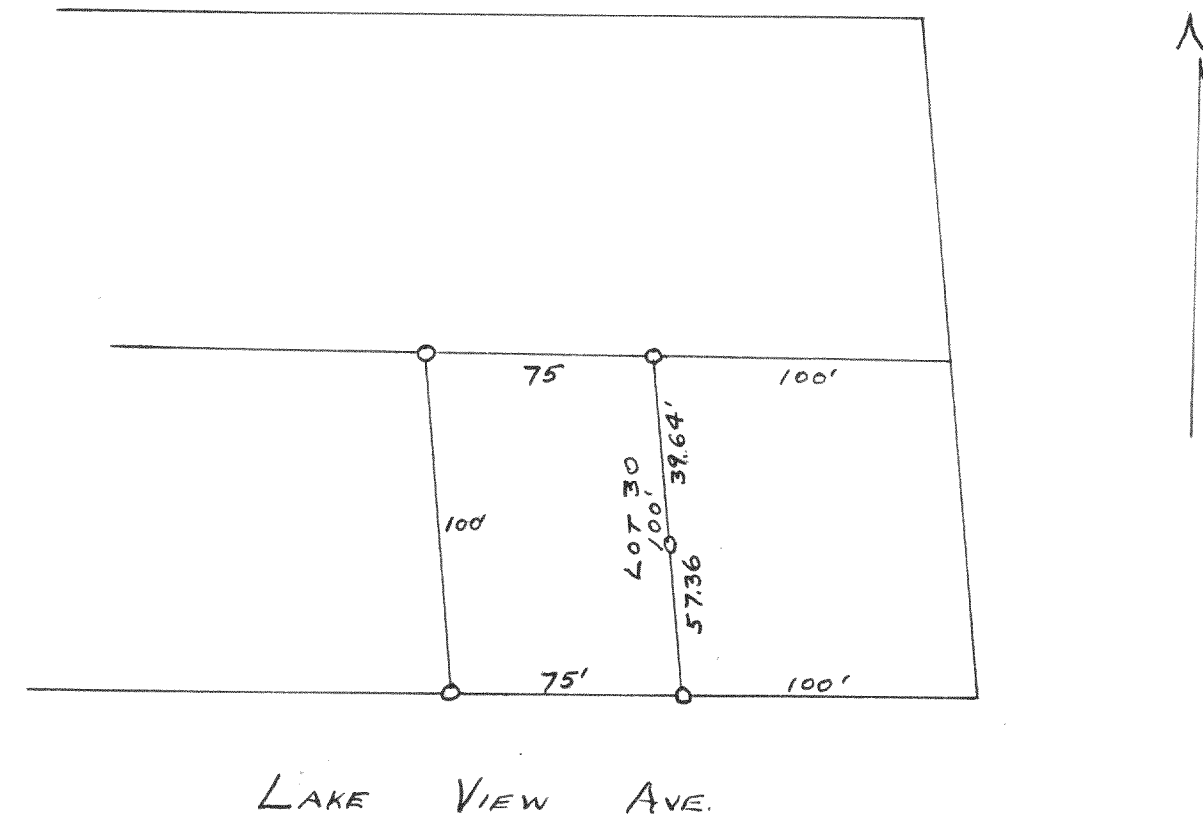

PLAT OF SURVEY OF LOTS 30, 31 & 32
 OF BLOCK 107 OF LAKE WANDAWEGA
 SUBDIVISION, T3N, R16E.

1952

LLOYD L. JENSEN
 COUNTY SURVEYOR