



2668

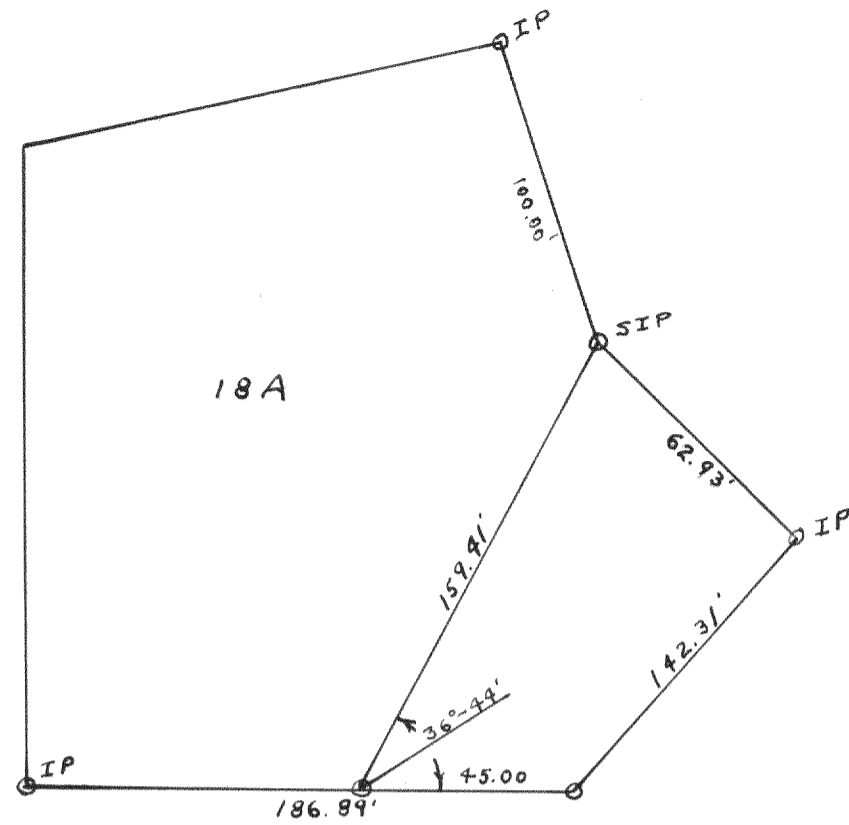


PLAT OF SURVEY OF PART OF LOT 18A OF
 TRINKE ESTATES, LOCATED IN SECTION 10,
 TINRITE.
 June 17, 1952
 Floyd L Jensen SA
 COUNTY SURVEYOR

2669

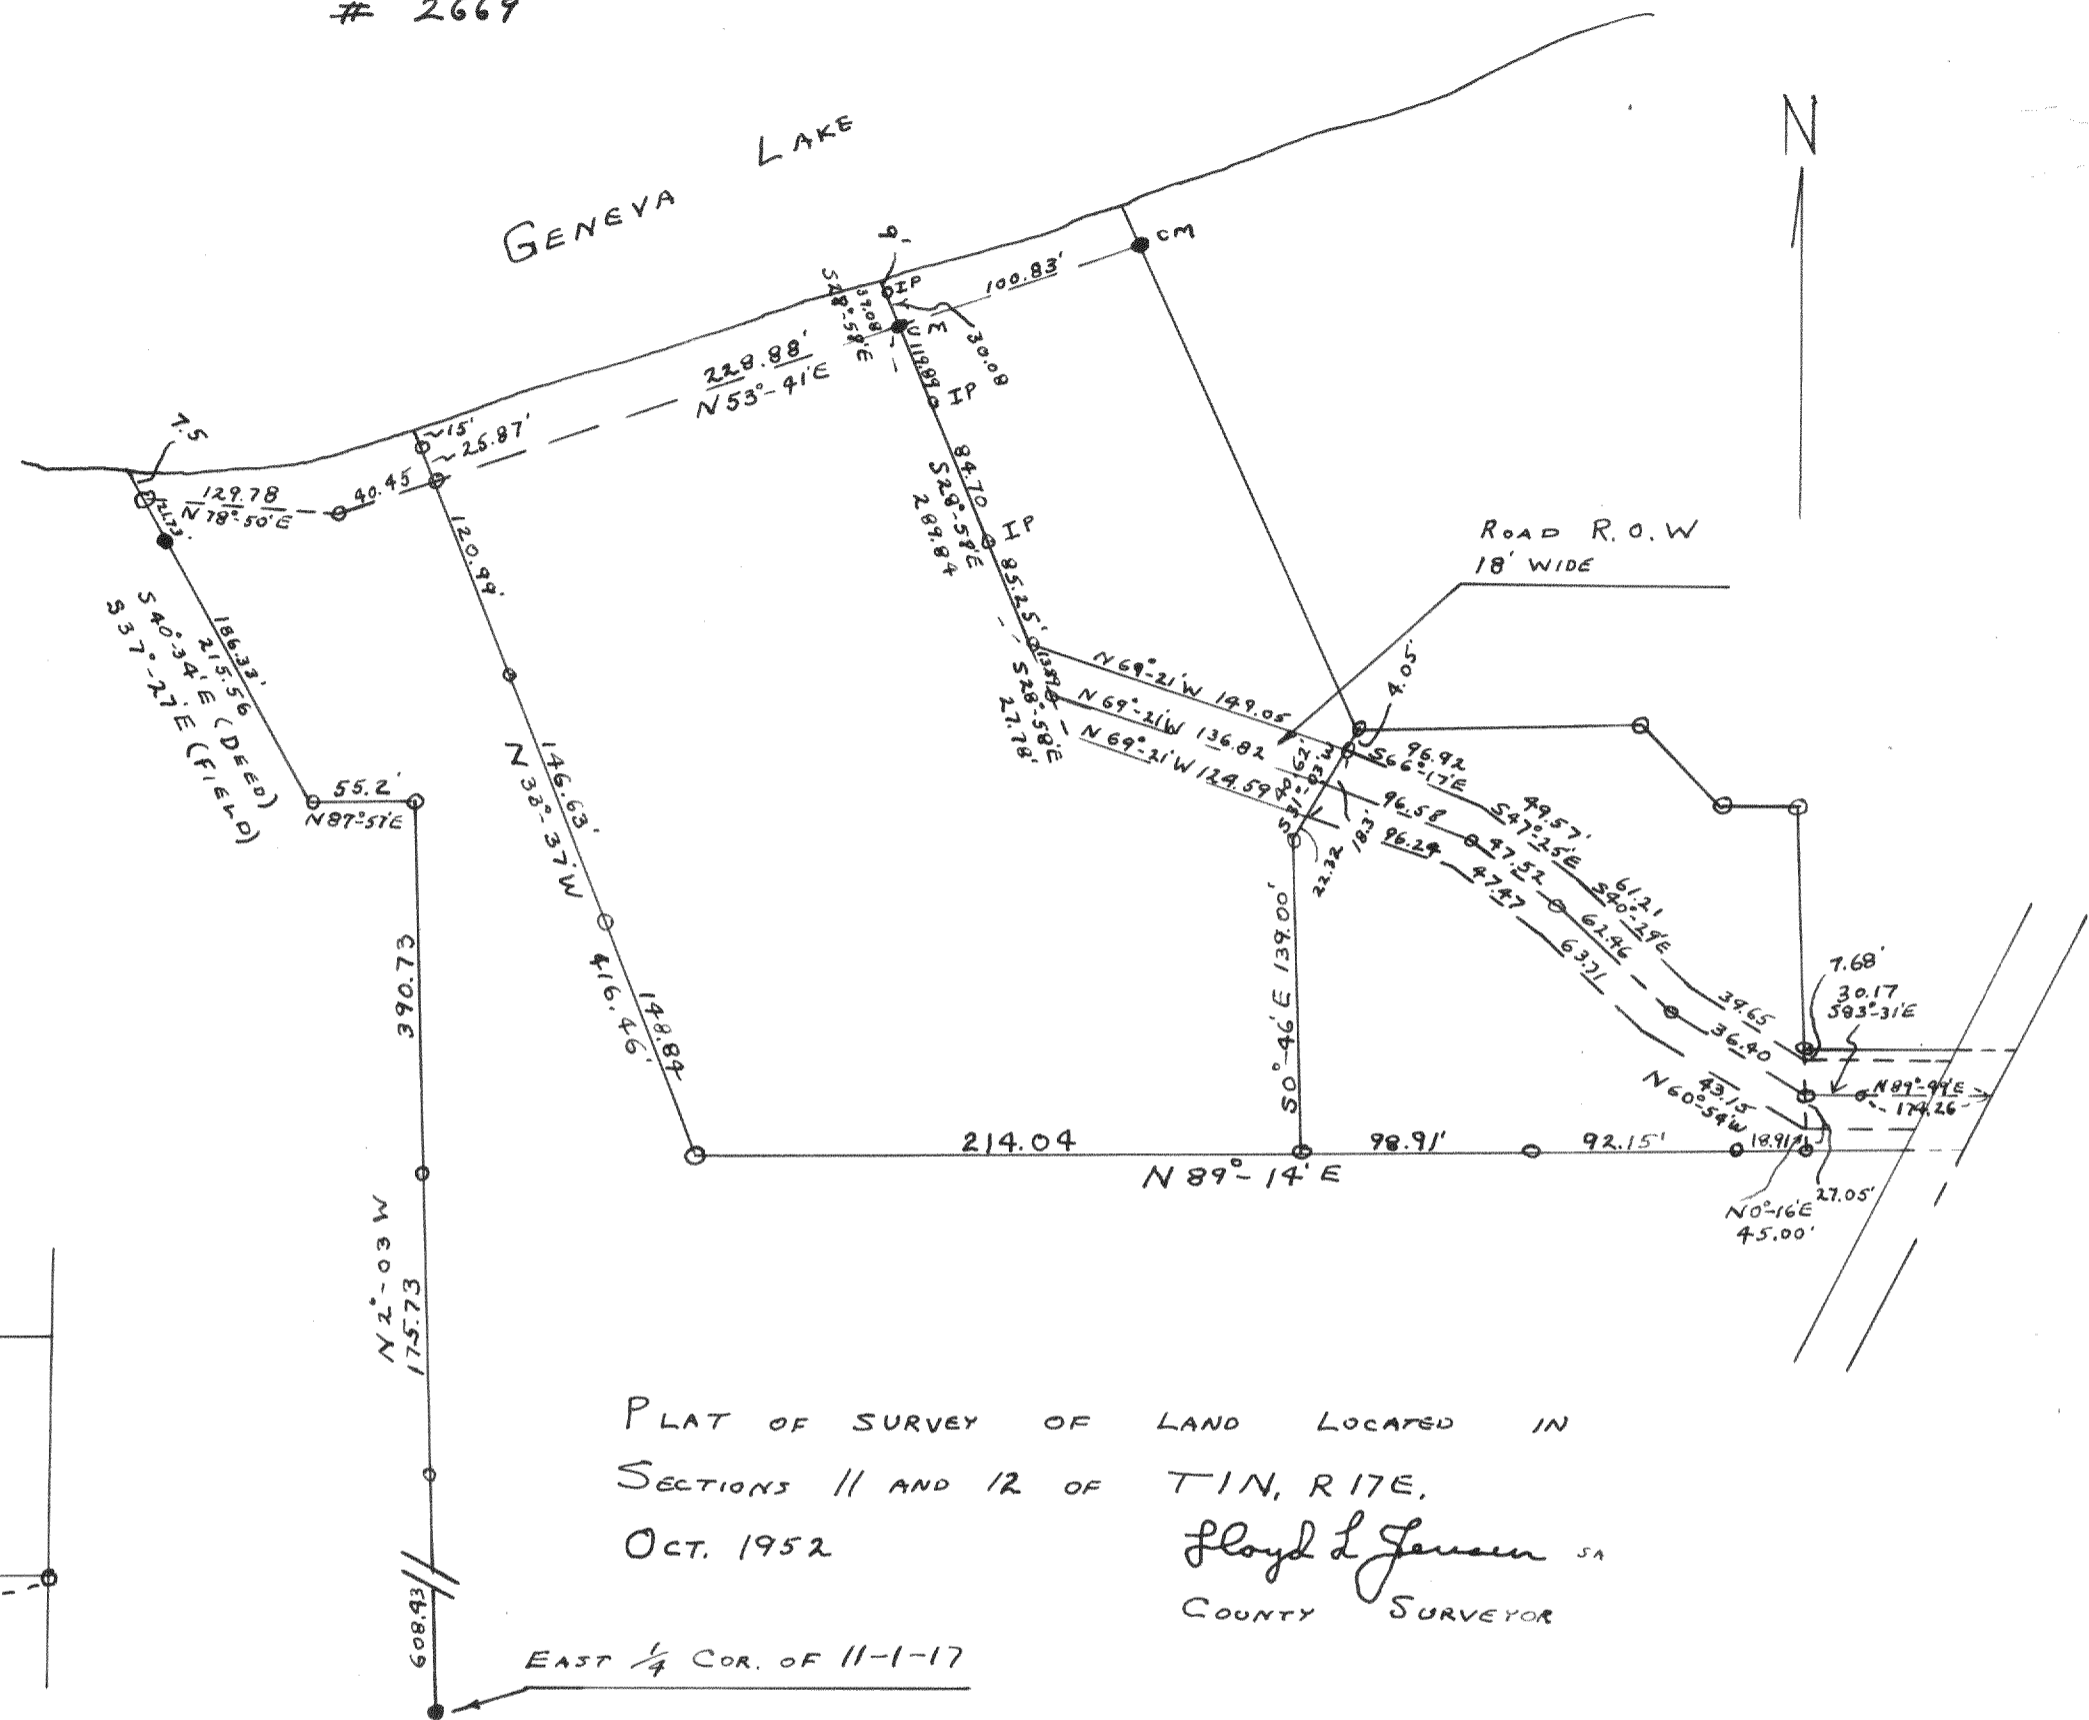

PLAT OF SURVEY OF LAND LOCATED IN
 SECTIONS 11 AND 12 OF TINRITE,
 OCT. 1952
 Floyd L Jensen SA
 COUNTY SURVEYOR

2670

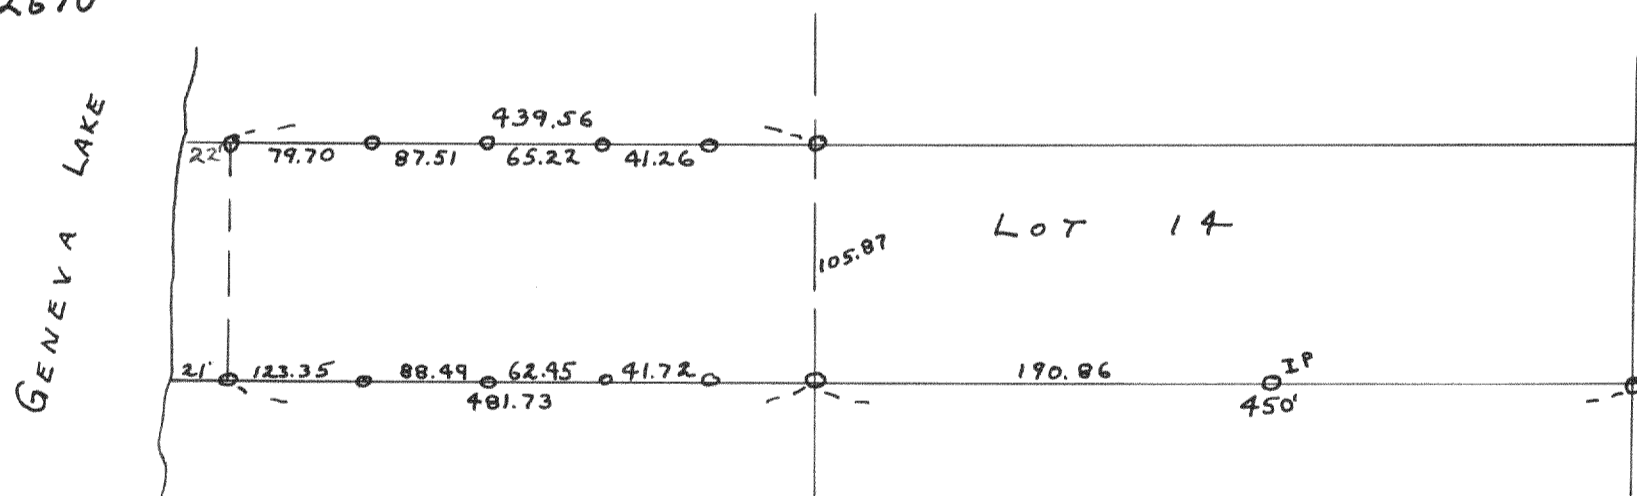

PLAT OF SURVEY TO PLACE ADDITIONAL STAKES ALONG
 THE LINES OF LOT 14 OF S. B. CHAPIN SUBDIVISION.
 AUGUST 1952

Floyd L Jensen SA
 COUNTY SURVEYOR