



Plat of Survey of Lots 2151 to 2155, Inclusive Block 35, Lake Como Beach Located in the Northwest 1/4 of Section 22, T1N R17E, Walworth County, Wisconsin April, 1958

Lloyd L. Jensen
County Surveyor

3312

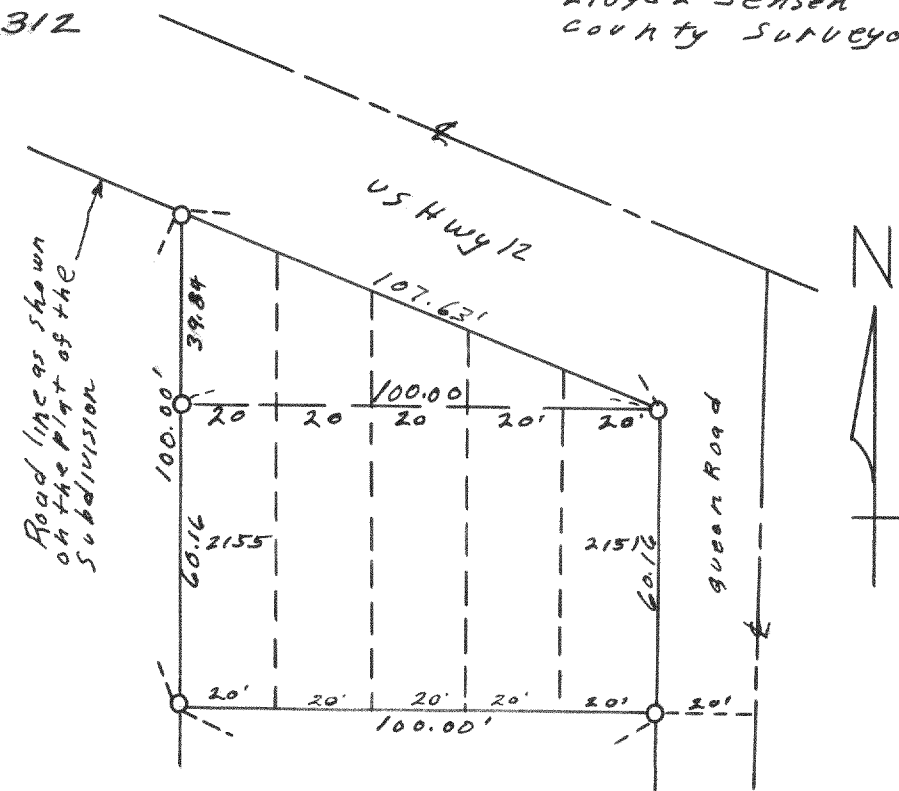

3314

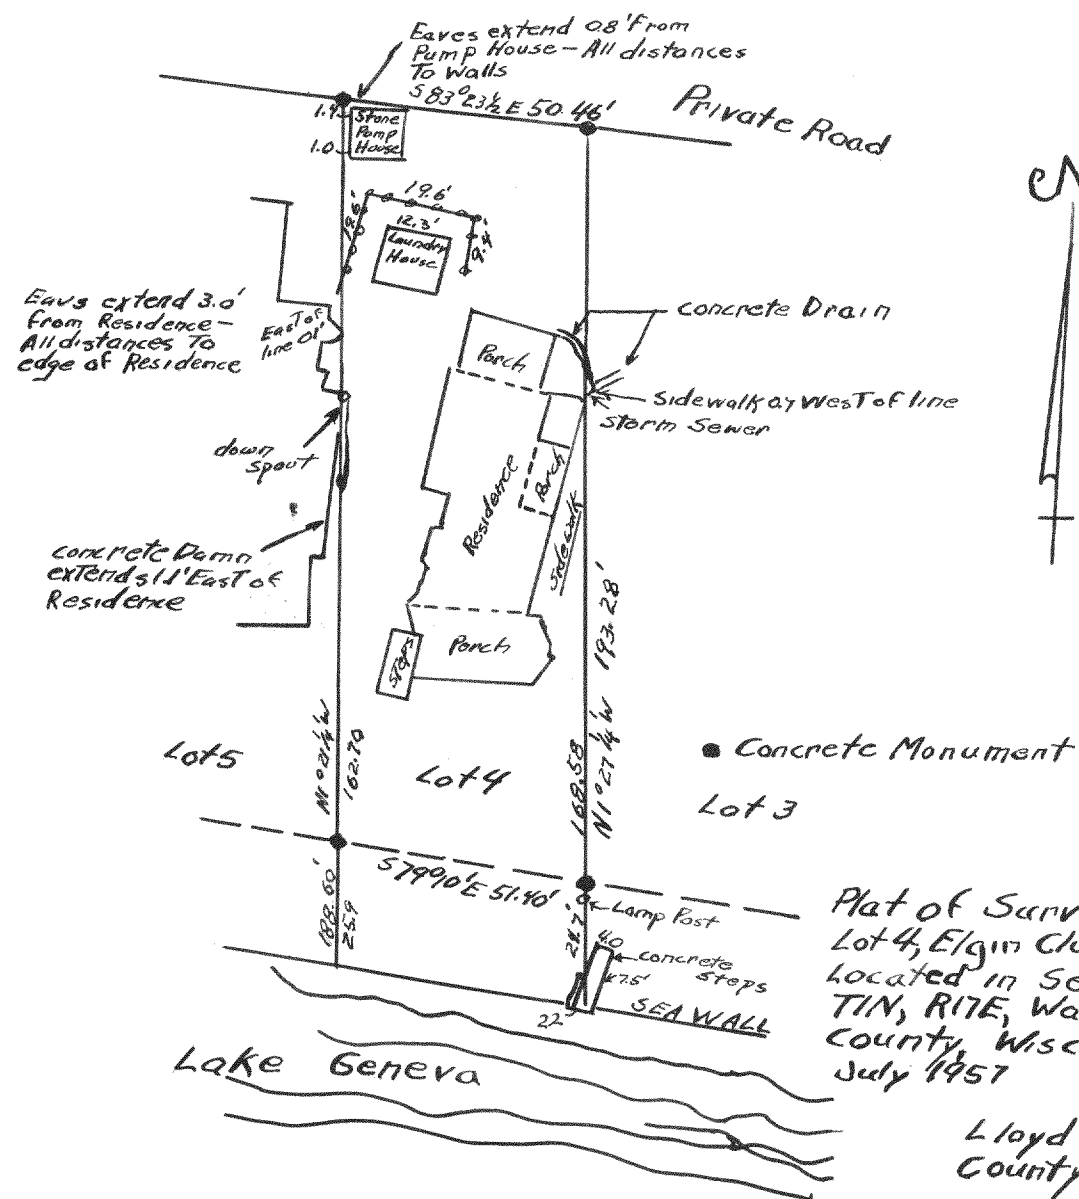


Plat of Survey of Lot 4, Elgin Club, located in Section 4, T1N, R17E, Walworth County, Wisconsin July 1957

Lloyd L. Jensen
County Surveyor

3313

Lot c - Private drive for property owners 50 feet wide

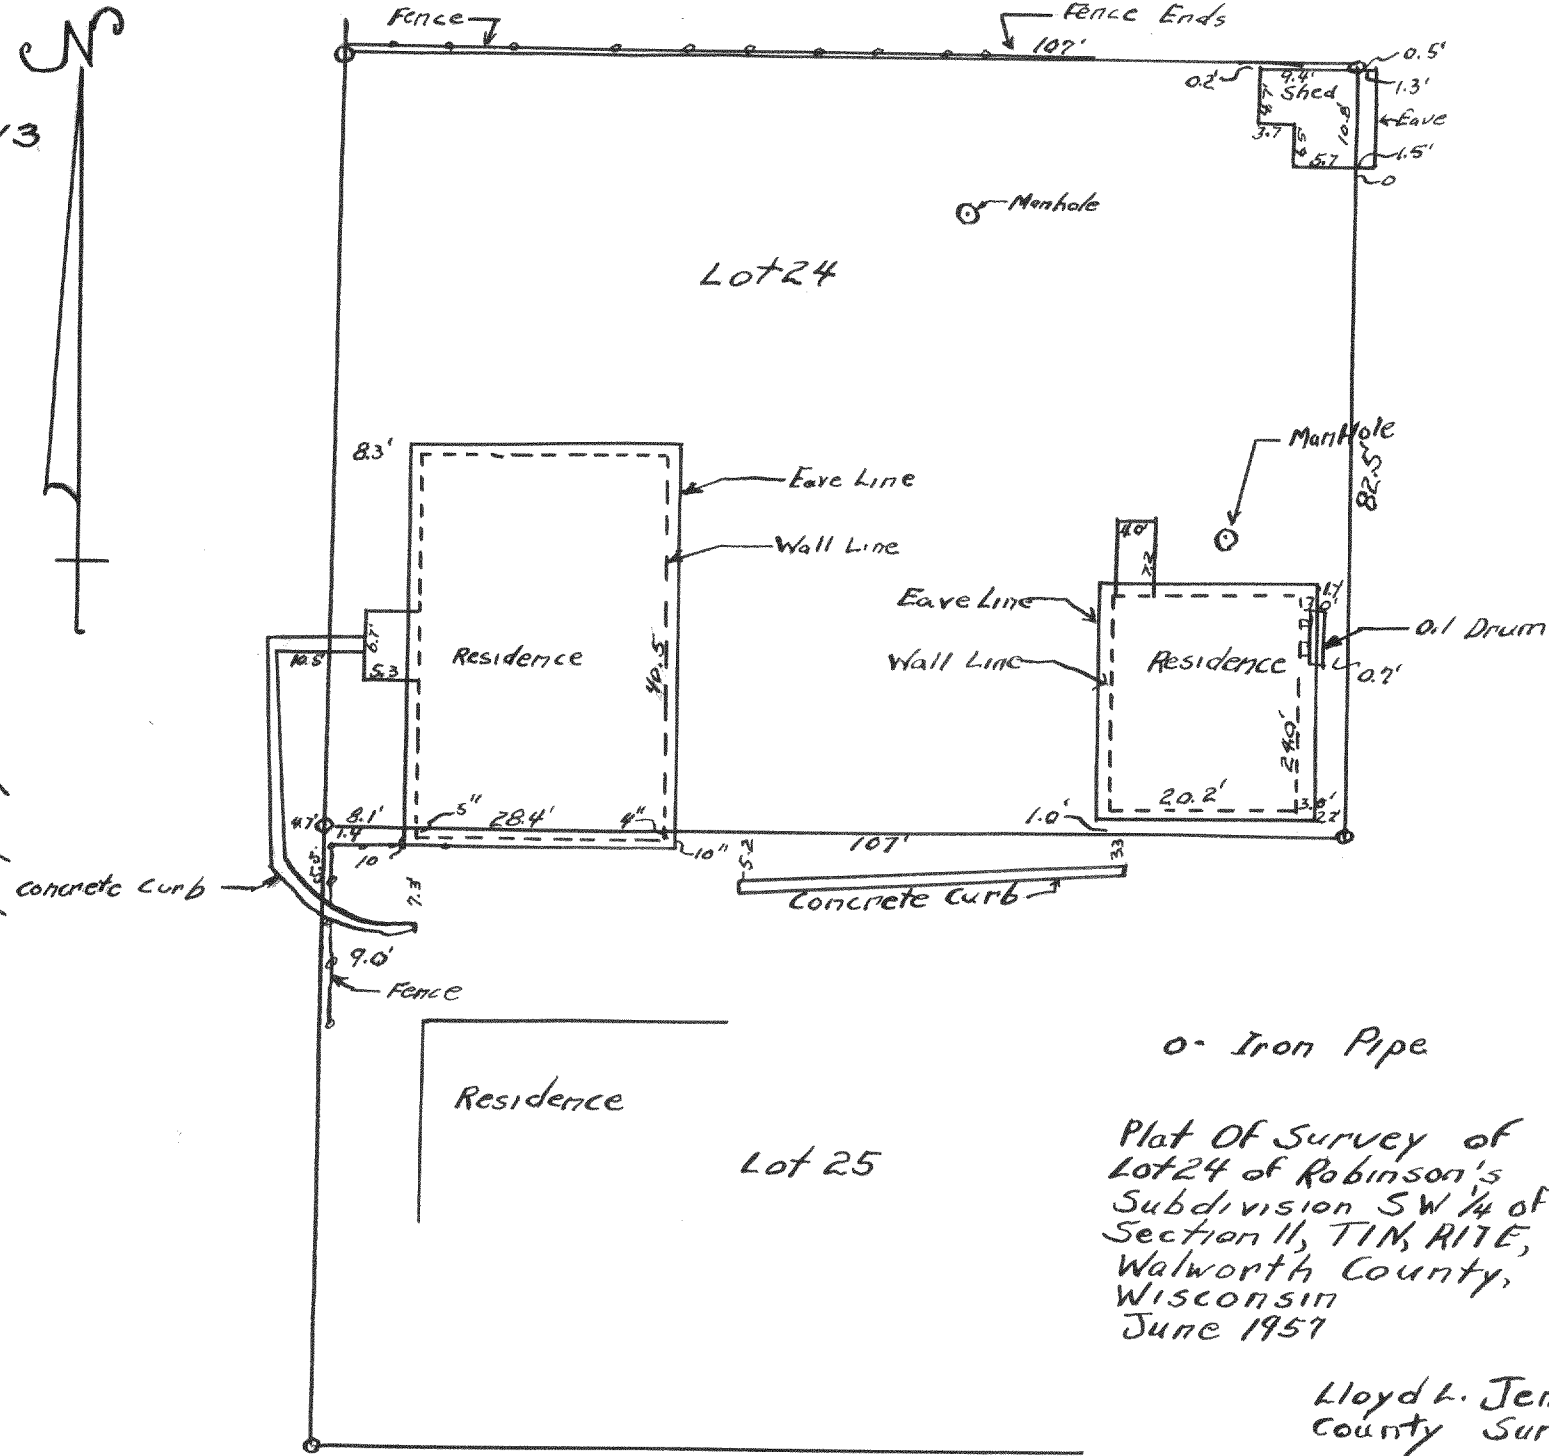

0- Iron Pipe

Plat of Survey of Lot 24 of Robinson's Subdivision SW 1/4 of Section 11, T1N, R17E, Walworth County, Wisconsin June 1957

Lloyd L. Jensen
County Surveyor