

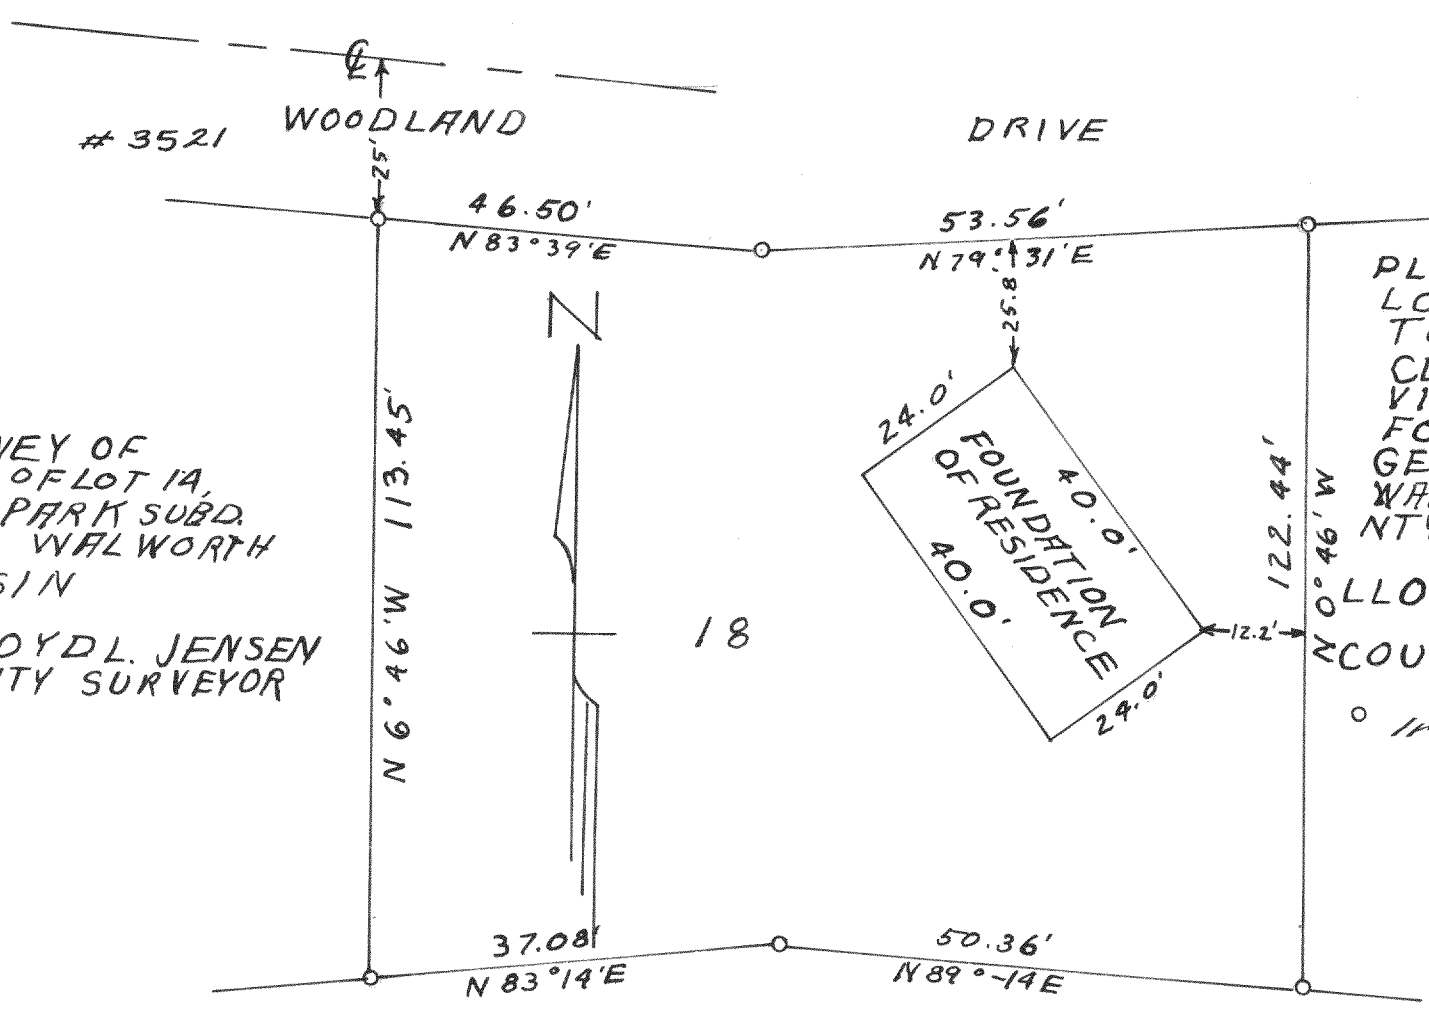



PLAT OF SURVEY OF  
 LOT 13 AND PART OF LOT 14,  
 BLOCK 1, MORaine PARK SUBD.  
 SEC. 34, T4N, R15E WALWORTH  
 COUNTY WISCONSIN  
 LLOYD L. JENSEN  
 COUNTY SURVEYOR

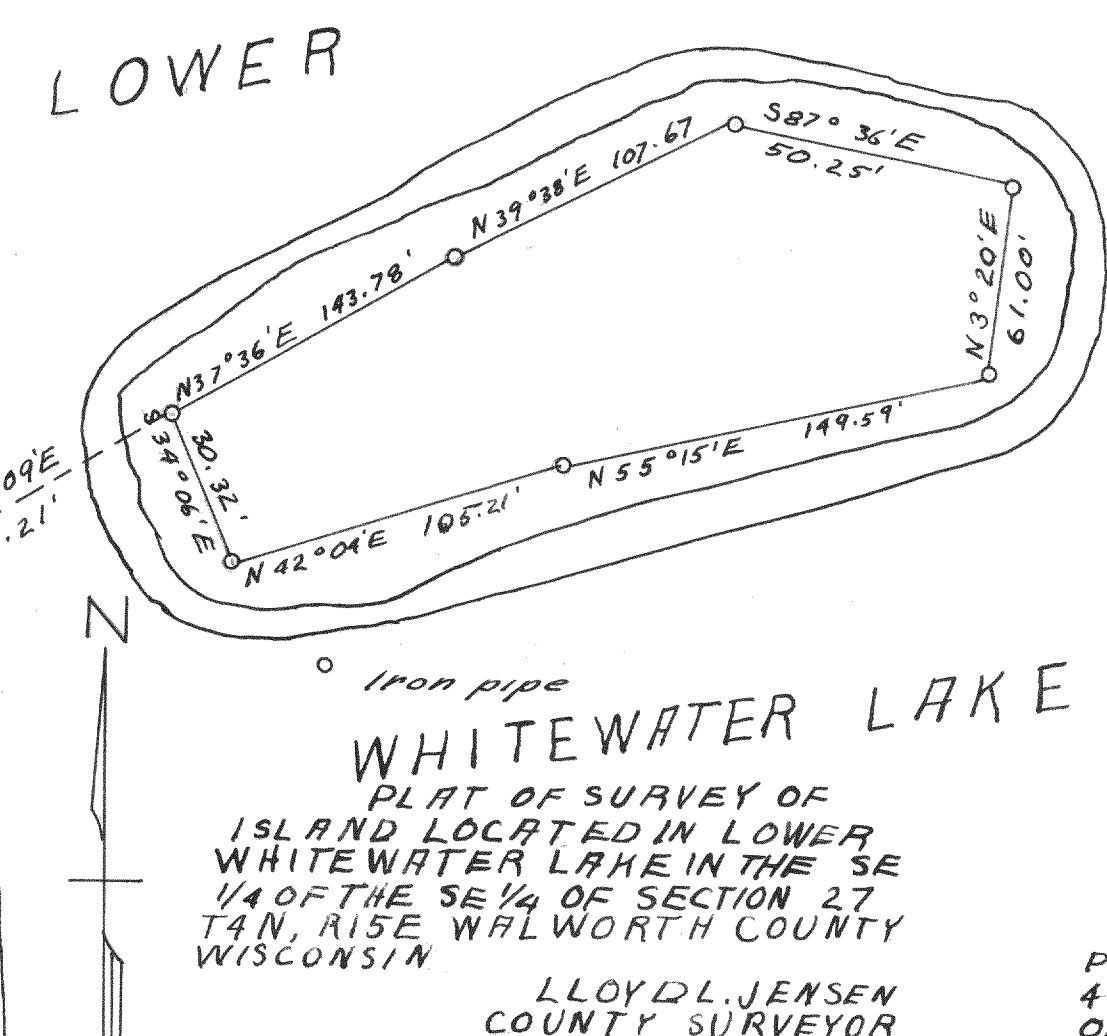

PLAT OF SURVEY OF  
 LOT 18, ADD. "E"  
 TO COUNTRY  
 CLUB ESTATES,  
 VILLAGE OF  
 FONTANA-ON-  
 GENEVA LAKE  
 WALWORTH COUNTY  
 WISCONSIN  
 LLOYD L. JENSEN  
 COUNTY SURVEYOR

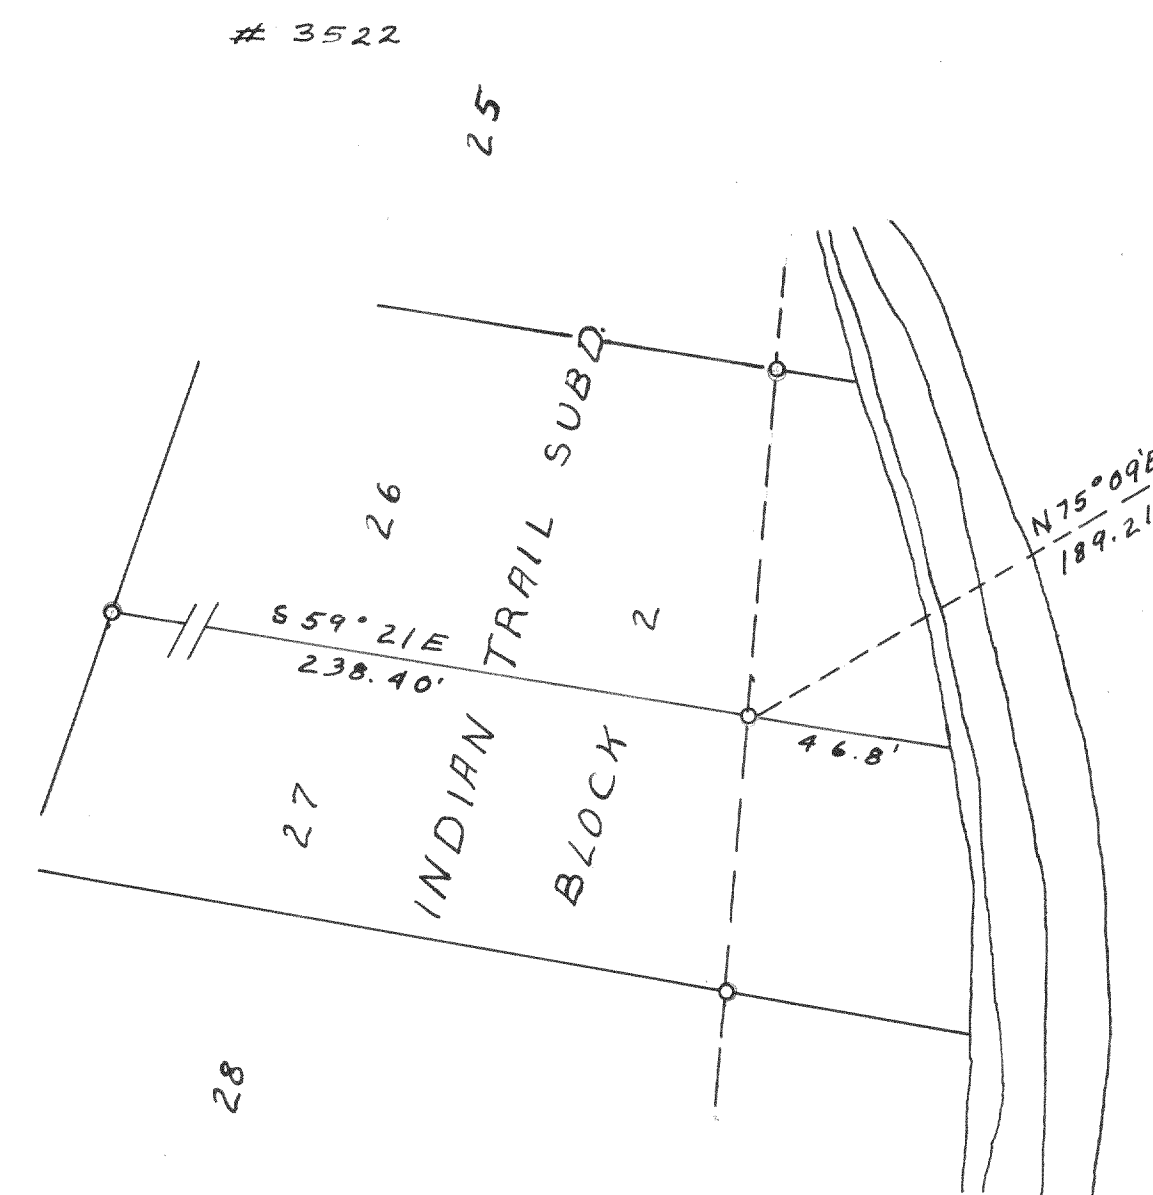

PLAT OF SURVEY OF  
 ISLAND LOCATED IN LOWER  
 WHITEWATER LAKE IN THE SE  
 1/4 OF THE SE 1/4 OF SECTION 27  
 T4N, R15E WALWORTH COUNTY  
 WISCONSIN  
 LLOYD L. JENSEN  
 COUNTY SURVEYOR

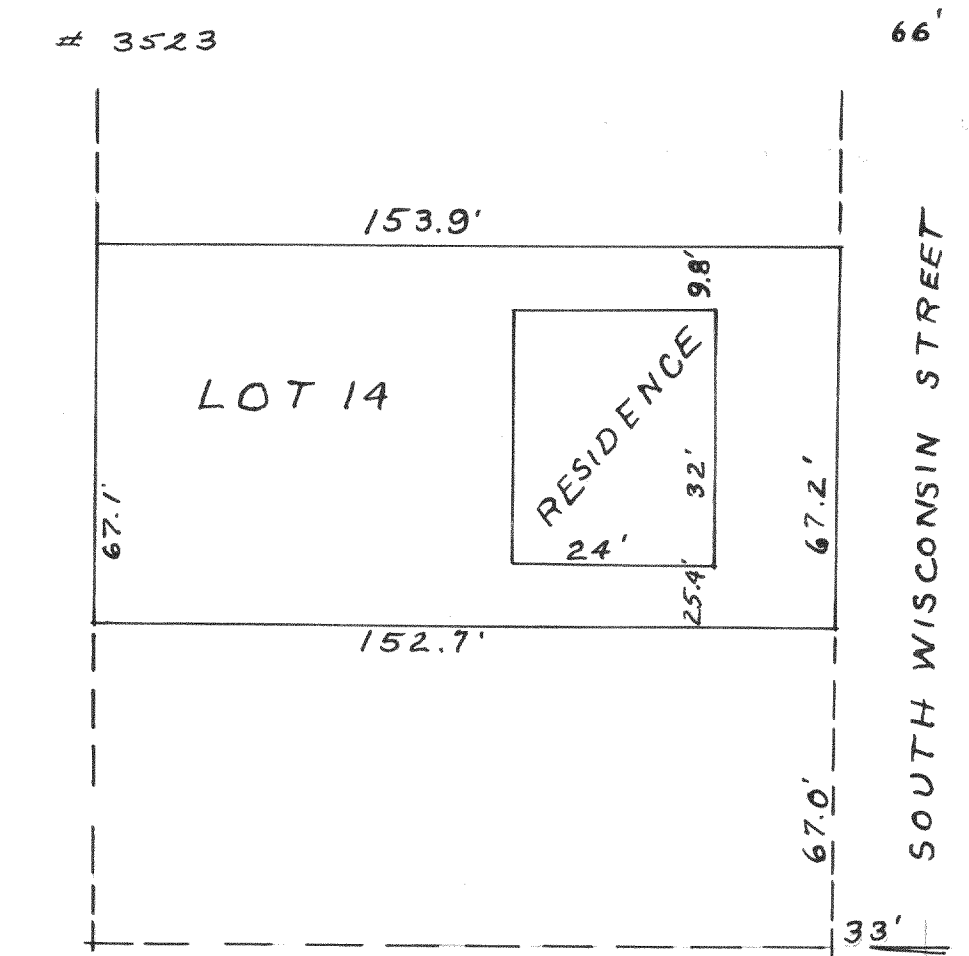

PLAT OF SURVEY OF LOT 14 OF BLOCK  
 4 OF PRESTON'S ADD. TO THE CITY  
 OF ELKHORN, WALWORTH COUNTY  
 WISCONSIN  
 LLOYD L. JENSEN  
 COUNTY SURVEYOR

EAST 1/4 SEC. COR-  
 NER OF SEC. 1,  
 T2N, R16E