




Plat of survey of F25 add F to Country Club Estates, Village of Fontana, Walworth County Wisconsin Lloyd L. Jensen July 1959 County Surveyor

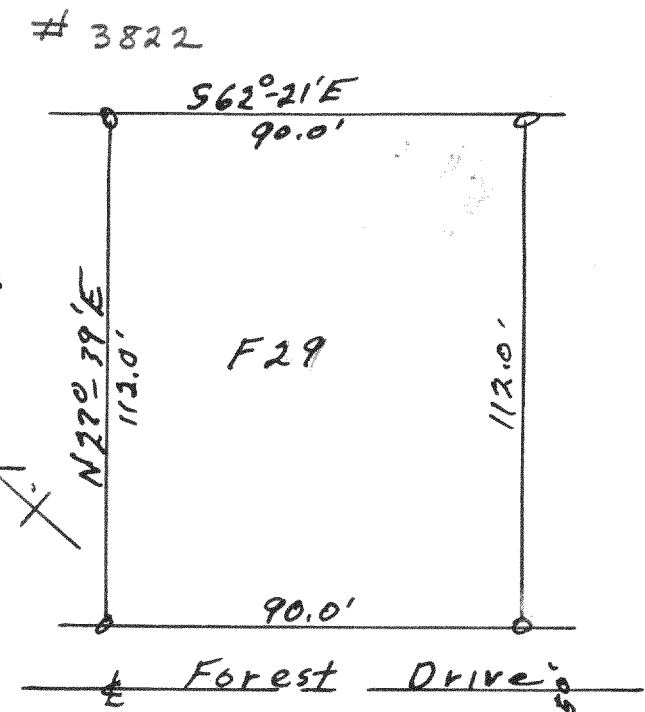


Plat of survey of Lot 29 add F to Country Club Estates, Village of Fontana, Walworth County Wisconsin July 1959 Lloyd L. Jensen County Surveyor

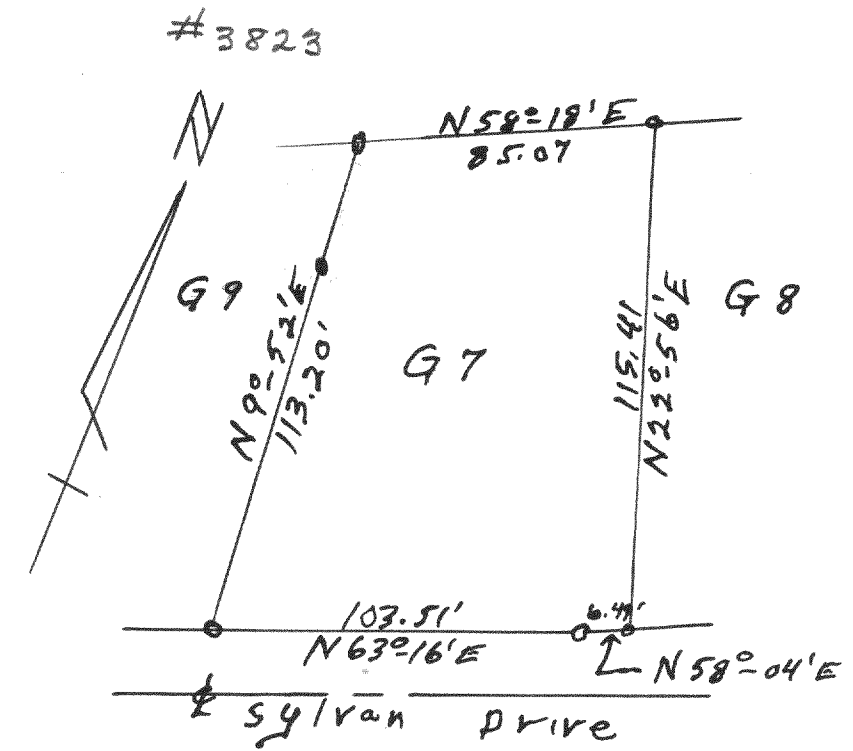


Plat of survey of Lot G-7 Add. G to Country Club Estates, Village of Fontana, Walworth County Wisconsin. Sept. Lloyd L. Jensen 1959 County Surveyor

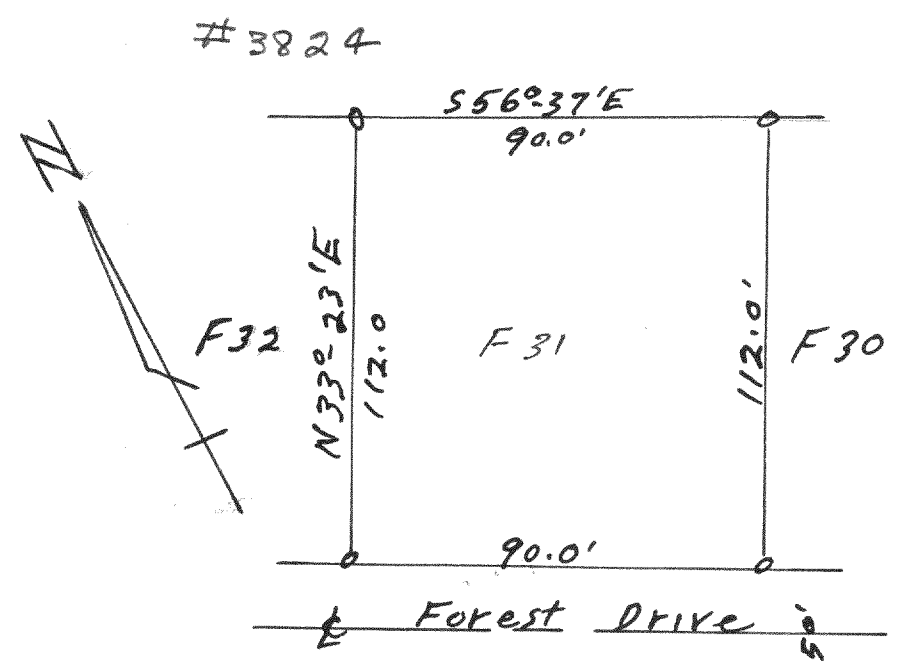


Plat of survey of Lot F31 add. F to Country Club Estates Village of Fontana, Walworth County Wisconsin Lloyd L. Jensen July 1959 County Surveyor

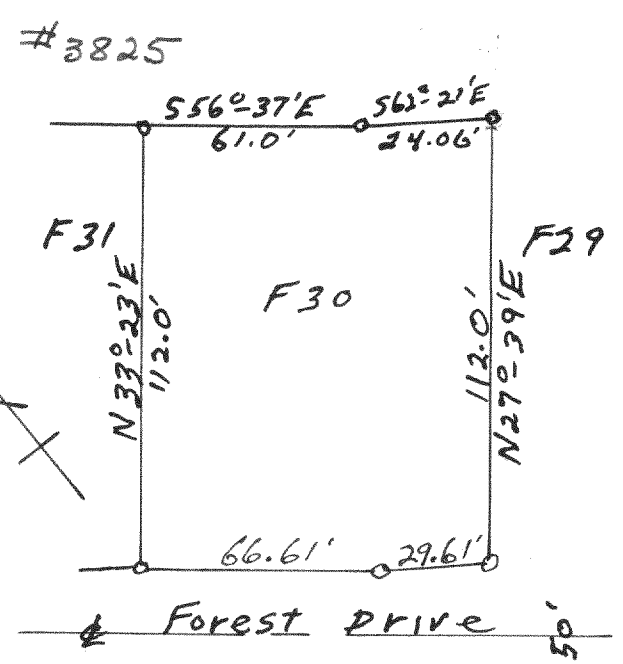

Plat of survey of Lot F-30 Add. F to Country Club Estates, Village of Fontana, Walworth County, Wisconsin Sept. Lloyd L. Jensen 1959 County Surveyor

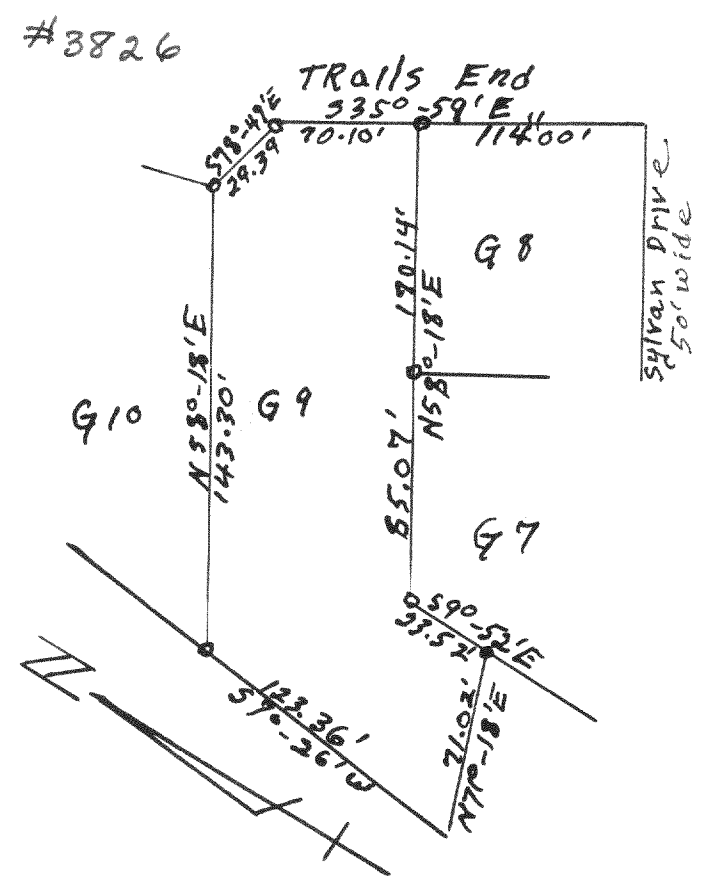

Plat of survey of Lot G-8 Add. G to Country Club Estates, Village of Fontana, Walworth County Wisconsin. Oct. 1959 Lloyd L. Jensen County Surveyor

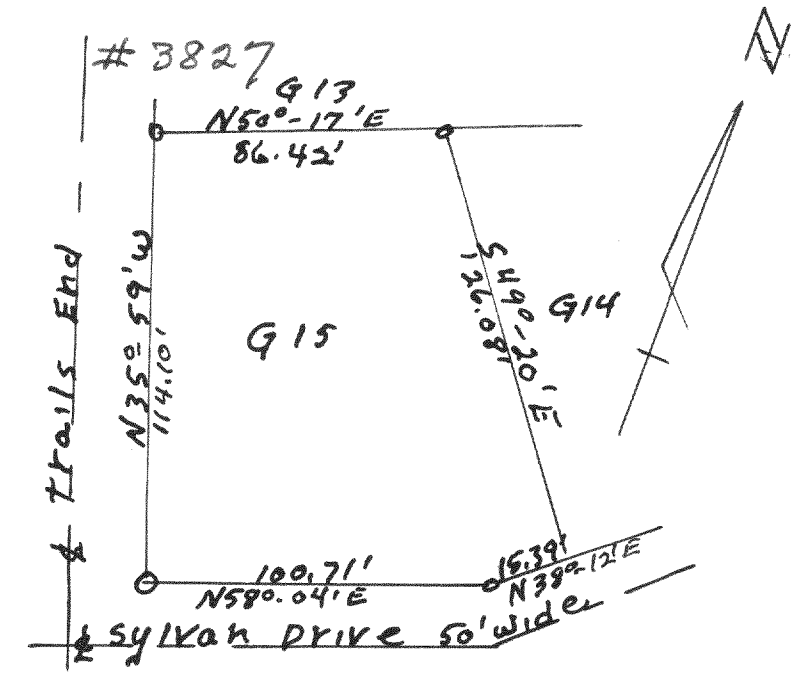

Plat of survey of Lot G15 Add. G to Country Club Estates, Village of Fontana, Walworth County Wisconsin. Oct 1959 Lloyd L. Jensen County Surveyor