


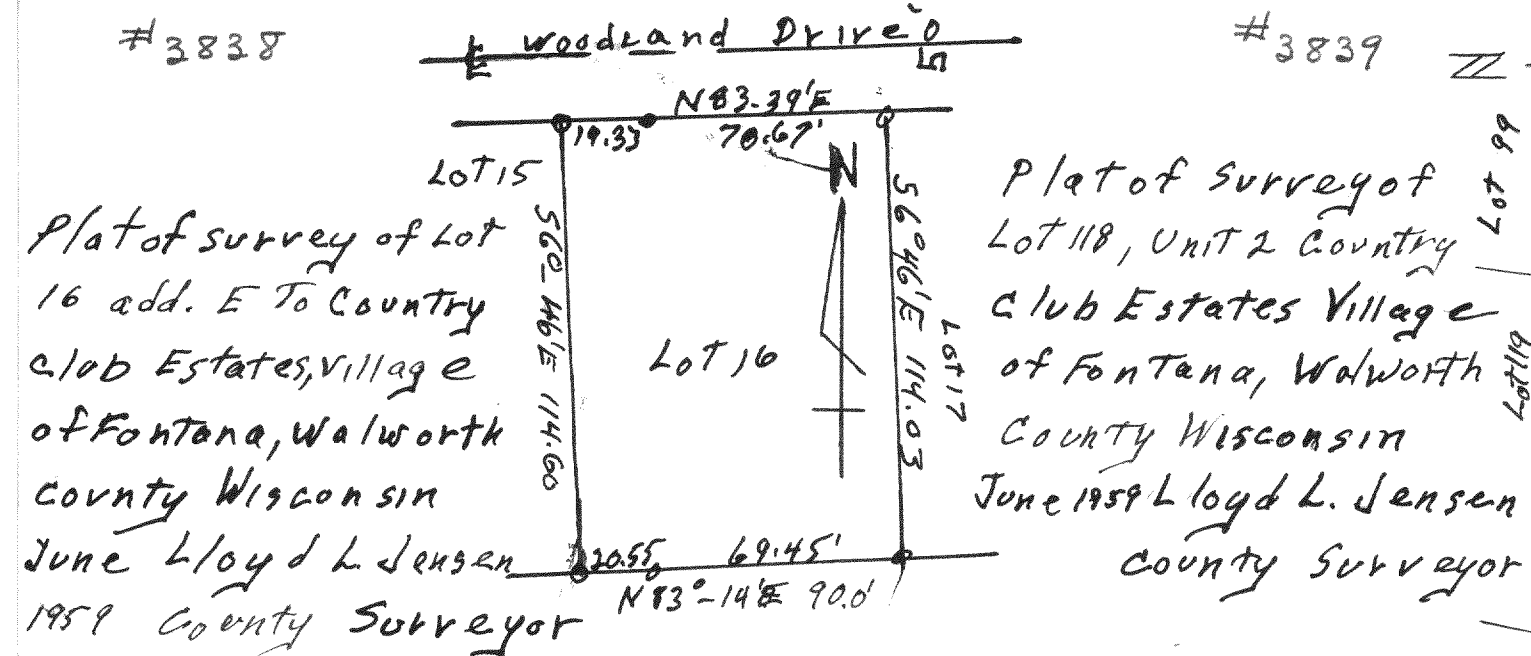


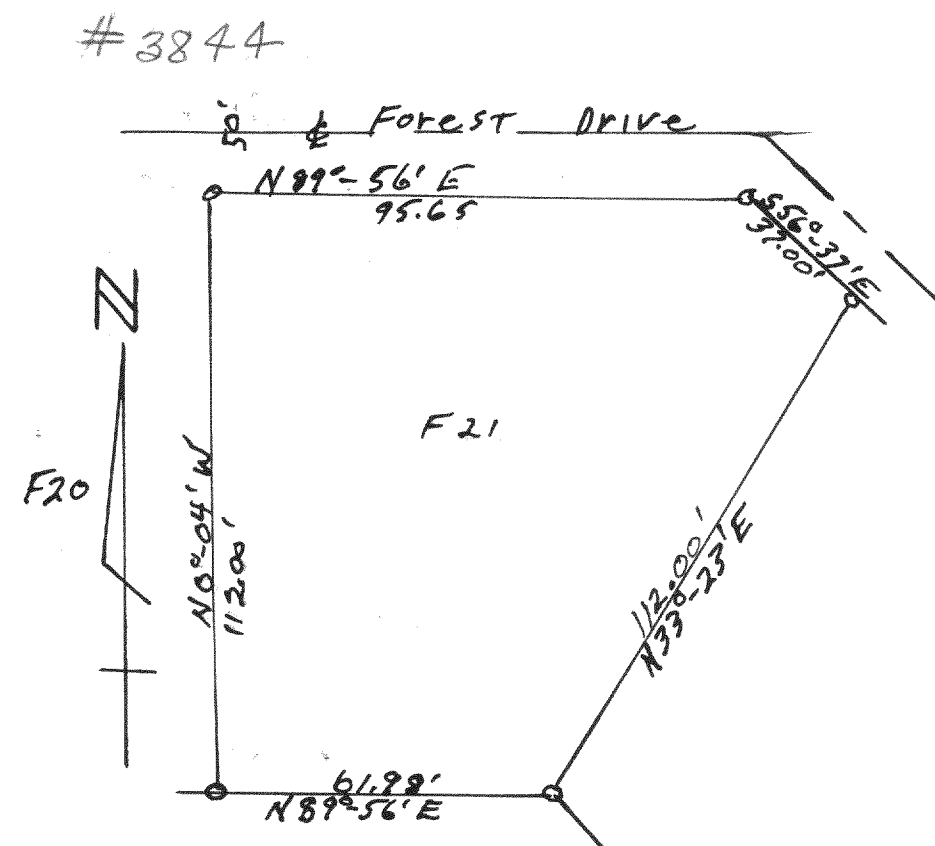

Plat of survey of Lot 118, Unit 2 Country Club Estates Village of Fontana, Walworth County Wisconsin
June 1959 Lloyd L. Jensen
County Surveyor

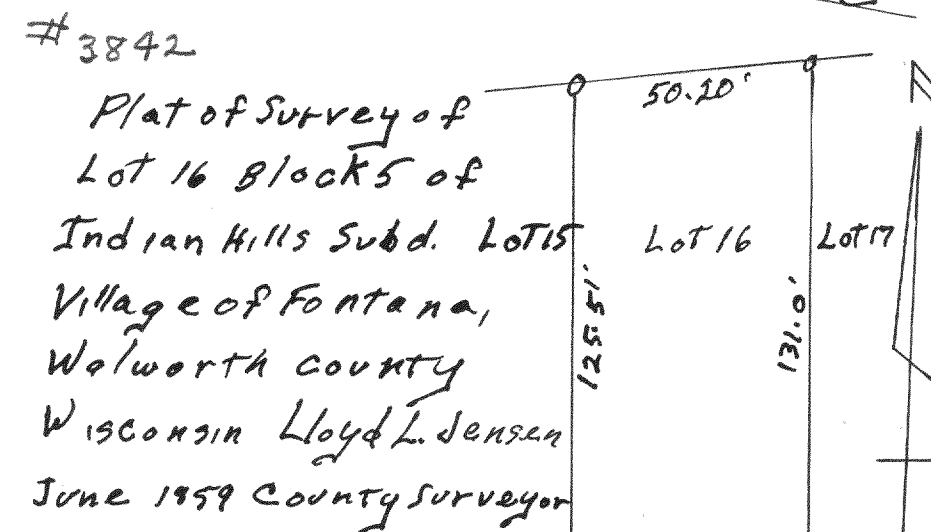


Plat of survey of Lot F21 Add. E To Country Club Estates, Village of Fontana, Walworth County Wisconsin
Nov. 1959 Lloyd L. Jensen
County Surveyor

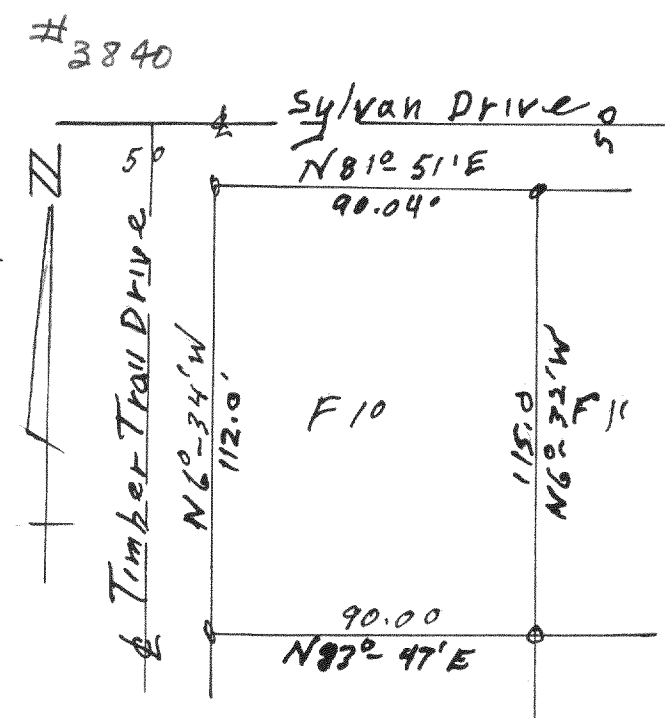


Plat of survey of Lot F10 add. F To Country Club Estates Village of Fontana, Walworth County Wisconsin Lloyd L. Jensen
Feb. 1959 County Surveyor

Plat of survey of Lot 20, add. E To Country Club Estates, Village of Fontana, Walworth County, Wisconsin
Mar. Lloyd L. Jensen
1959 County Surveyor

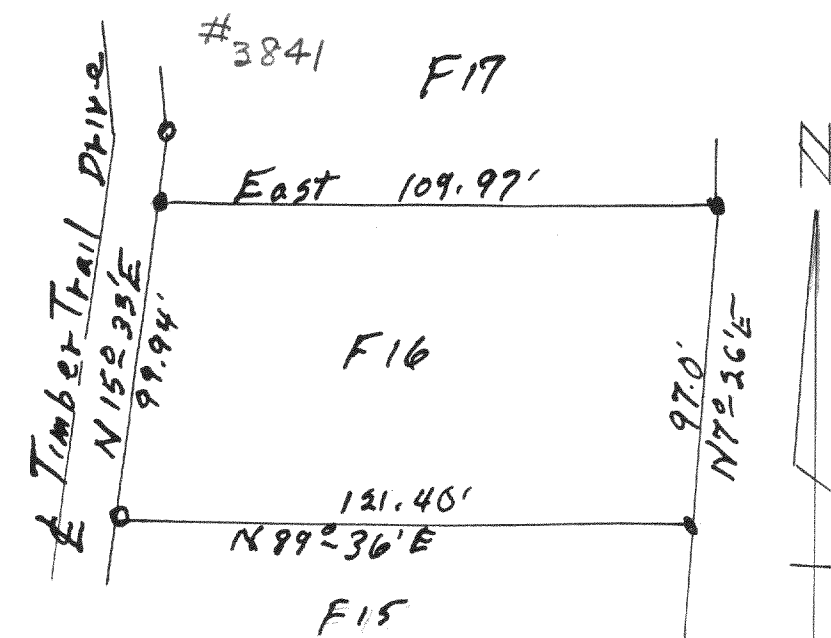

Plat of survey of Lot F16 add. F To Country Club Estates, Village of Fontana, Walworth County Wisconsin Lloyd L. Jensen
Feb. 1959 County Surveyor

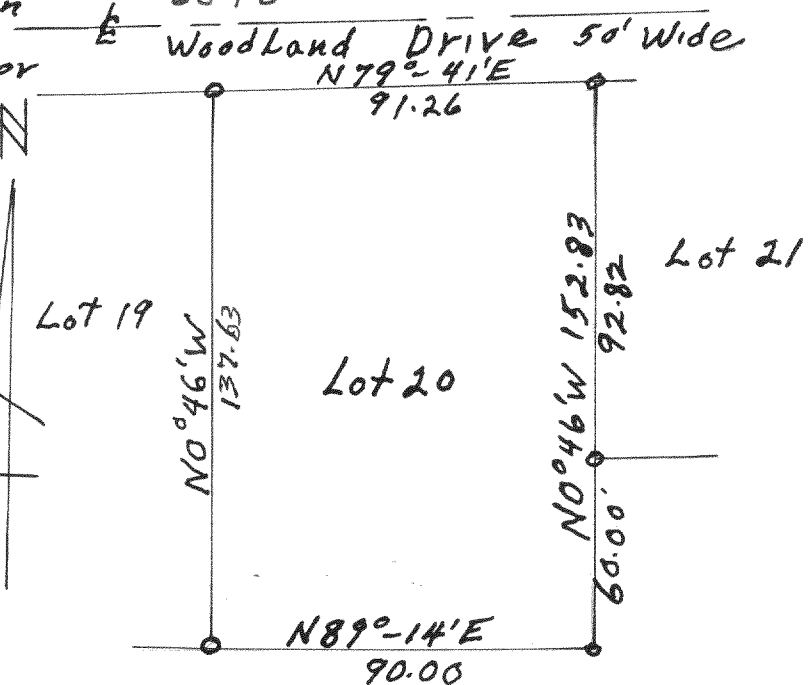

#3845

Plat of survey of Lot 22, add. E To Country Club Estates, Village of Fontana, Walworth County Wisconsin
April Lloyd L. Jensen
1959 County Surveyor

