



Plat of Survey of Land
in the SE 1/4 of Sec. 32
TIN RIG'E Walworth
County Wisconsin
May 1959 Lloyd L. Jensen
County Surveyor

#3870

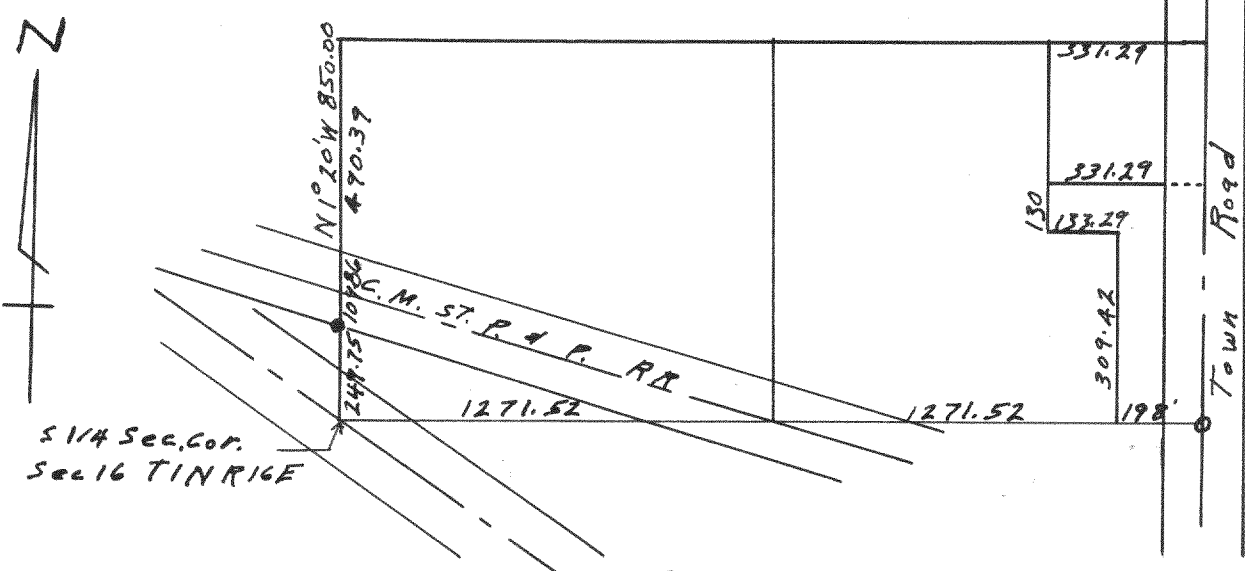


Plat of Survey of Land
Located in the SE 1/4 of
Sec. 16, TIN RIG'E
Walworth County Wisconsin
Lloyd L. Jensen
County Surveyor

#3871

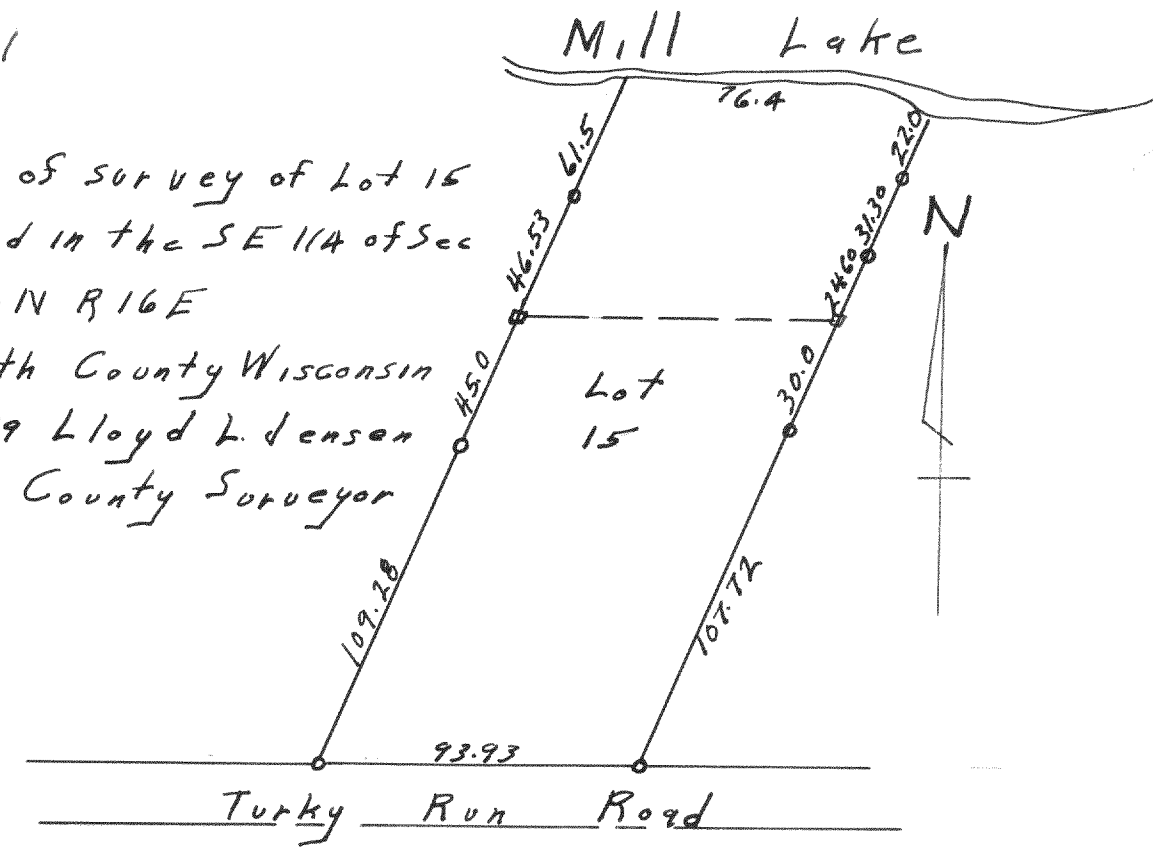


Plat of Survey of Lot 15
Located in the SE 1/4 of Sec
35, TAN RIG'E
Walworth County Wisconsin
Mar 1959 Lloyd L. Jensen
County Surveyor

#3872

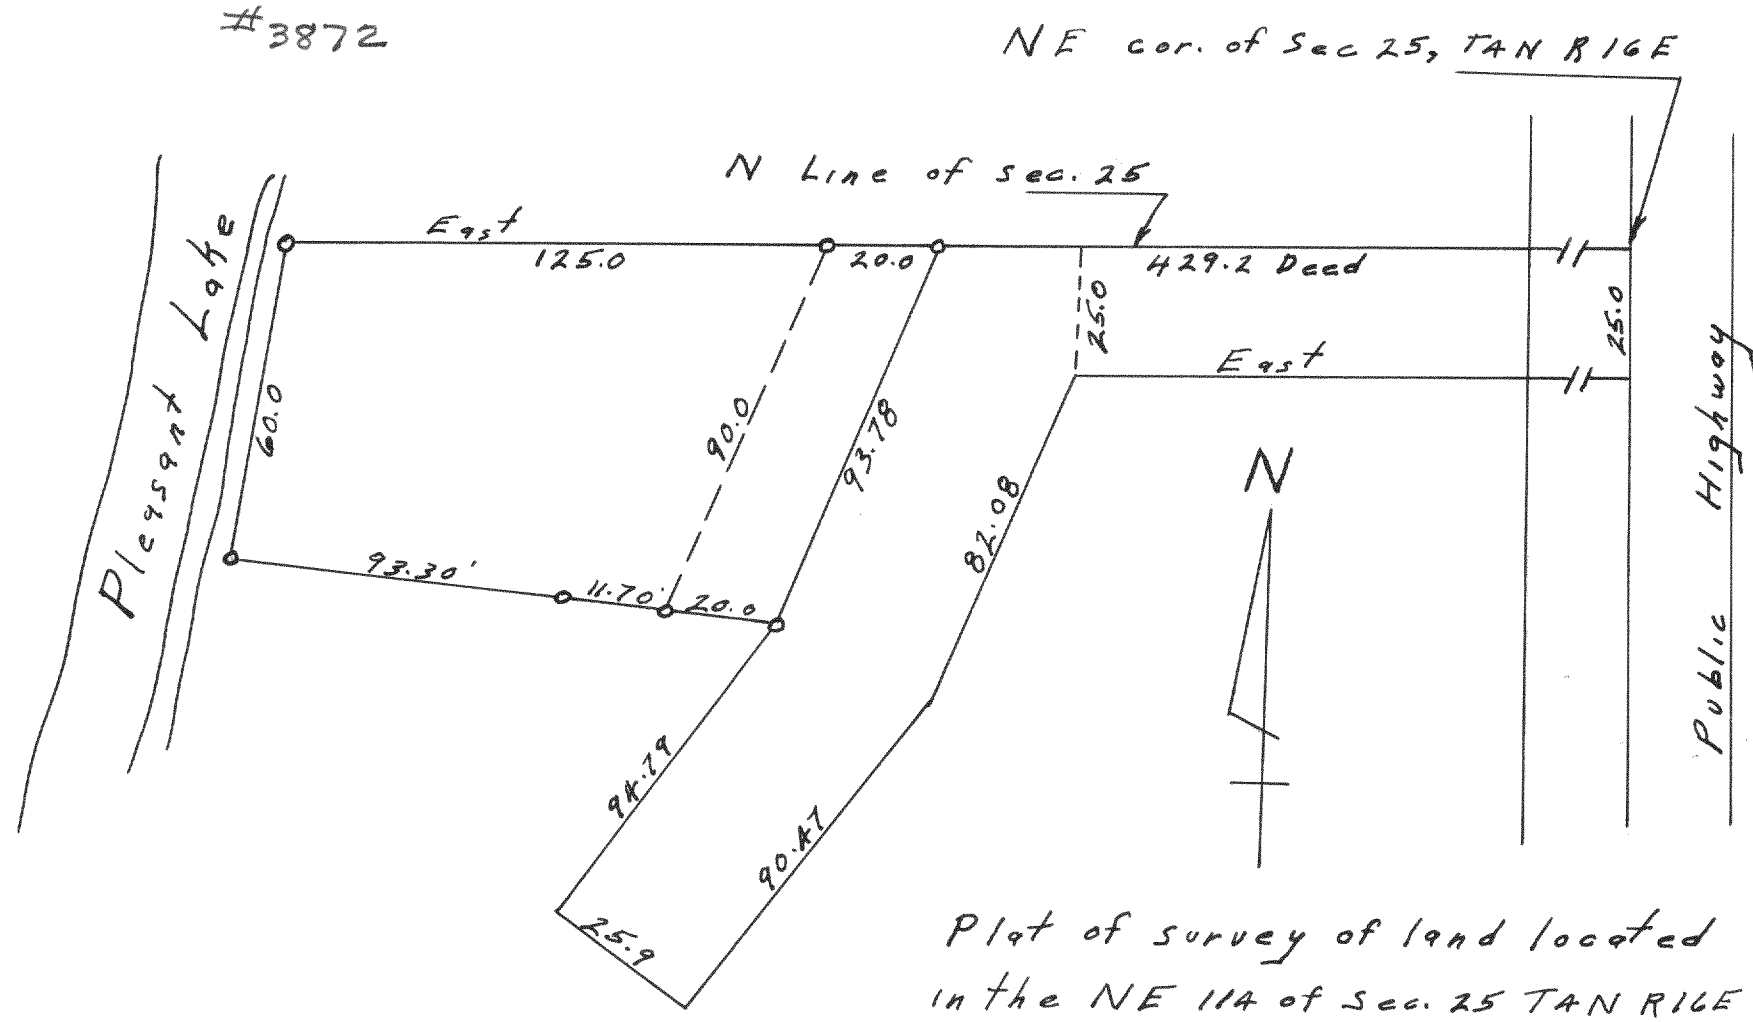

Plat of Survey of Land located
in the NE 1/4 of Sec. 25 TAN RIG'E
Walworth County Wisconsin
June 1959 Lloyd L. Jensen
County Surveyor

#3873

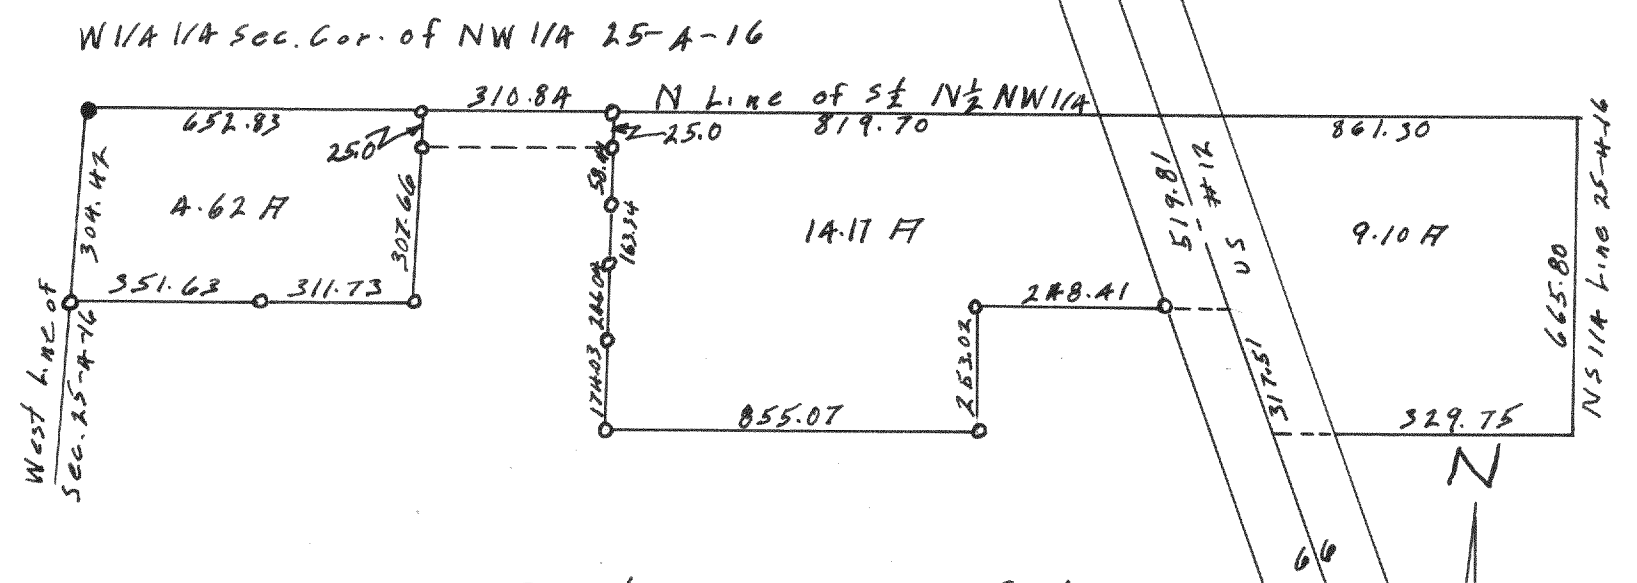

Plat of Survey of Land
in the NW 1/4 Sec. 25, TAN RIG'E
Walworth County Wisconsin
June 1959 Lloyd L. Jensen
County Surveyor