



Survey of part of 1, 2 + 3, Block 27.  
Original Plat City of Lake Geneva  
Date 9-17-60 Lloyd S. Jensen  
(County Surveyor)

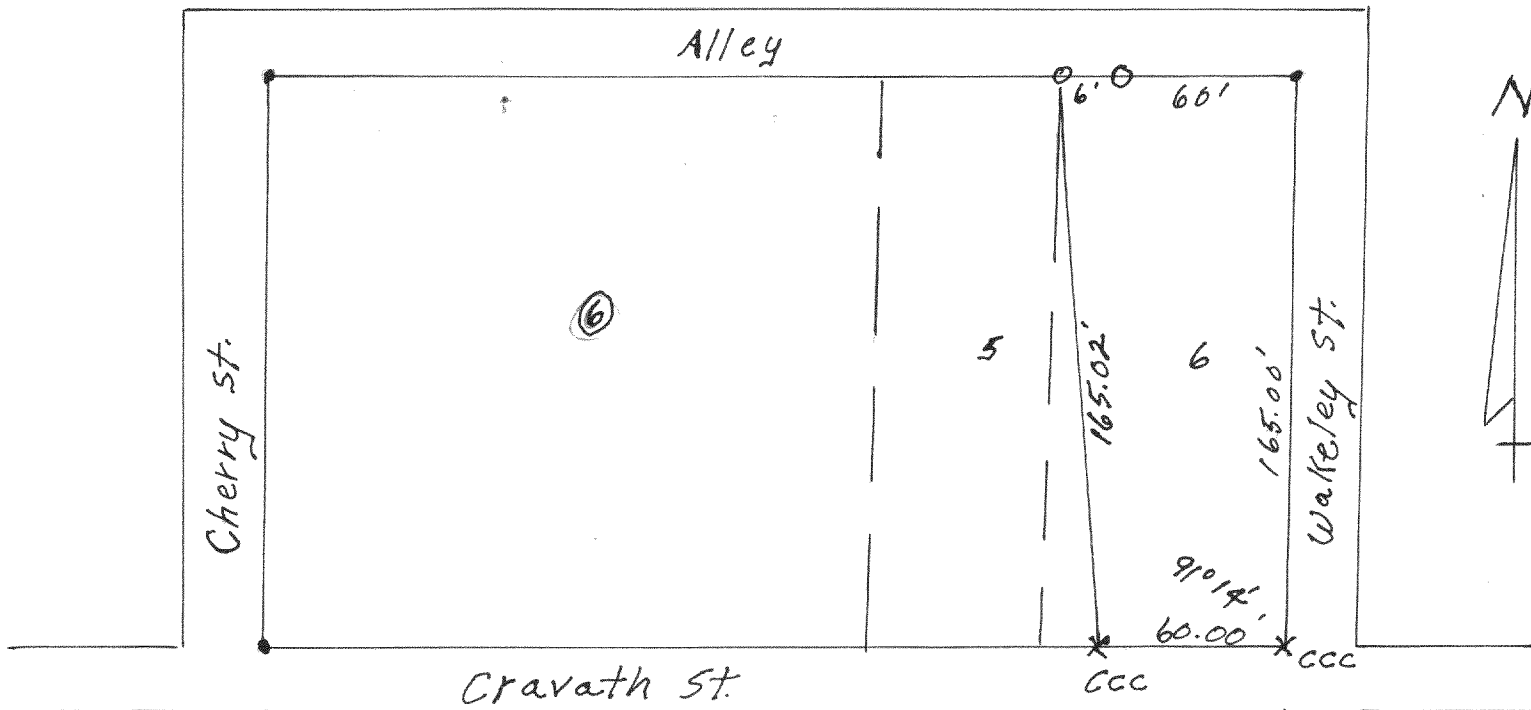

Survey of part of Lot 6, Block 6, Dann's  
Add. to the City of Whitewater  
Date 6-28-60 Lloyd S. Jensen  
(County Surveyor)

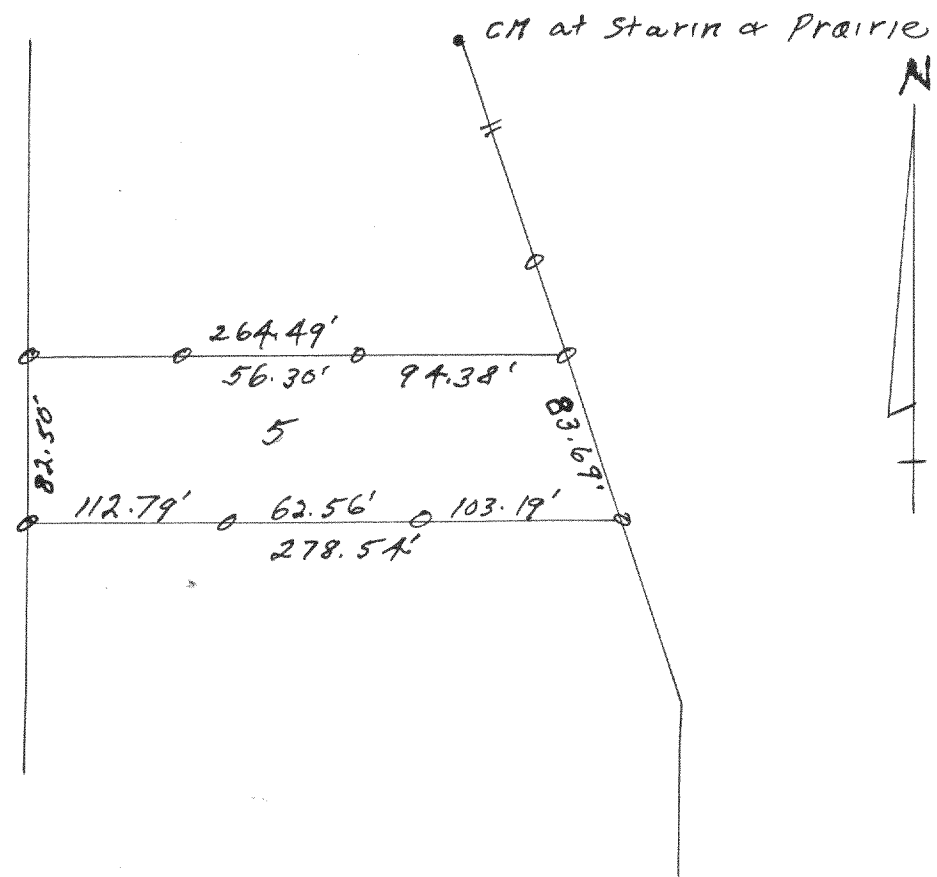

Survey of Part of Lot 5, F.L. Pratt's Add.  
to the City of Whitewater  
Date 8-8-60 Lloyd S. Jensen  
(County Surveyor)