




#4003
10
11
Survey of Alley between blocks 10+11, original Plat at the Village of Fontana on Geneva Lake Date Aug. 1960
Lloyd L Jensen
(County Surveyor)

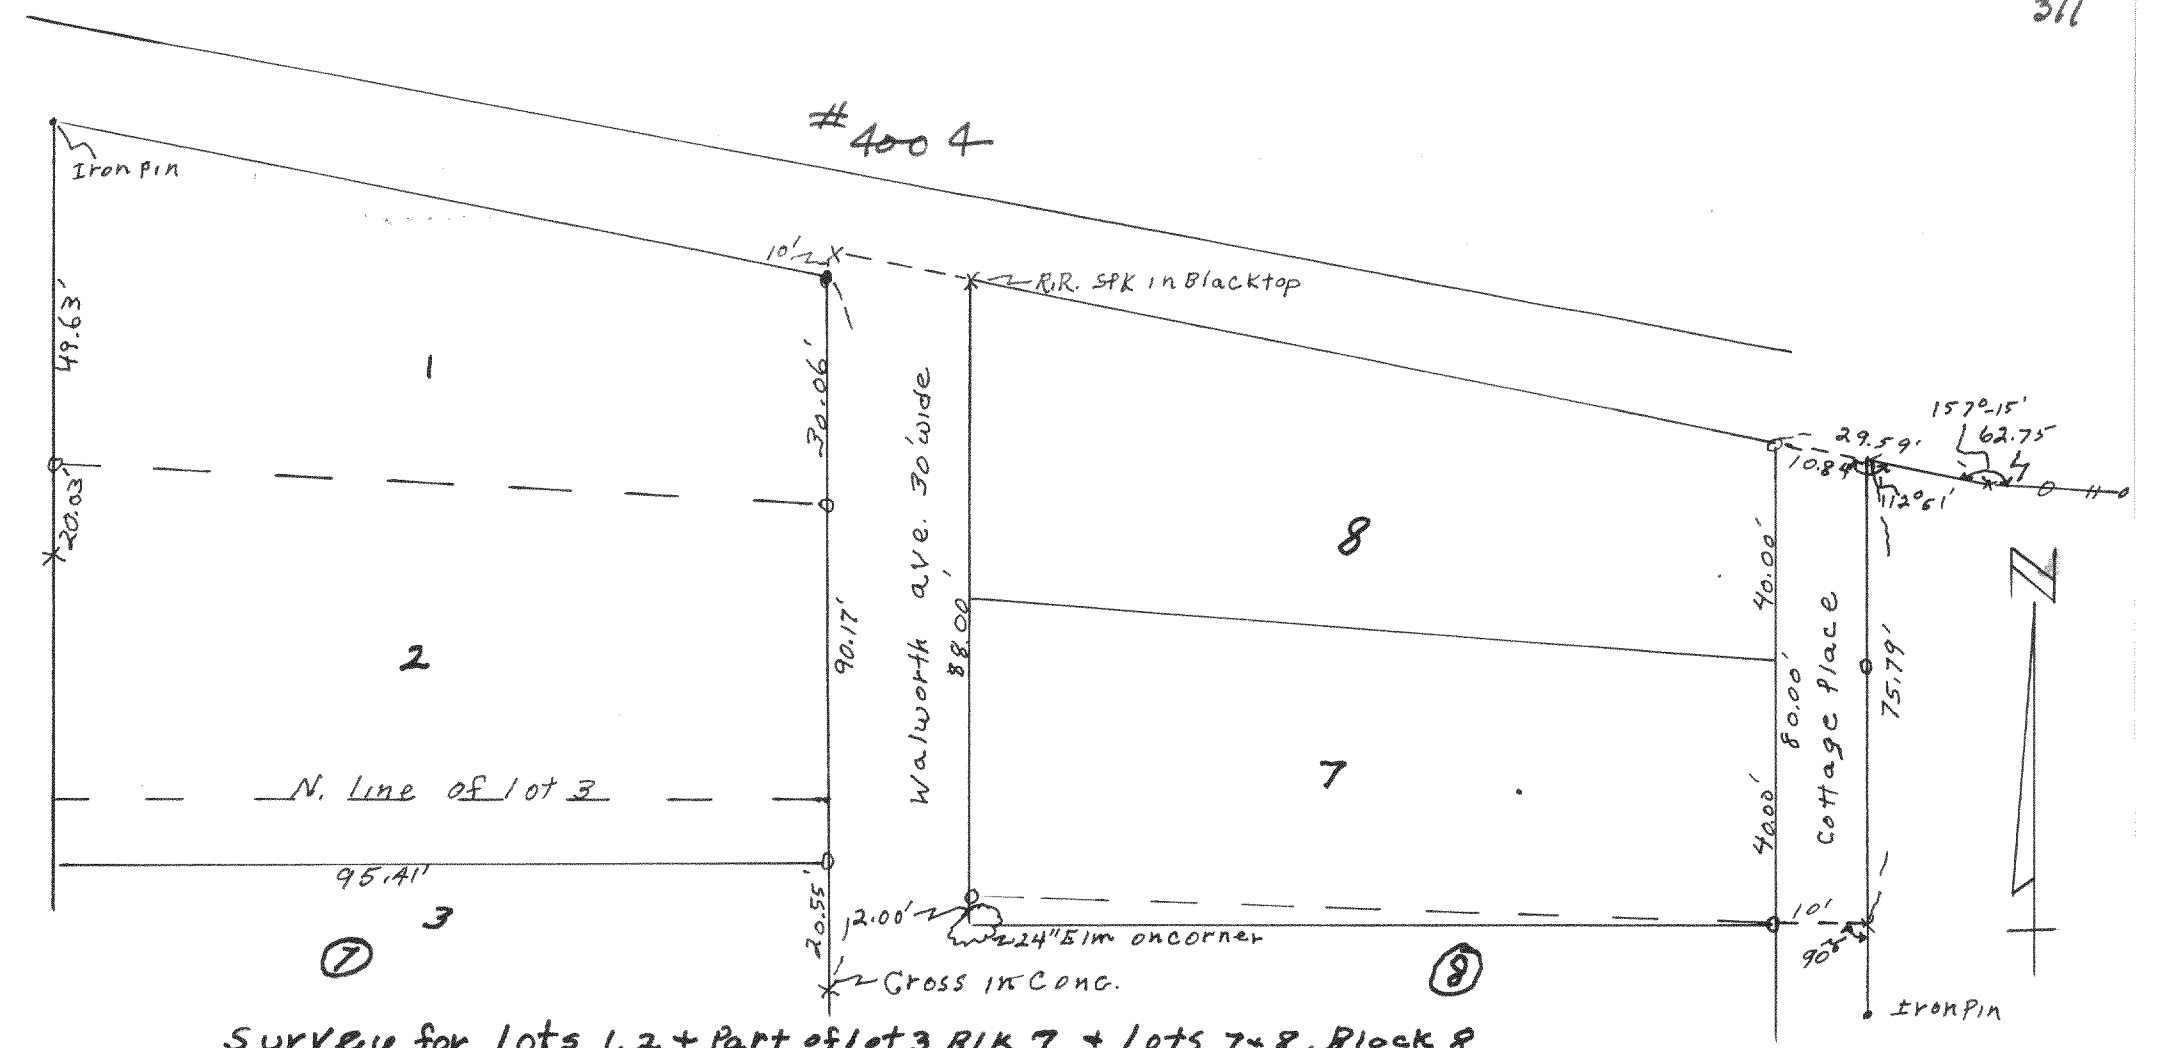

#4004
Survey for lots 1, 2 + part of lot 3 BIK 7 + lots 7+8, Block 8
Glenwood Springs, Village of Fontana Date 8-13-60
Lloyd L Jensen
(County Surveyor)

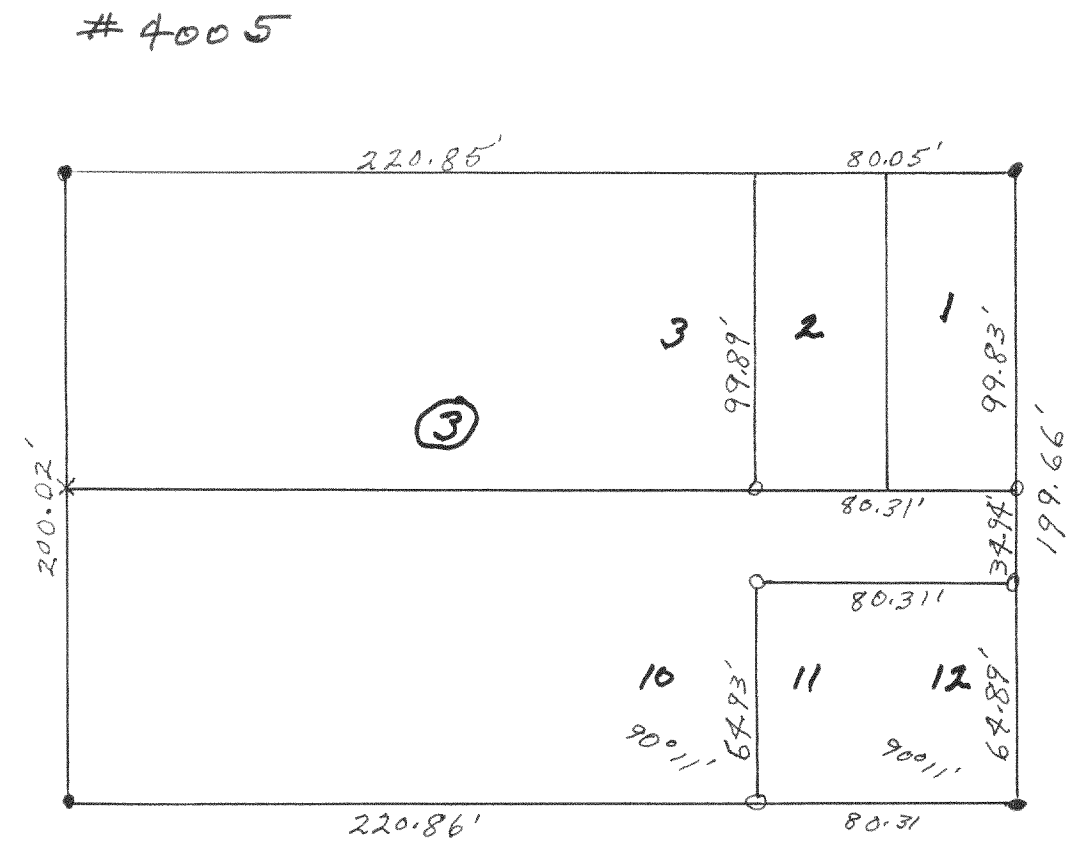

#4005
Survey of Lots 11+12, Block 3, D. A. Reid's Add, Village of Fontana
Date 7-7-61
Lloyd L Jensen
(County Surveyor)

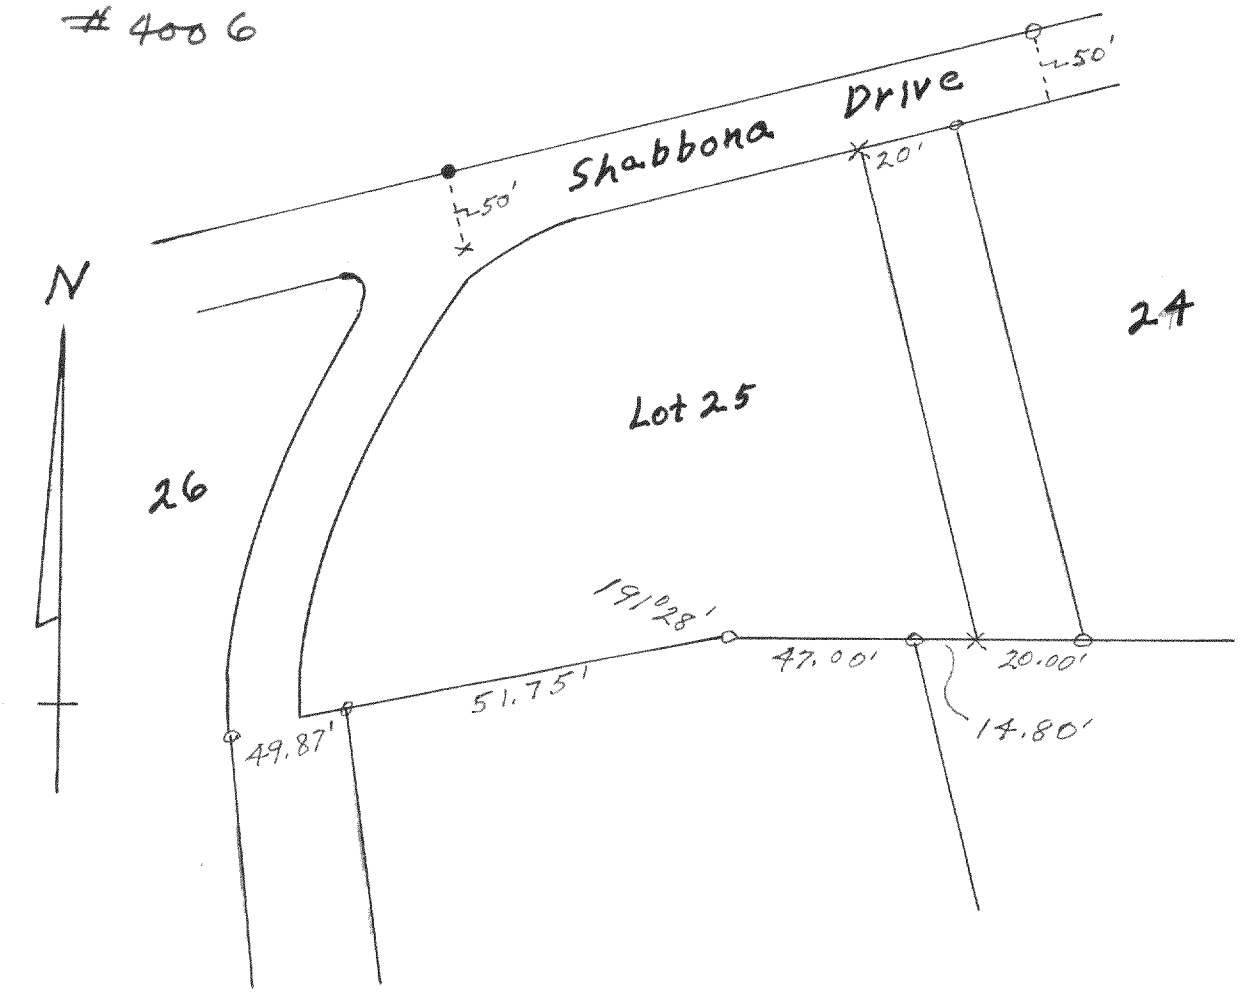

#4006
Survey of Lot 25, Unit 1, Country Club Estates, Village of Fontana - on Geneva Lake
Date 4-19-60
Lloyd L Jensen
(County Surveyor)