


# 4363

PLAT OF SURVEY  
OF  
A PARCEL LOCATED IN  
SEC. 24 TAN R16E WAL. CO. WIS.  
OCT. 1965


*Lloyd L Jensen*  
LLOYD L. JENSEN  
CO. SURVEYOR

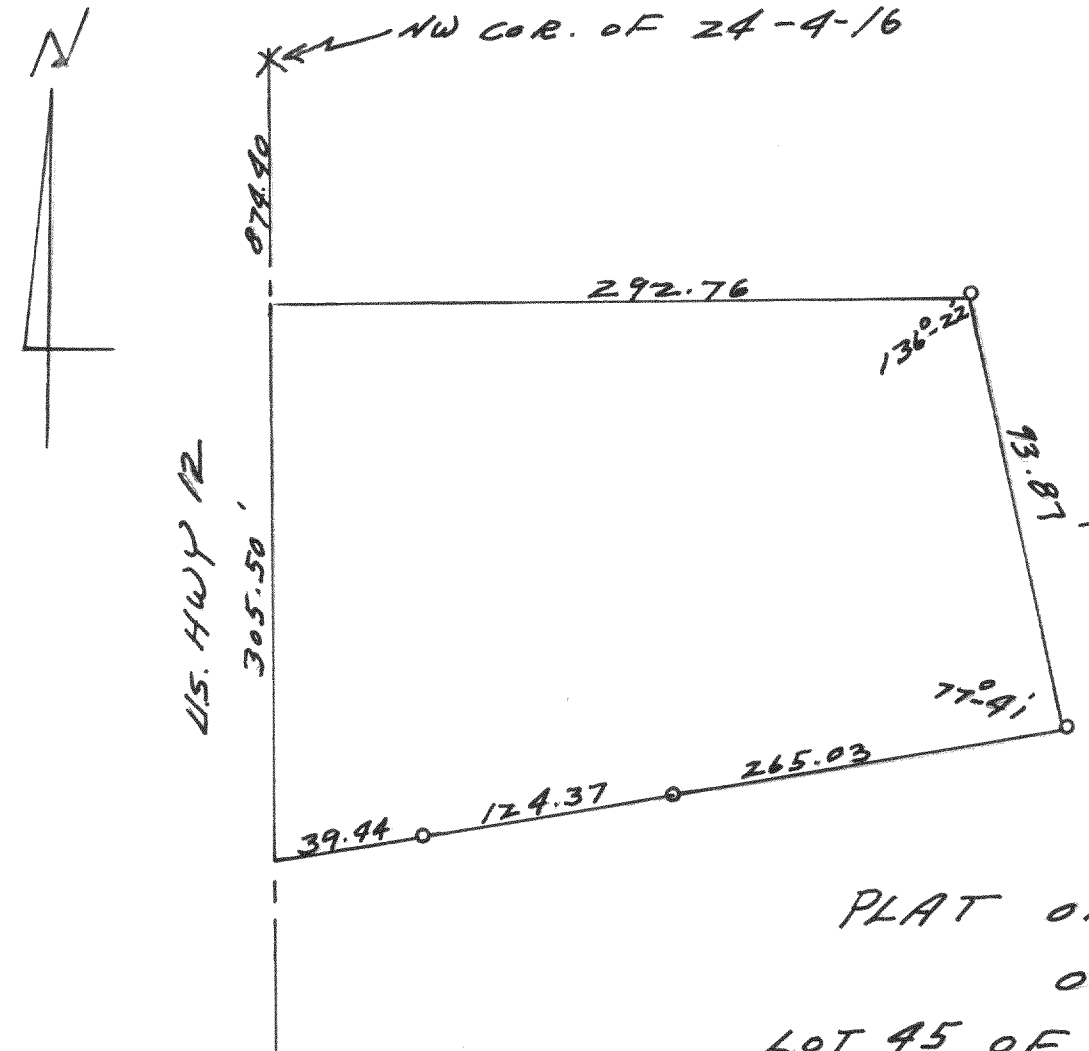

PLAT OF SURVEY  
OF  
LOT 45 OF THE BIRCHE 1ST ADD  
SEC 9 E10 T16R16E WAL. CO. WIS.  
OCT 1965

#4364

*Lloyd L Jensen*  
CO. SURVEYOR

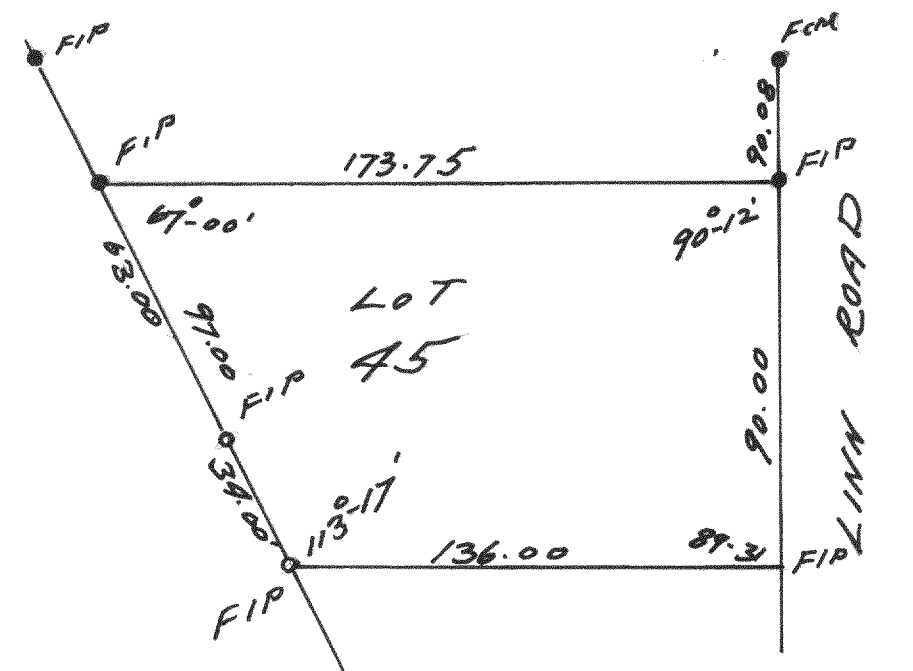

~~531~~  
531

#4365

PLAT OF SURVEY  
OF  
LOT #9 & THE WEST 10' OF LOT #10  
1ST ADD. TO LAUDERDALE PARK  
SEC. 25, TAN R16E WAL. CO. WIS.  
JUNE 1965

*Lloyd L Jensen*  
CO. SURVEYOR

