

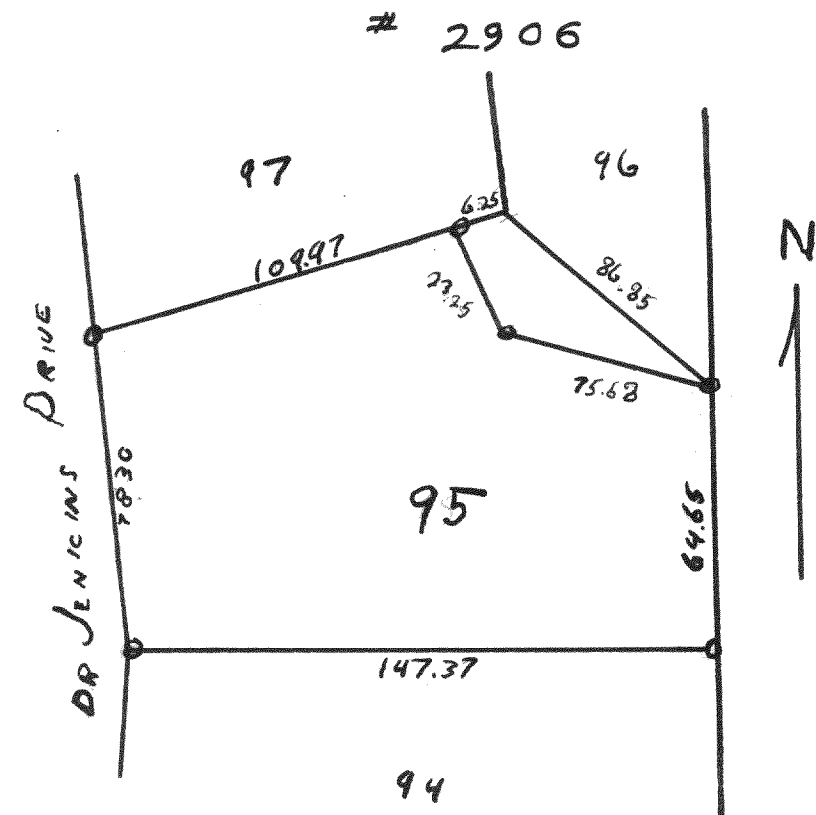


Plat of Survey of Lots 6-7, Block 14
Glenwood Springs Village of Fontana-on-
Geneva Lake, Walworth County, Wis
Aug 1954
Lloyd L. Jones
Surveyor

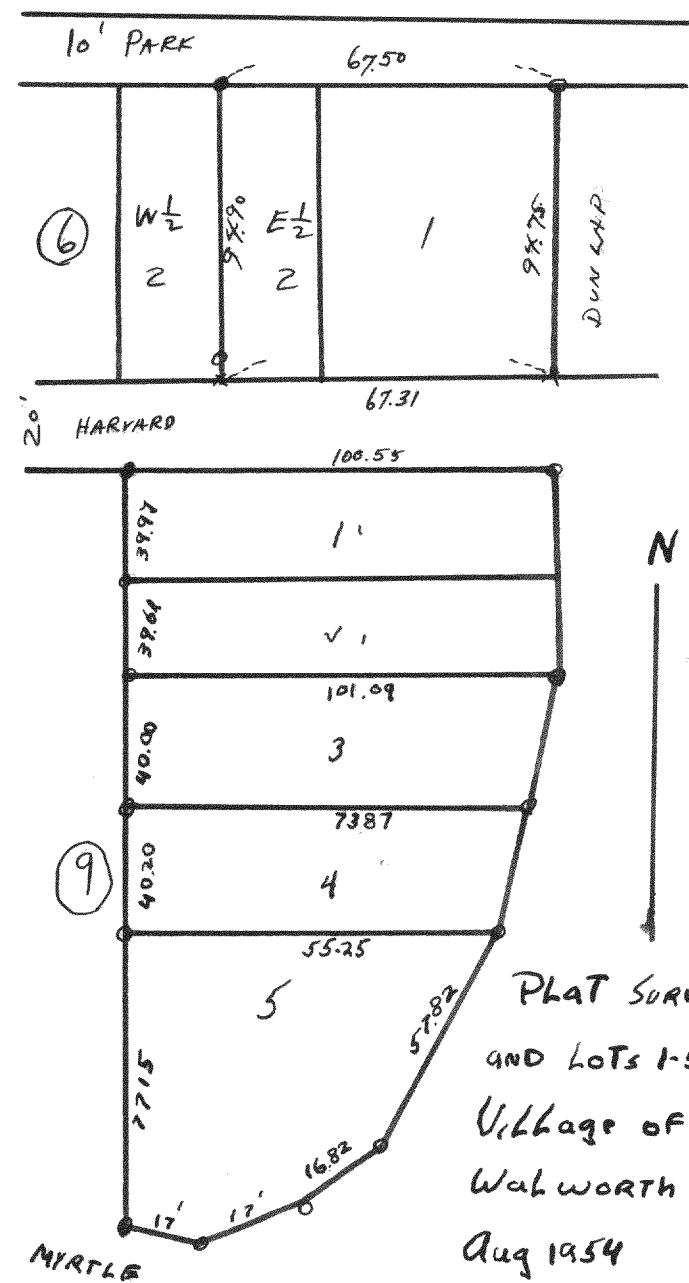


Plat of Survey of Lot 95 Unit II
Country Club Estates Village of Fontana
on Geneva Lake Walworth County Wisconsin
Oct 1954
LLJ
CS

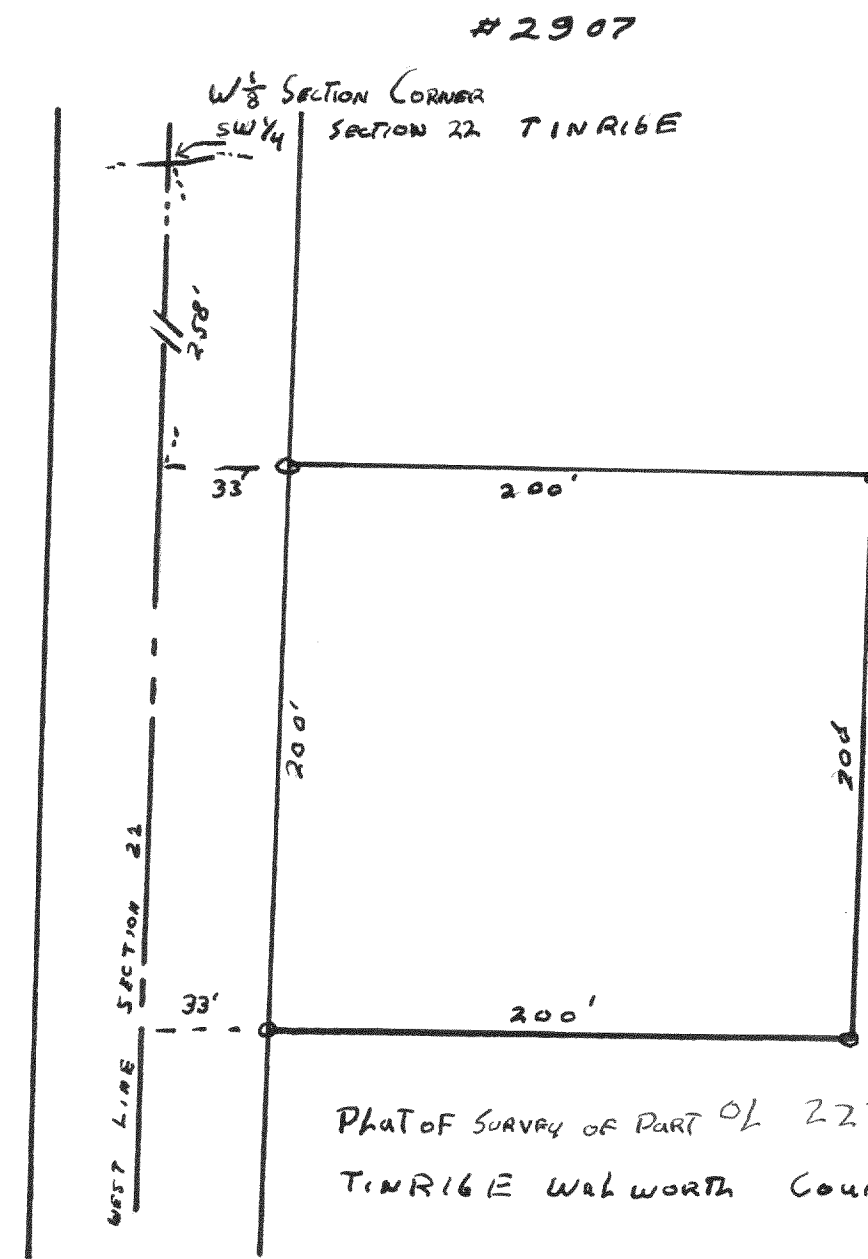

Plat Survey of Lot 1 and E 1/2 Cor 2 Block 6
and Lots 1-5 Block 9 Glenwood Springs
Village of Fontana Geneva Lake
Walworth County Wisconsin
Aug 1954
LLJ
CS

#2908

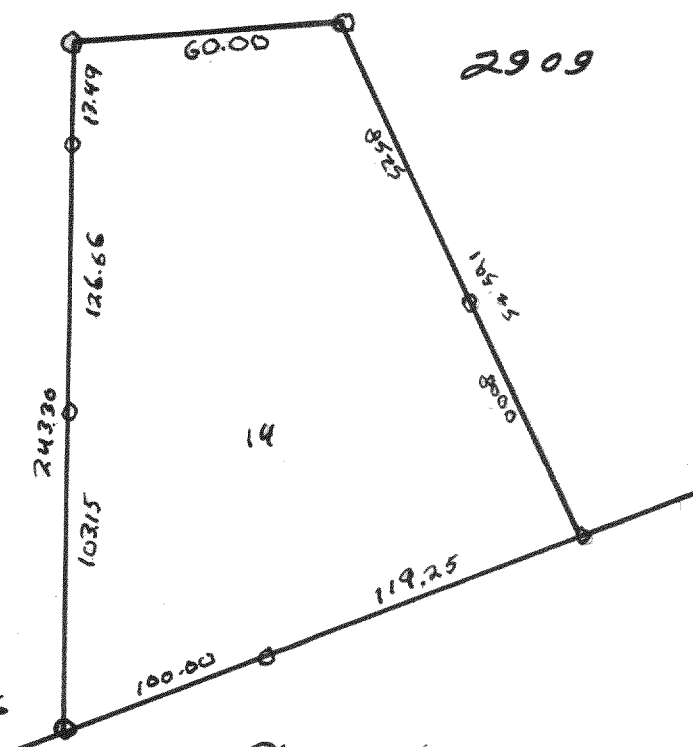

Plat of Survey of Lot 14 Unit #1
Country Club Estates Village of Fontana
on Geneva Lake Walworth County Wisconsin
October 1954
LLJ
CS