


PLAT OF SURVEY #4575
 SEC 9
 LOTS 9 + 10 MCGRAW'S PARK
 TANRIBE WAL. COUNTY, WIS.
 JULY 1966
 Lloyd & Jensen
 COUNTY SURVEYOR

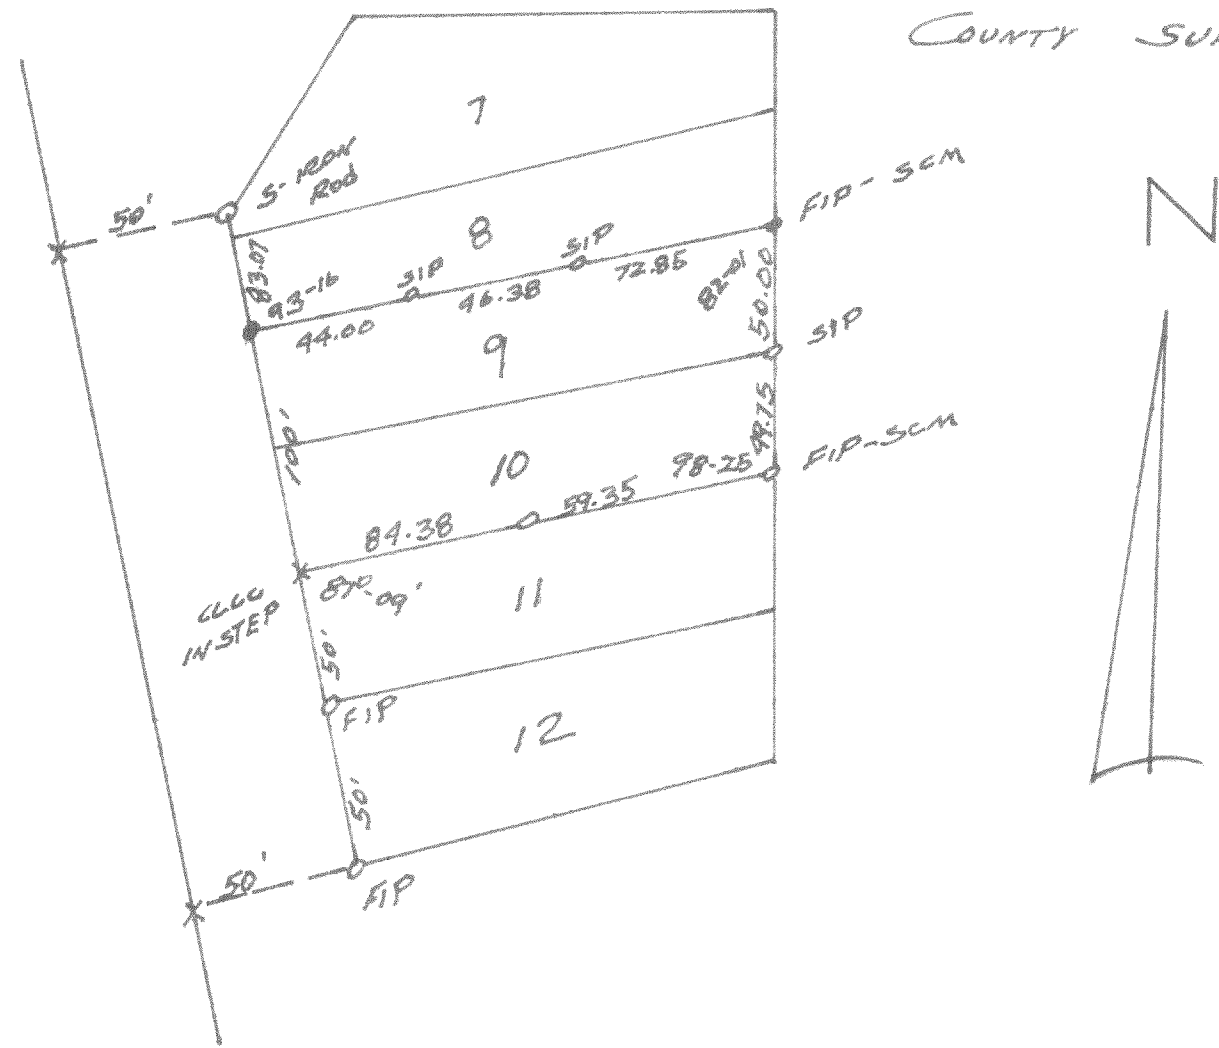

#4576
 695
 PLAT OF SURVEY
 OF

A PARCEL OF LAND LOCATED IN THE
 W 1/2 OF SECTION 23, TAN, RIBE,
 WALWORTH COUNTY, WISCONSIN.

JUNE 1968
 Lloyd & Jensen
 COUNTY SURVEYOR

