



PLAT OF SURVEY OF LOT 6 OF ADDITION D TO COUNTRY CLUB ESTATES LOCATED IN THE VILLAGE OF FONTANA-ON-GENEVA LAKE WALWORTH COUNTY, WISCONSIN
 NOVEMBER 1954
 LLOYD L. JENSEN
 SA.
 COUNTY SURVEYOR

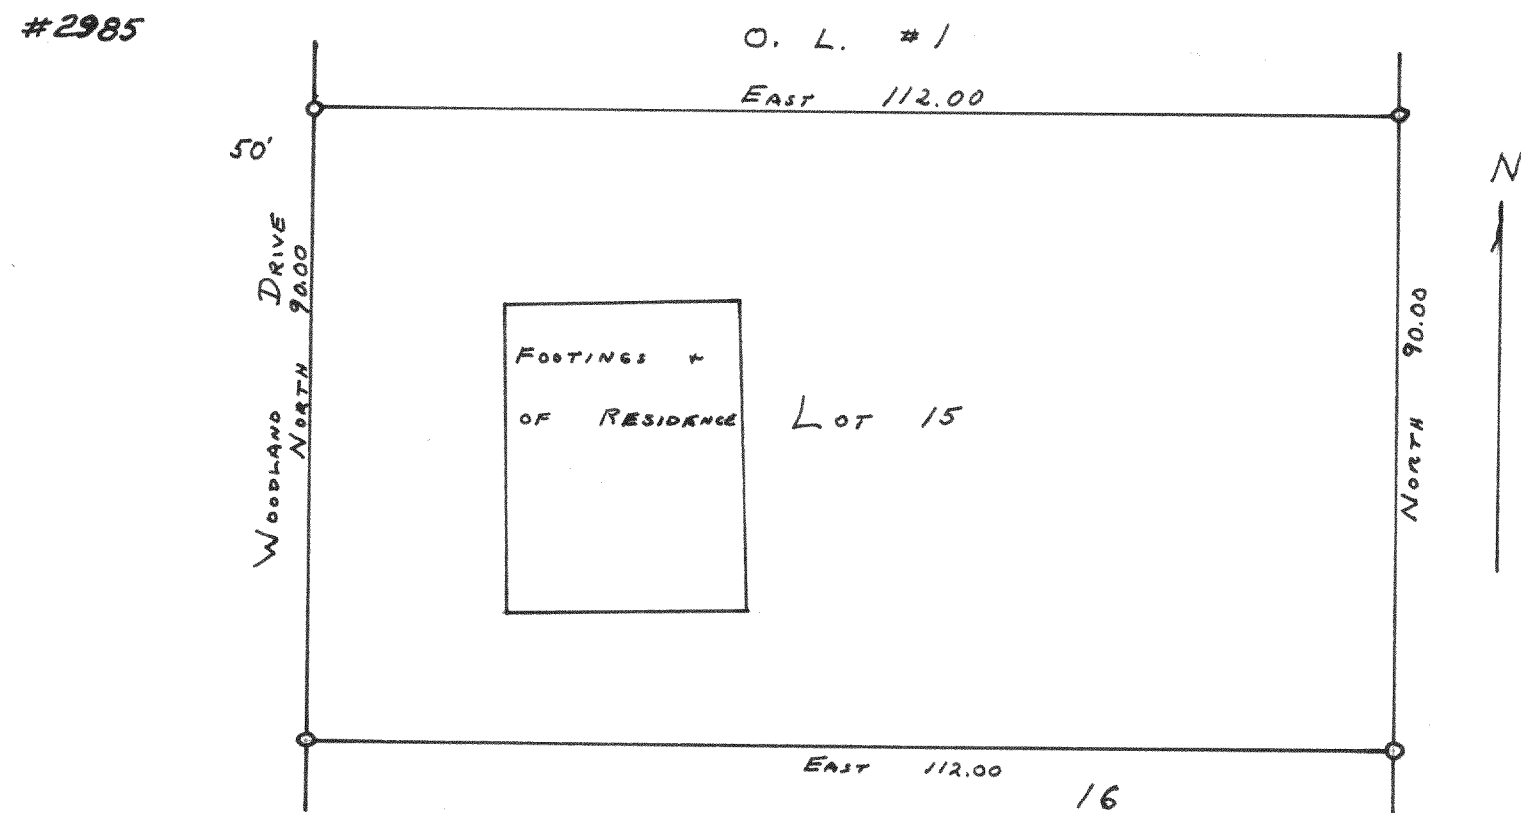

PLAT OF SURVEY OF LOT 15 OF ADDITION D TO COUNTRY CLUB ESTATES LOCATED IN THE VILLAGE OF FONTANA-ON-GENEVA LAKE WALWORTH COUNTY, WISCONSIN.
 NOVEMBER 1954
 LLOYD L. JENSEN
 SA.
 COUNTY SURVEYOR

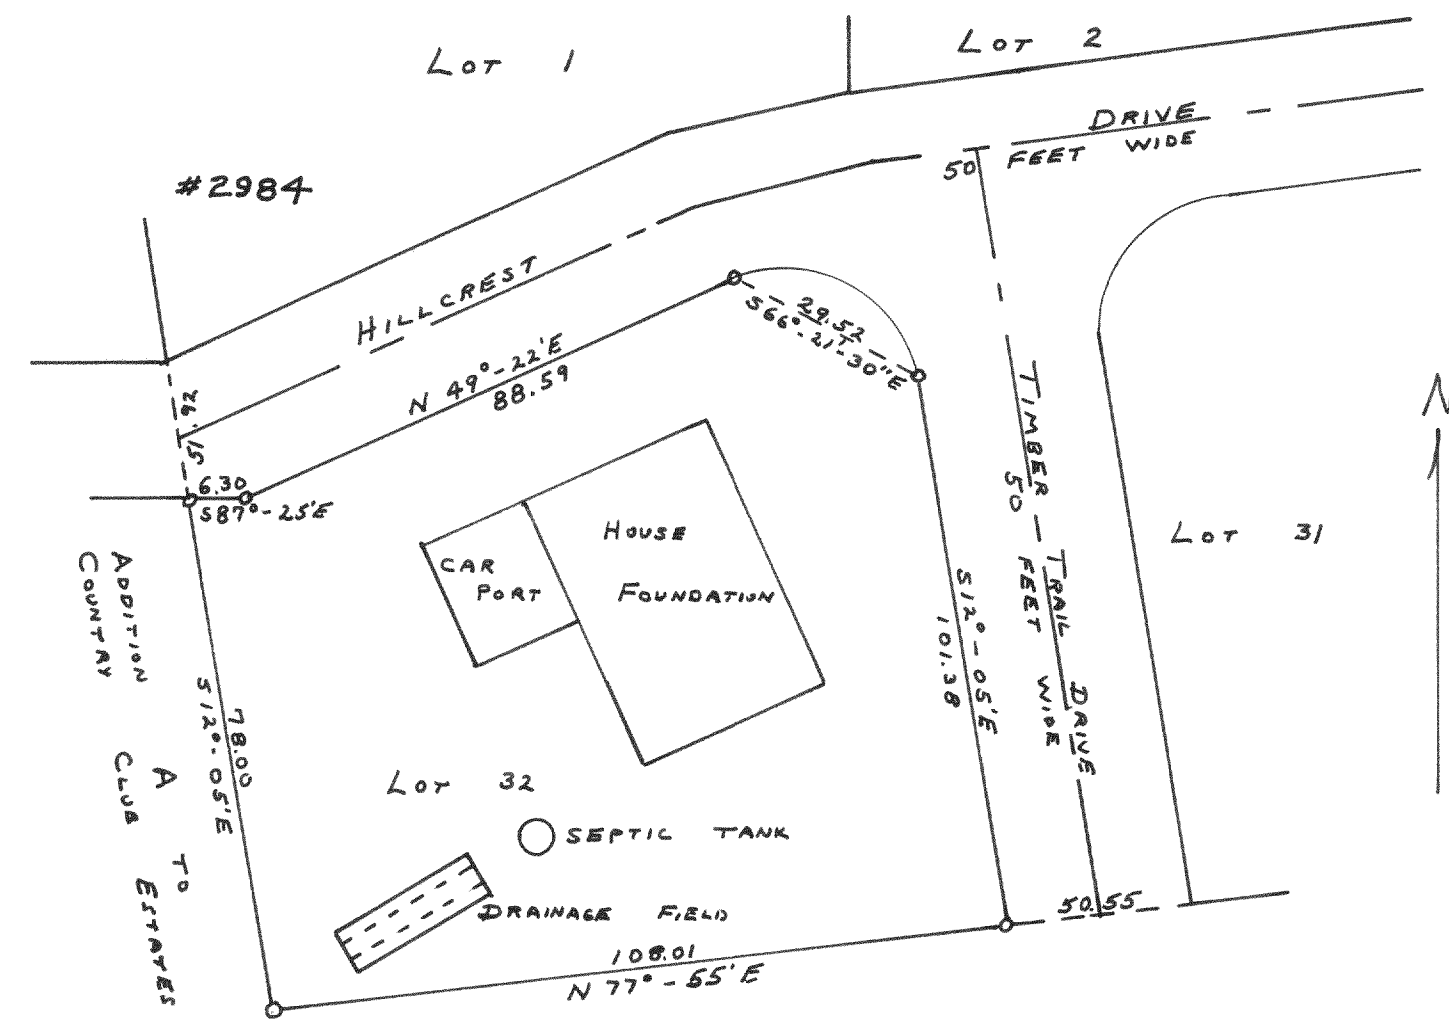

O.L. 98
 PLAT OF SURVEY OF LOT 32 OF ADDITION "D" TO COUNTRY CLUB ESTATES LOCATED IN THE VILLAGE OF FONTANA-ON-GENEVA LAKE WALWORTH COUNTY, WISCONSIN.
 DECEMBER 1954
 LLOYD L. JENSEN
 SA.
 COUNTY SURVEYOR



PLAT OF SURVEY OF LOT 27 ADDITION D TO COUNTRY CLUB ESTATES VILLAGE OF FONTANA WALWORTH COUNTY WIS
 Nov 1954
 Lloyd L. Jensen
 County Surveyor