



LOTS 8172 TO 8181  
SECTION 5 OF PELL LAKE  
WALWORTH COUNTY WISCONSIN  
LLOYD L. JENSEN  
COUNTY SURVEYOR  
APRIL 1956  
P.J.

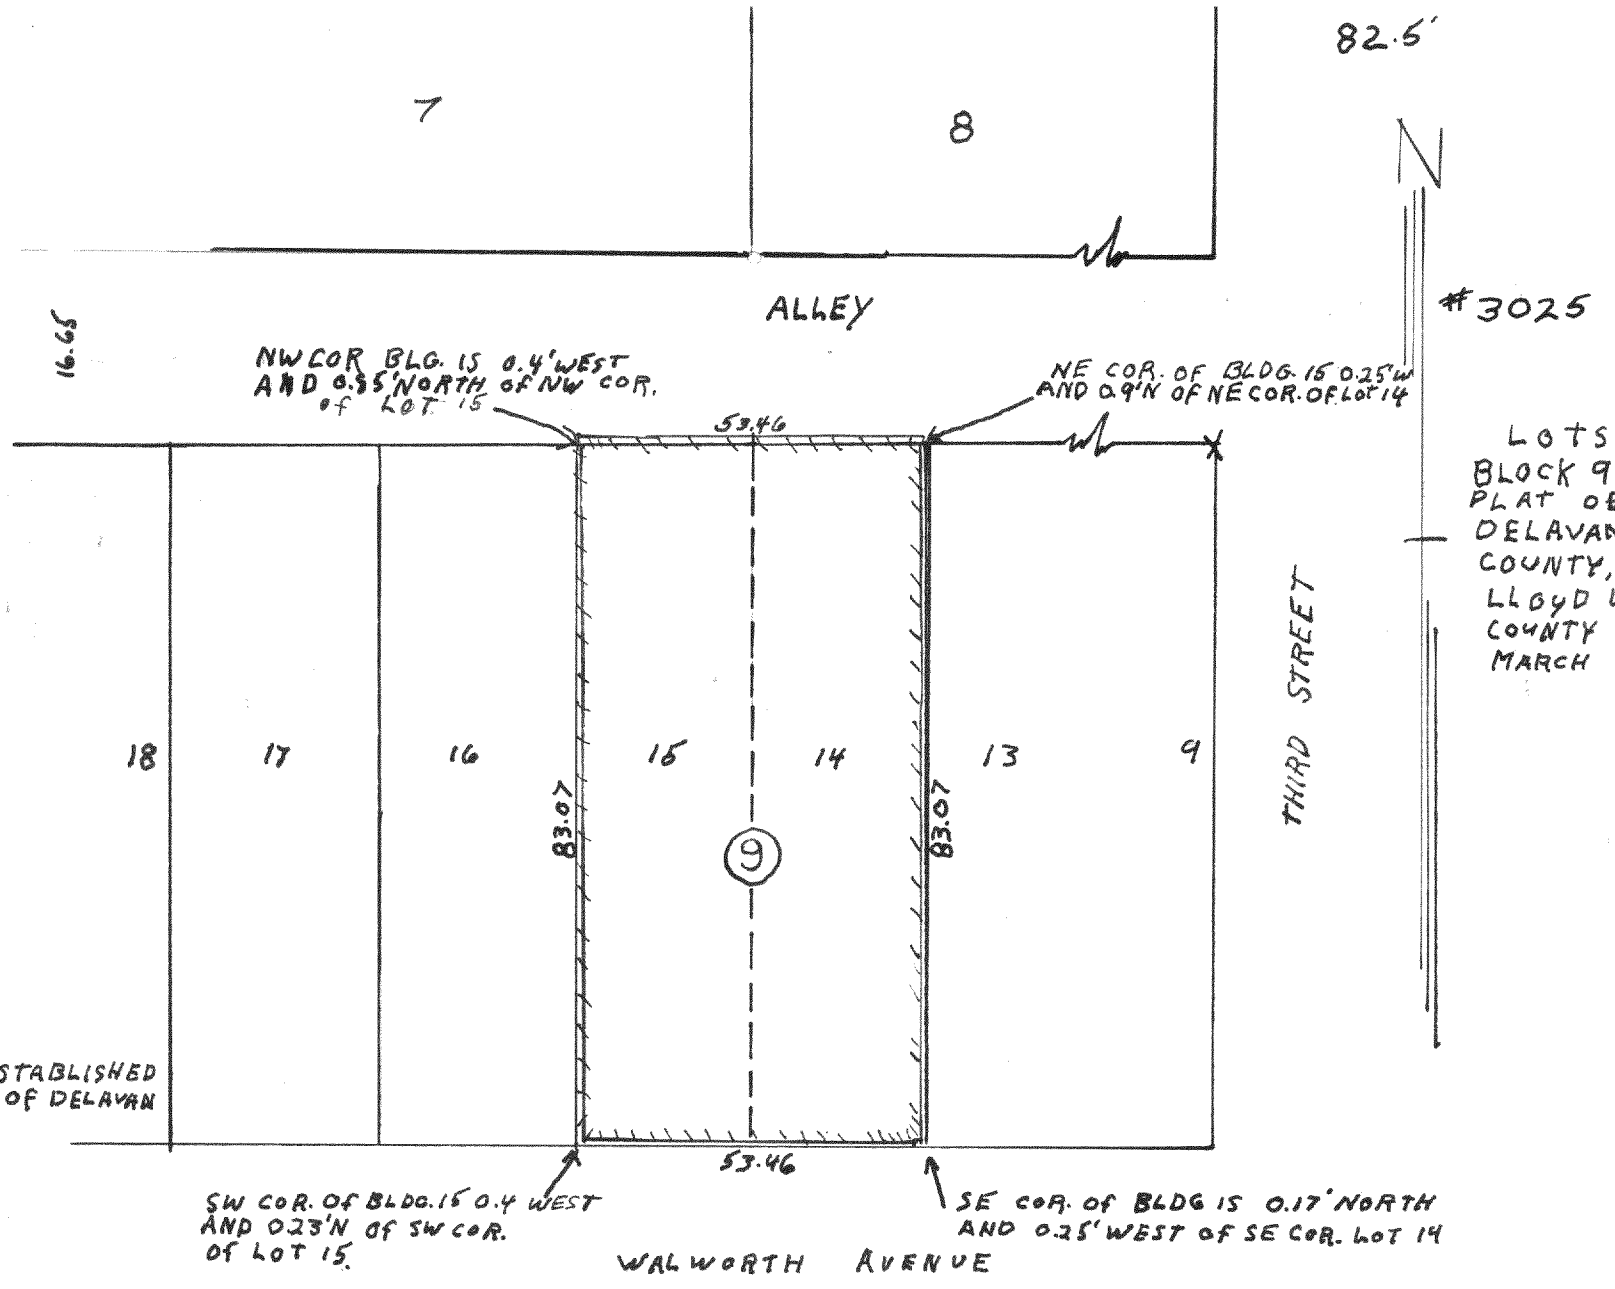

LOTS 14 AND 15 OF  
BLOCK 9 OF THE ORIGINAL  
PLAT OF THE CITY OF  
DELAVER, WALWORTH  
COUNTY, WISCONSIN  
LLOYD L. JENSEN  
COUNTY SURVEYOR  
MARCH 1955

POINTS ESTABLISHED  
USING CITY OF DELAVER  
PLAT

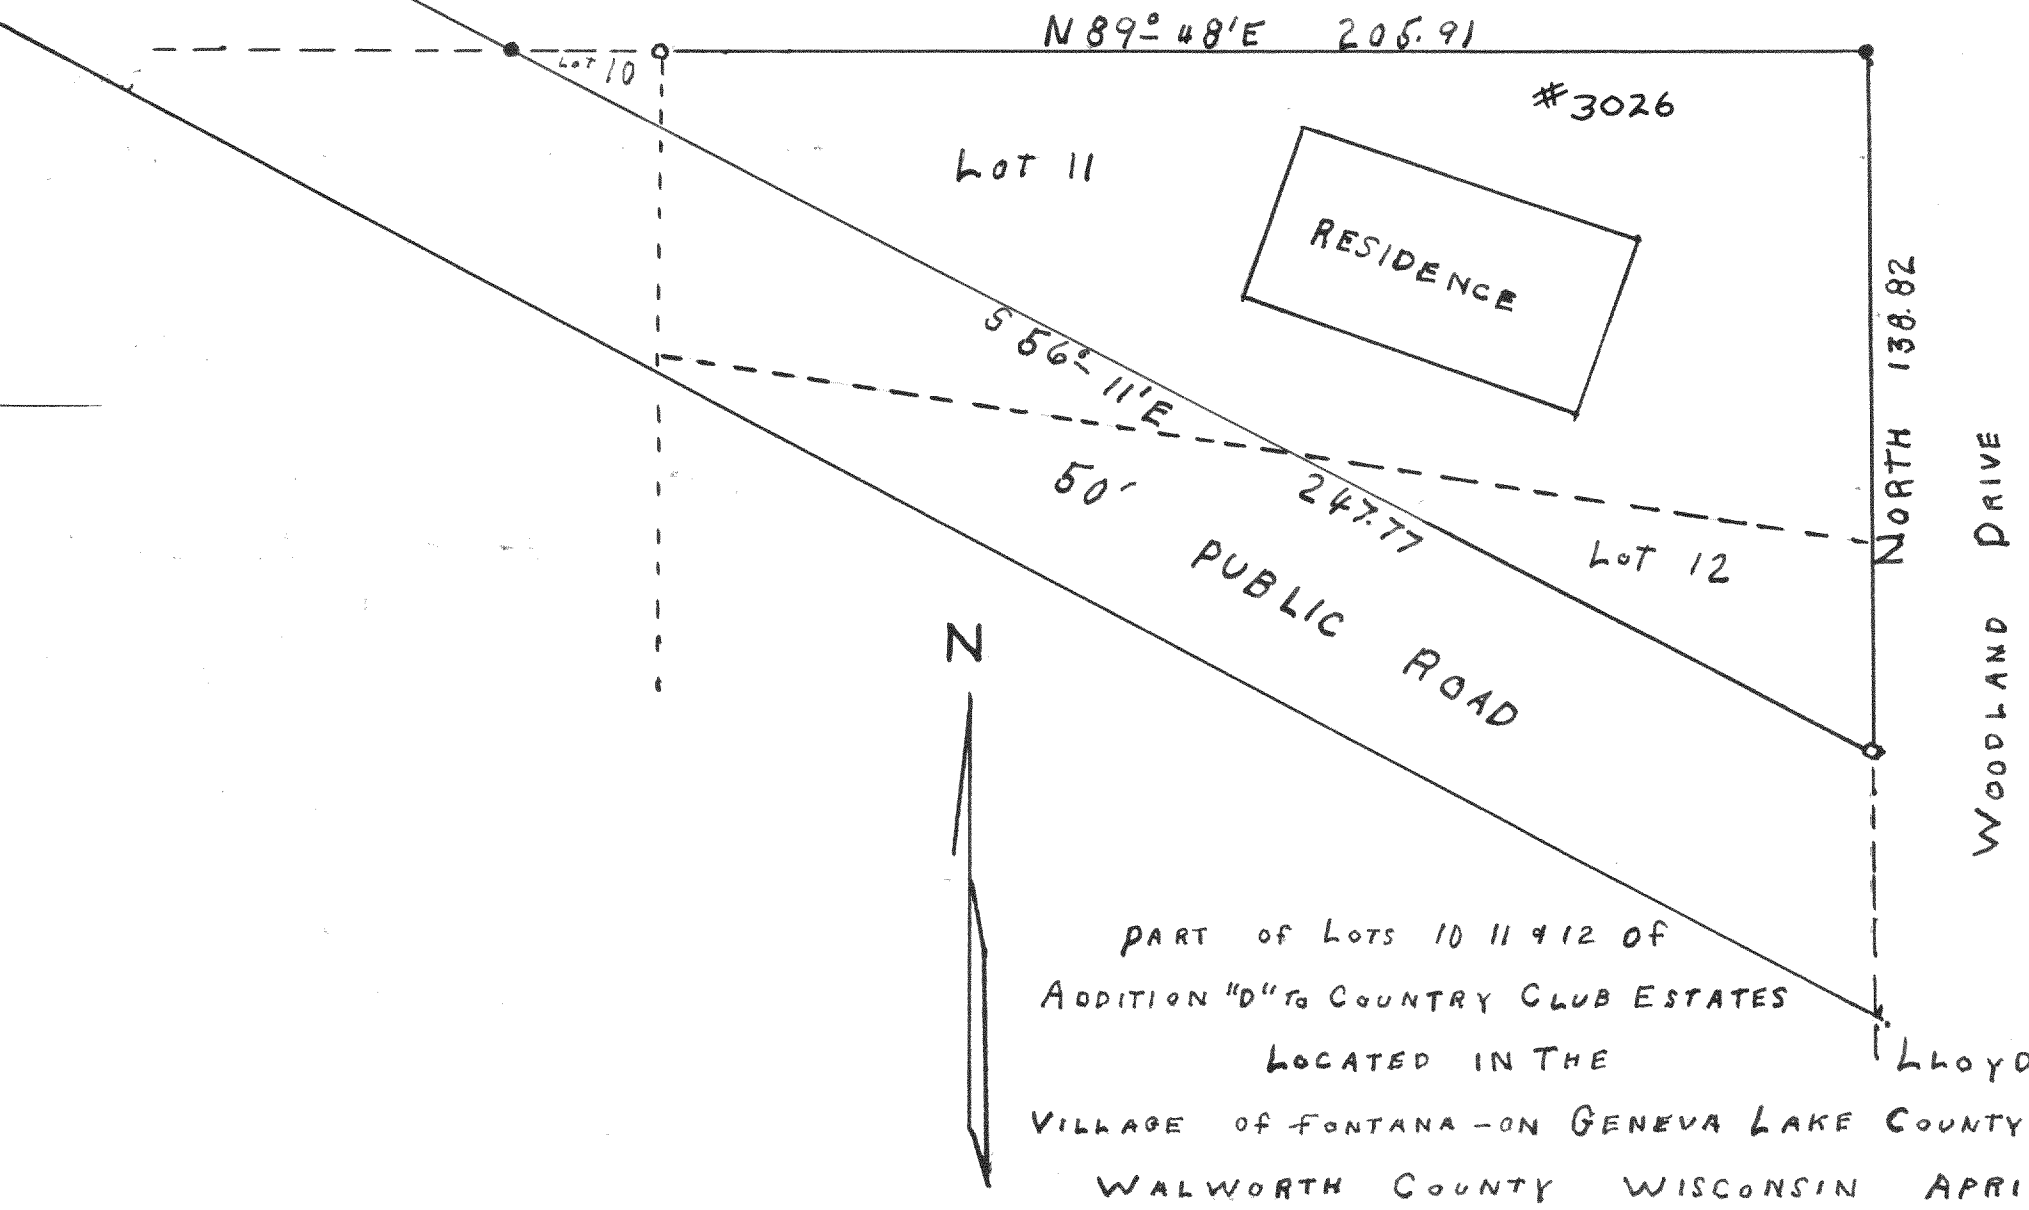

PART OF LOTS 10 11 & 12 OF  
ADDITION "D" TO COUNTRY CLUB ESTATES  
LOCATED IN THE  
VILLAGE OF FONTANA - ON GENEVA LAKE COUNTY SURVEYOR  
WALWORTH COUNTY WISCONSIN APRIL 1956  
LLOYD L. JENSEN