


LOT 10 OF STEARNS & GEROULD'S
 SUBDIVISION LOCATED IN FONTANA
 ON GENEVA LAKE, WISCONSIN
 DEC. 1955
 LLOYD L. JENSEN
 COUNTY SURVEYOR



LOT 27 OF ADDITION "E" TO
 COUNTRY CLUB ESTATES LOCATED
 IN VILLAGE OF FONTANA, WALWORTH
 COUNTY, WISCONSIN
 JULY 1955
 LLOYD L. JENSEN
 COUNTY SURVEYOR

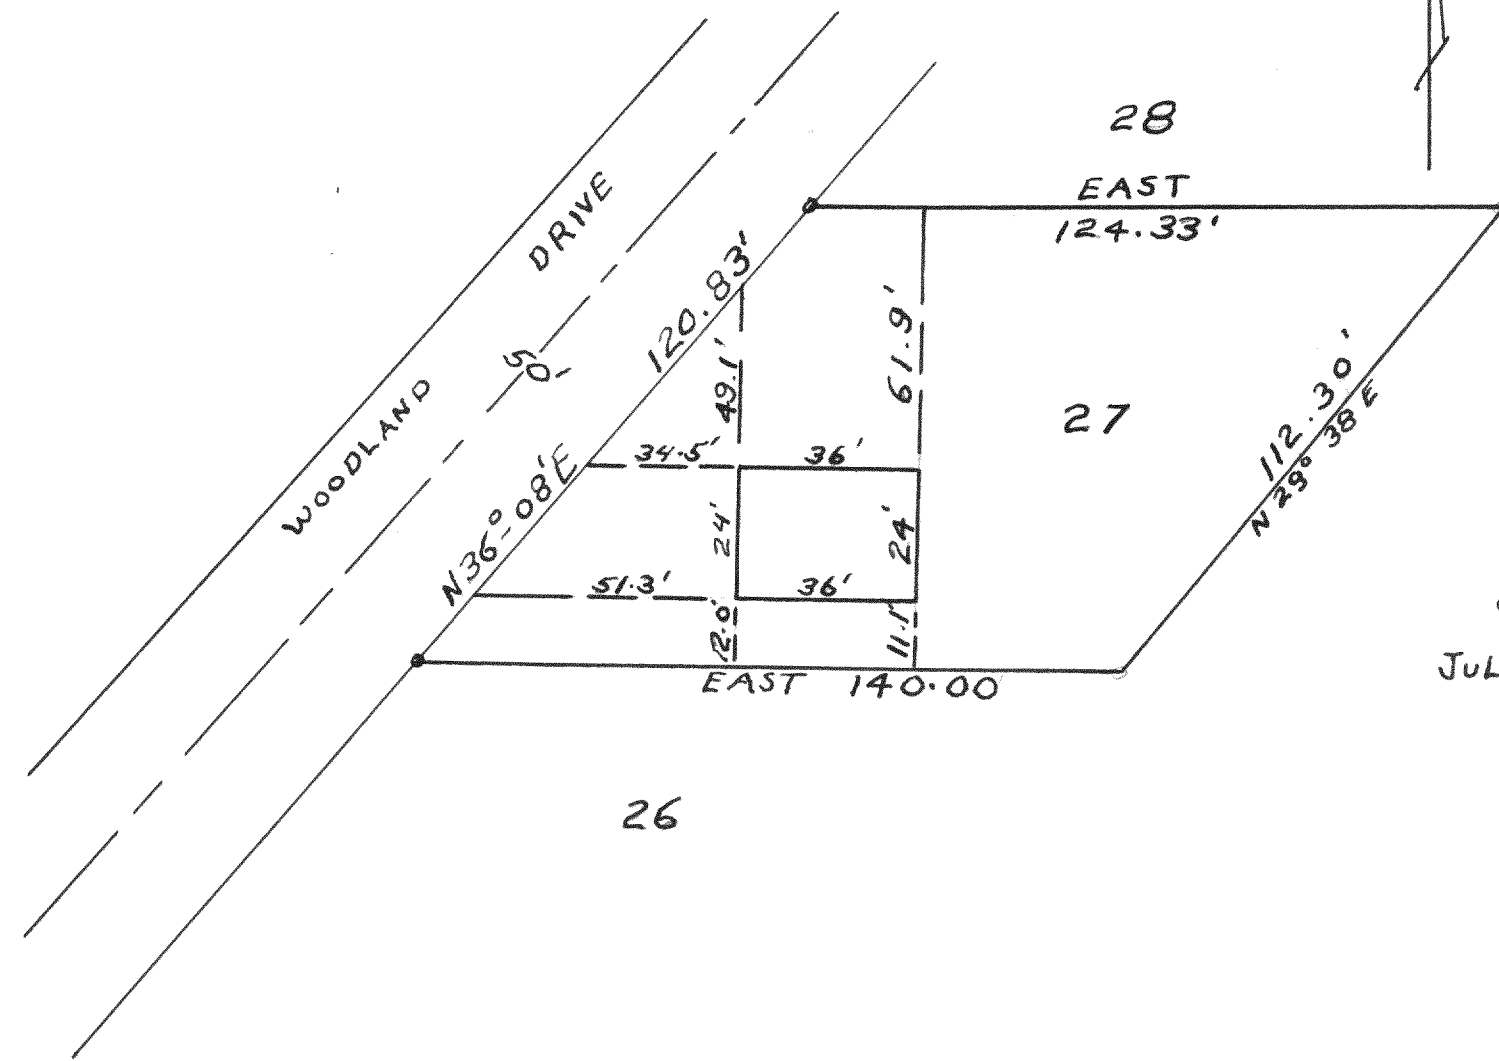