



LOT 1 OF ADDITION "A"
 TO COUNTRY CLUB ESTATES
 LOCATED IN THE VILLAGE
 OF FONTANA ON GENEVA
 LAKE, WALWORTH COUNTY
 WISCONSIN
 MAY 1955

LLOYD L. JENSEN
 COUNTY SURVEYOR

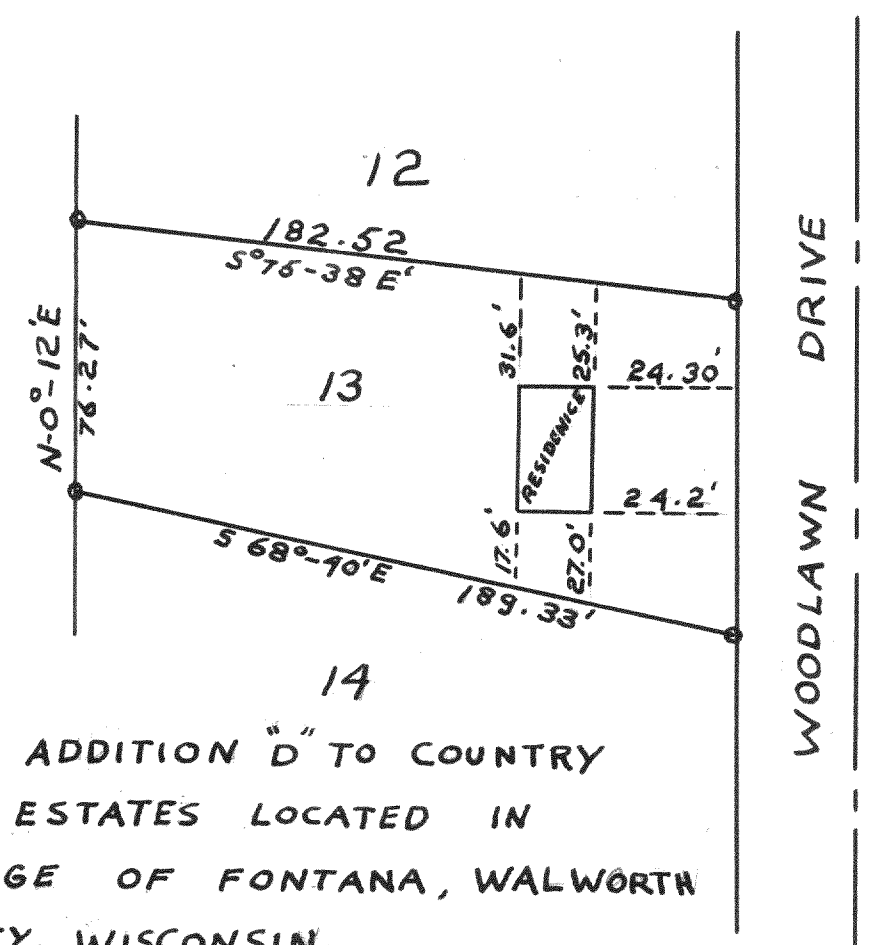

LOT 13 ADDITION "D" TO COUNTRY
 CLUB ESTATES LOCATED IN
 VILLAGE OF FONTANA, WALWORTH
 COUNTY, WISCONSIN
 JULY 1955

LLOYD L. JENSEN
 COUNTY SURVEYOR

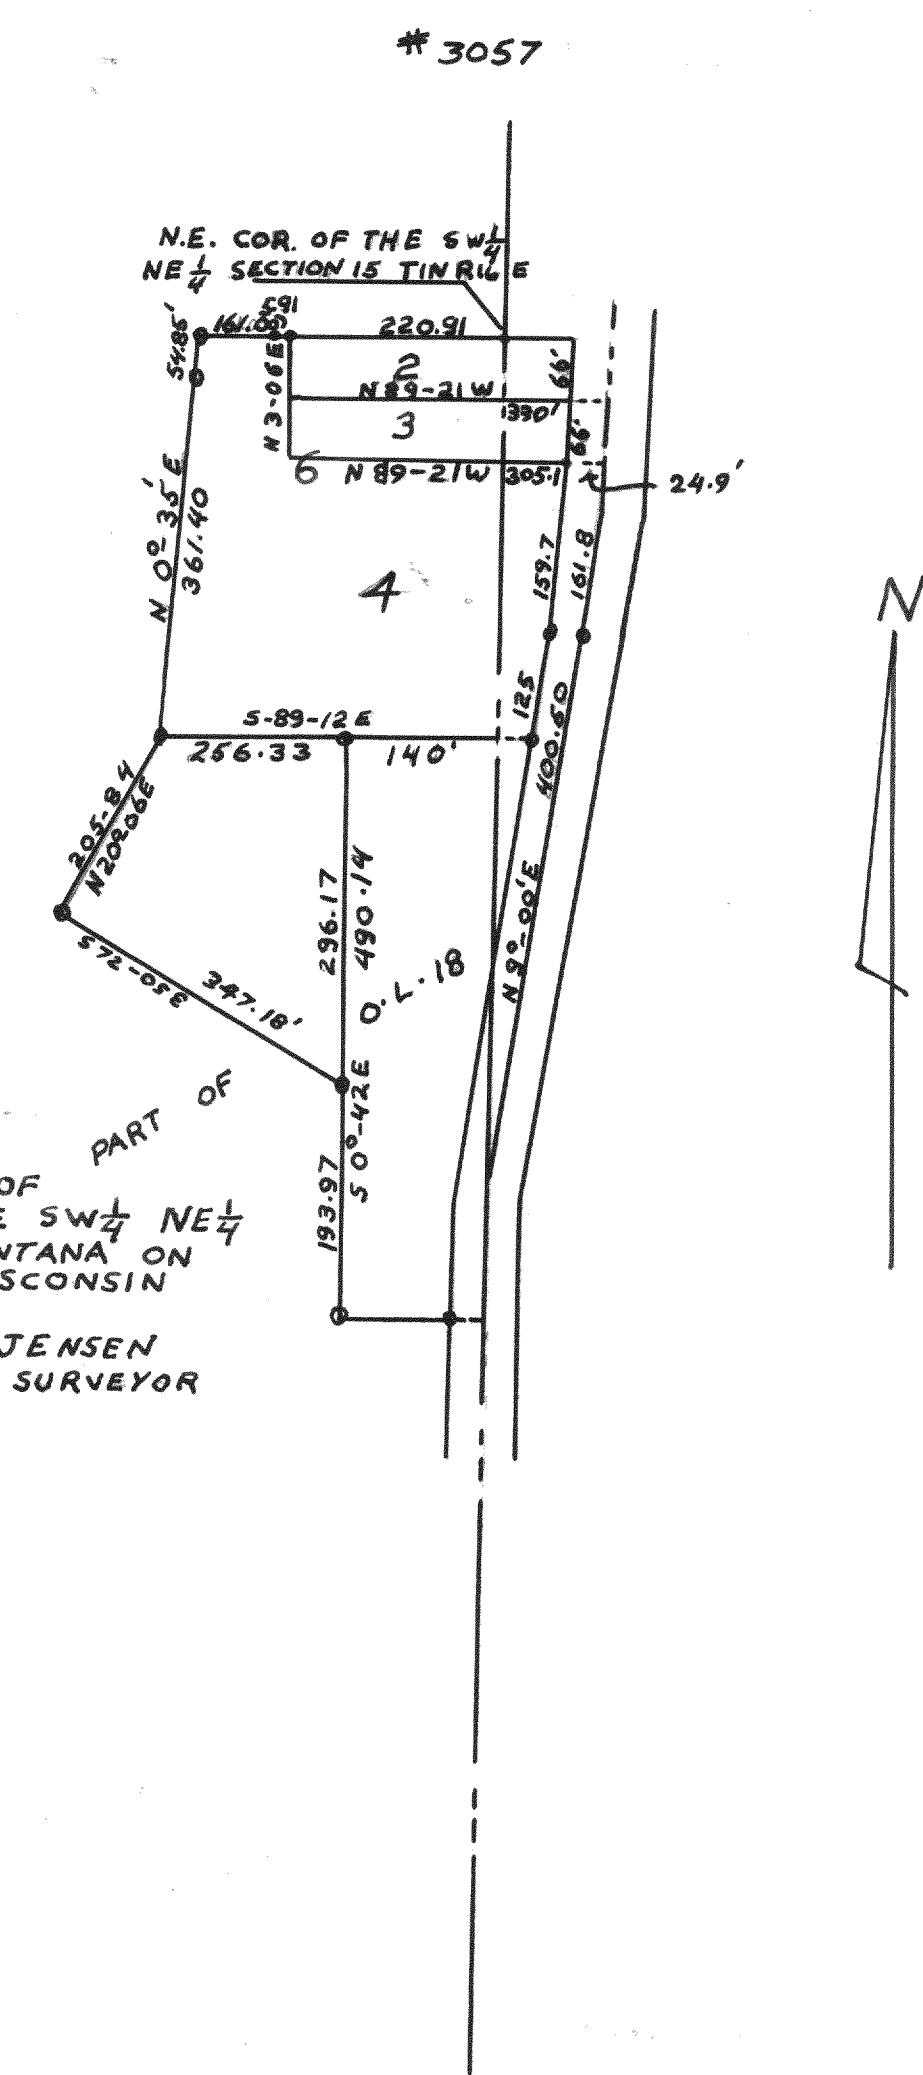

LOTS 3 & 4; BLOCK 6 OF C.L.
 DOUGLASS ADD. AND PART OF O.L. 18 OF
 ASSESSORS PLAT NO. 1 LOCATED IN THE SW 1/4 NE 1/4
 SECTION 15, T16R16E VILLAGE OF FONTANA ON
 GENEVA LAKE, WALWORTH COUNTY, WISCONSIN
 APRIL 1955

LLOYD L. JENSEN
 COUNTY SURVEYOR