



LOT 3 OF BLOCK 7 EXCEPT THE NORTH 10 FEET AND NORTH 5 FEET OF LOT 4 BLOCK 7 GLENWOOD SPRINGS, VILLAGE OF FONTANA ON GENEVA LAKE, WALWORTH COUNTY, WISCONSIN  
MARCH 1965  
LLOYD L. JENSEN  
COUNTY SURVEYOR

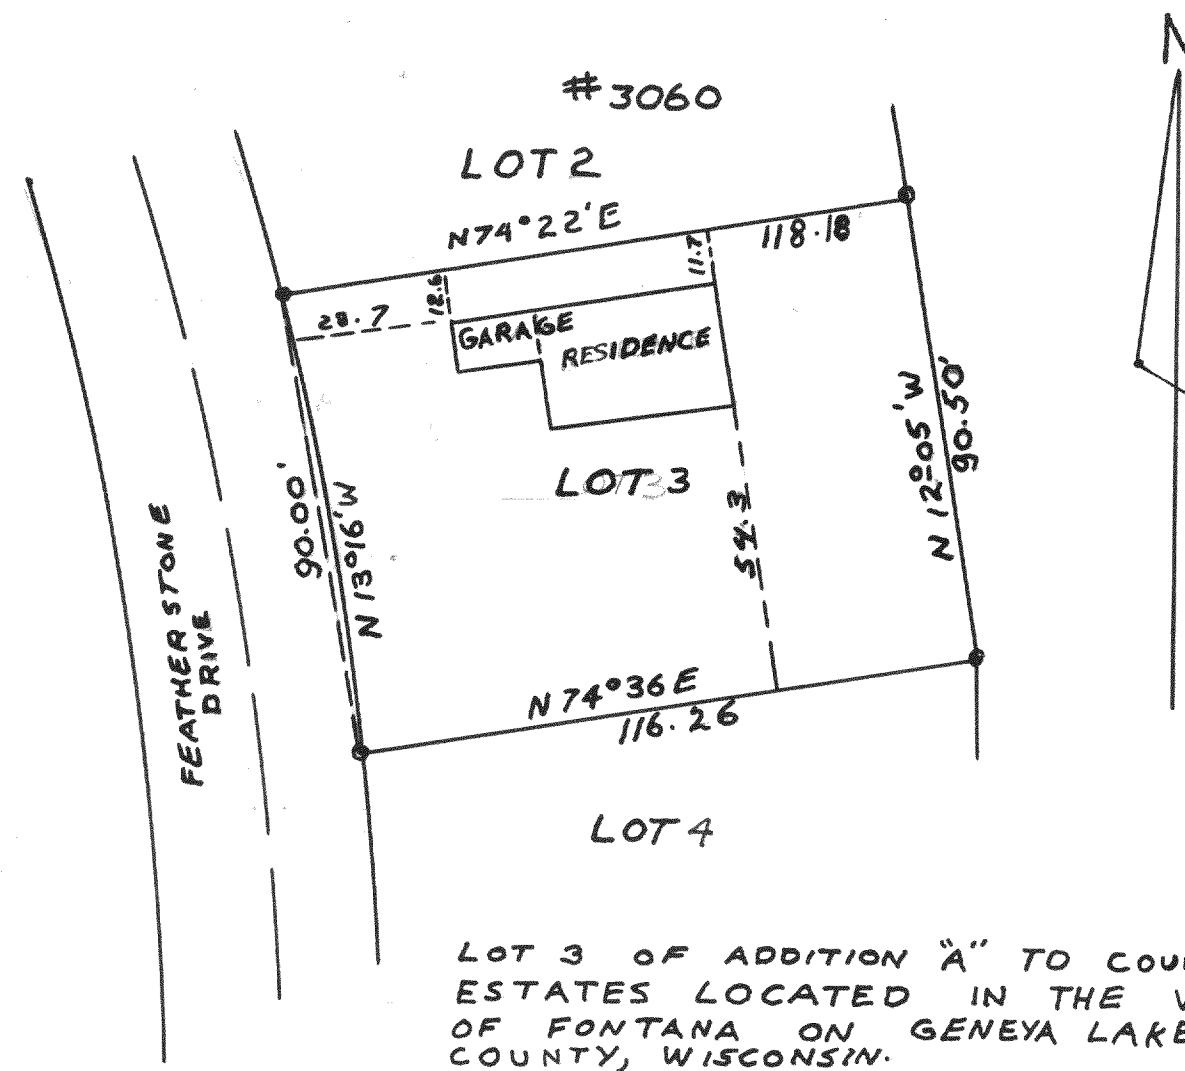

LOT 3 OF ADDITION "A" TO COUNTRY CLUB ESTATES LOCATED IN THE VILLAGE OF FONTANA ON GENEVA LAKE, WALWORTH COUNTY, WISCONSIN.

MAY 1955

LLOYD L. JENSEN  
COUNTY SURVEYOR

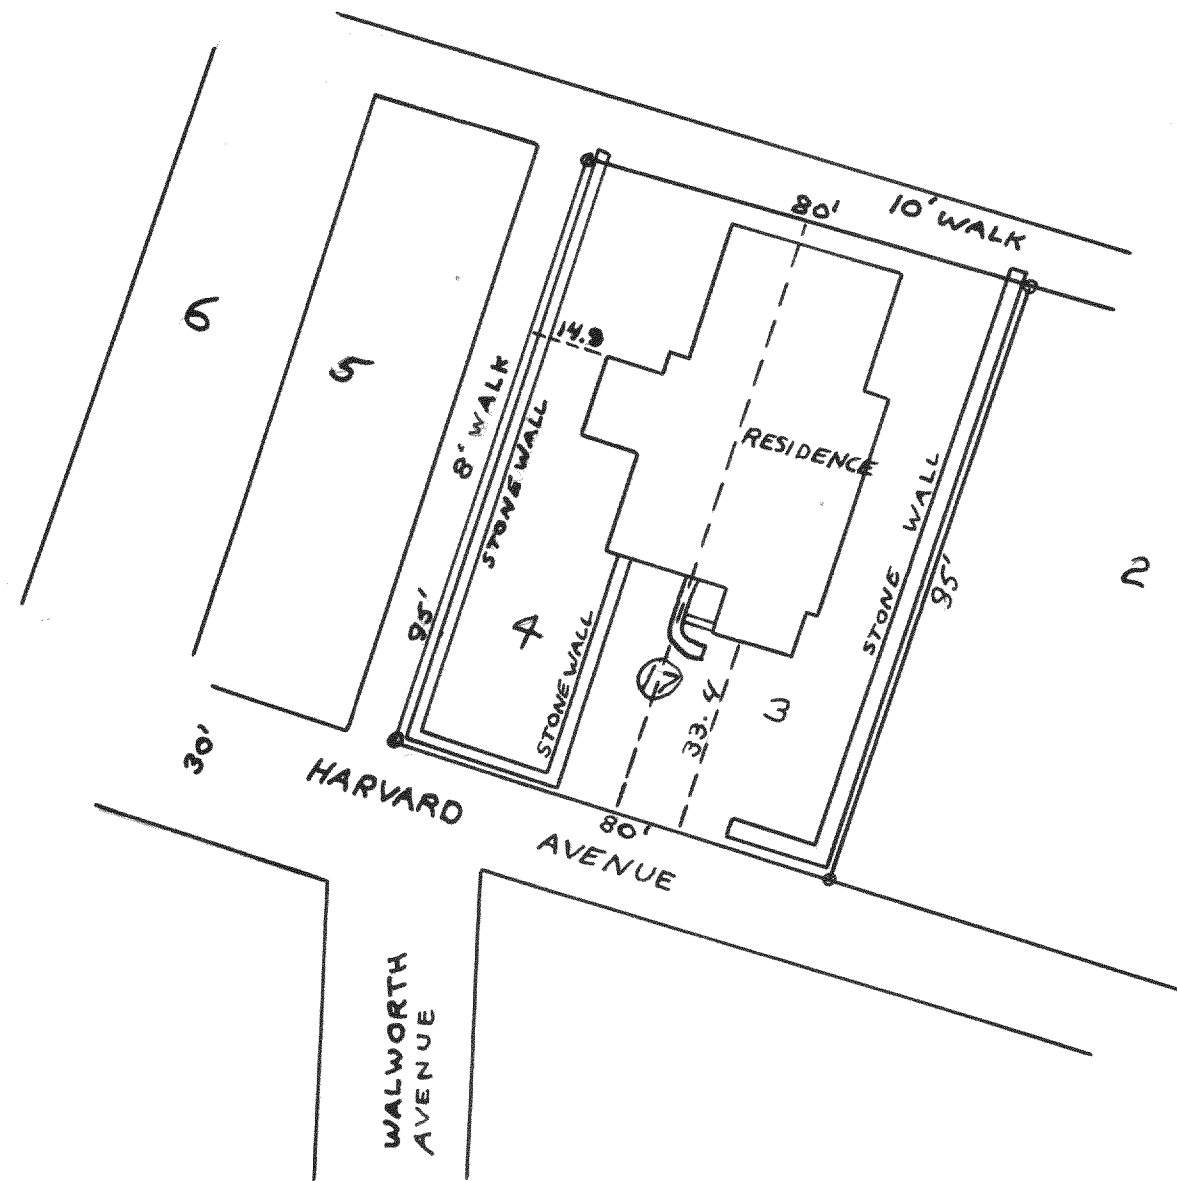

LOTS 3 AND 4 OF BLOCK 17 GLENWOOD SPRINGS LOCATED IN THE VILLAGE OF FONTANA ON GENEVA LAKE WALWORTH COUNTY, WISCONSIN

APRIL 1955  
LLOYD L. JENSEN  
COUNTY SURVEYOR