



#3159

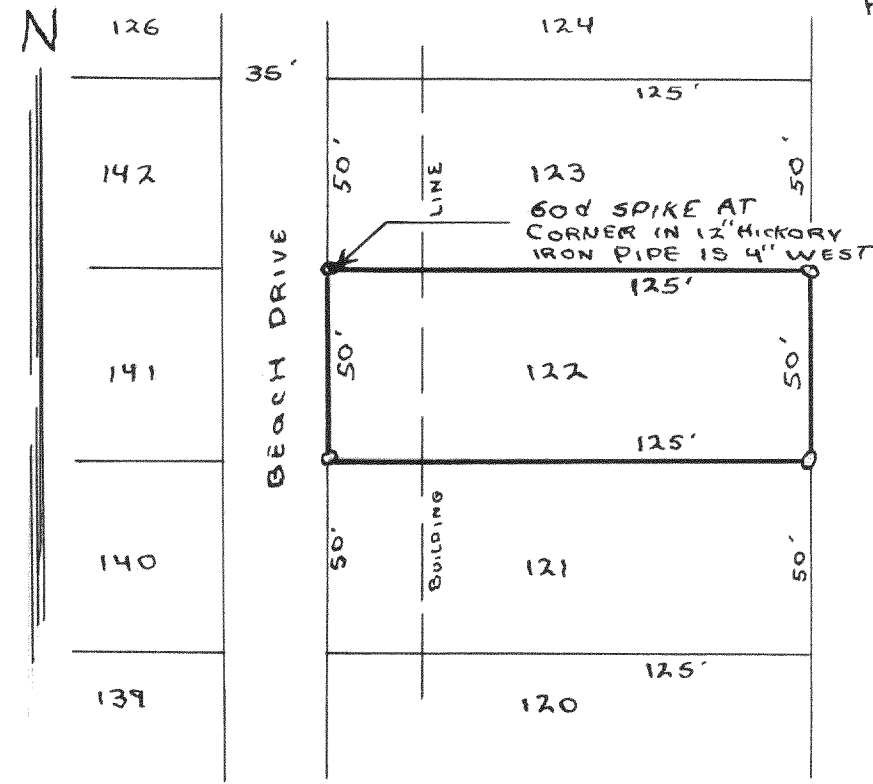

PLAT OF SURVEY OF LOT 122
OF LAKE GENEVA BEACH
LOCATED IN T1N R17E OF
WALWORTH COUNTY, WISCONSIN
OCT 1956 LLOYD L JENSEN
SURVEYOR

#3160

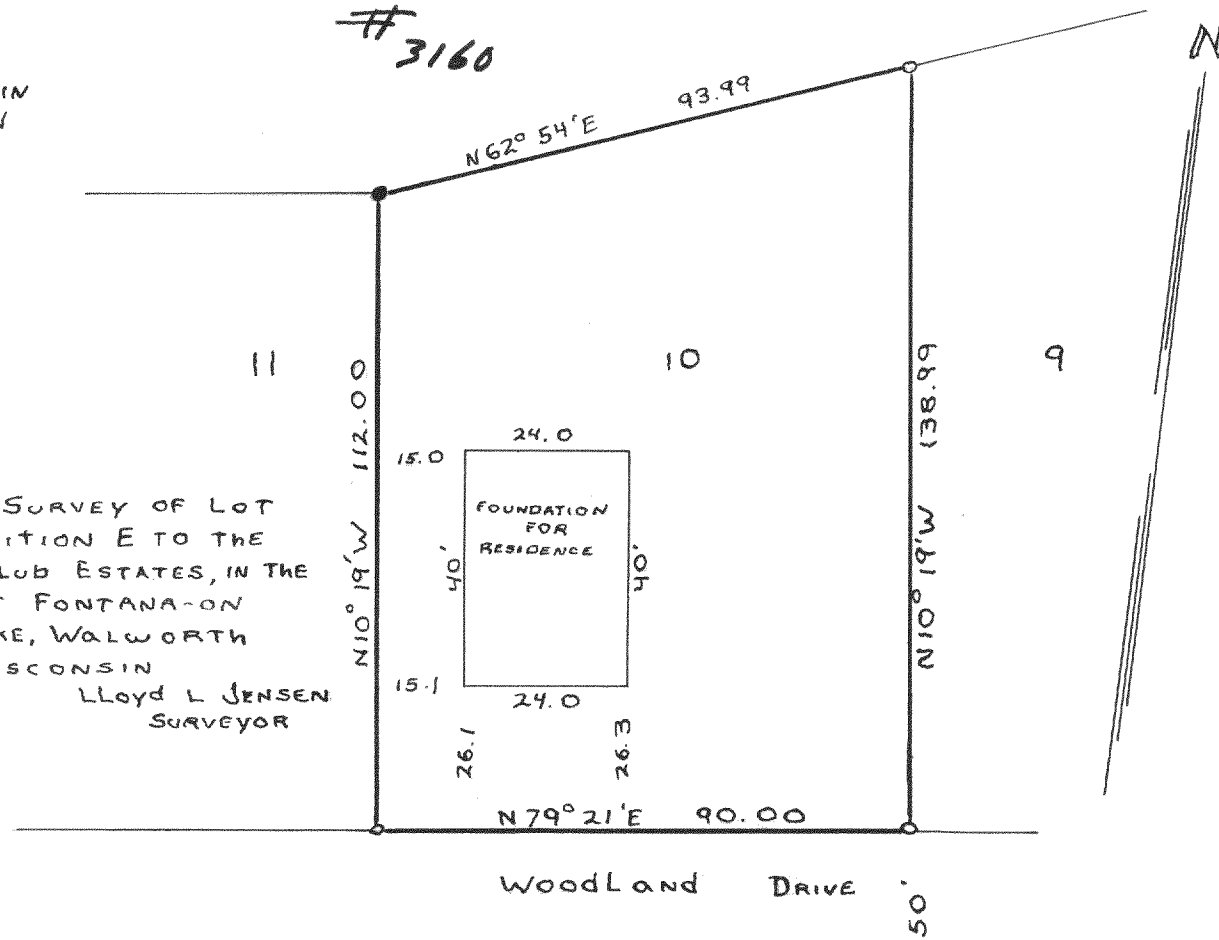


PLAT OF SURVEY OF LOT
10 OF ADDITION E TO THE
COUNTRY CLUB ESTATES, IN THE
VILLAGE OF FONTANA-ON
GENEVA LAKE, WALWORTH
COUNTY, WISCONSIN
DEC, 1956 LLOYD L JENSEN
SURVEYOR

PLAT OF SURVEY OF LOT 28
OF ORIGINAL PLAT OF CEDAR
POINT PARK LOCATED IN VILLAGE
OF WILLIAMS BAY WALWORTH
COUNTY, WISCONSIN
NOV 26, 1956

LLOYD L JENSEN
SURVEYOR

#3161

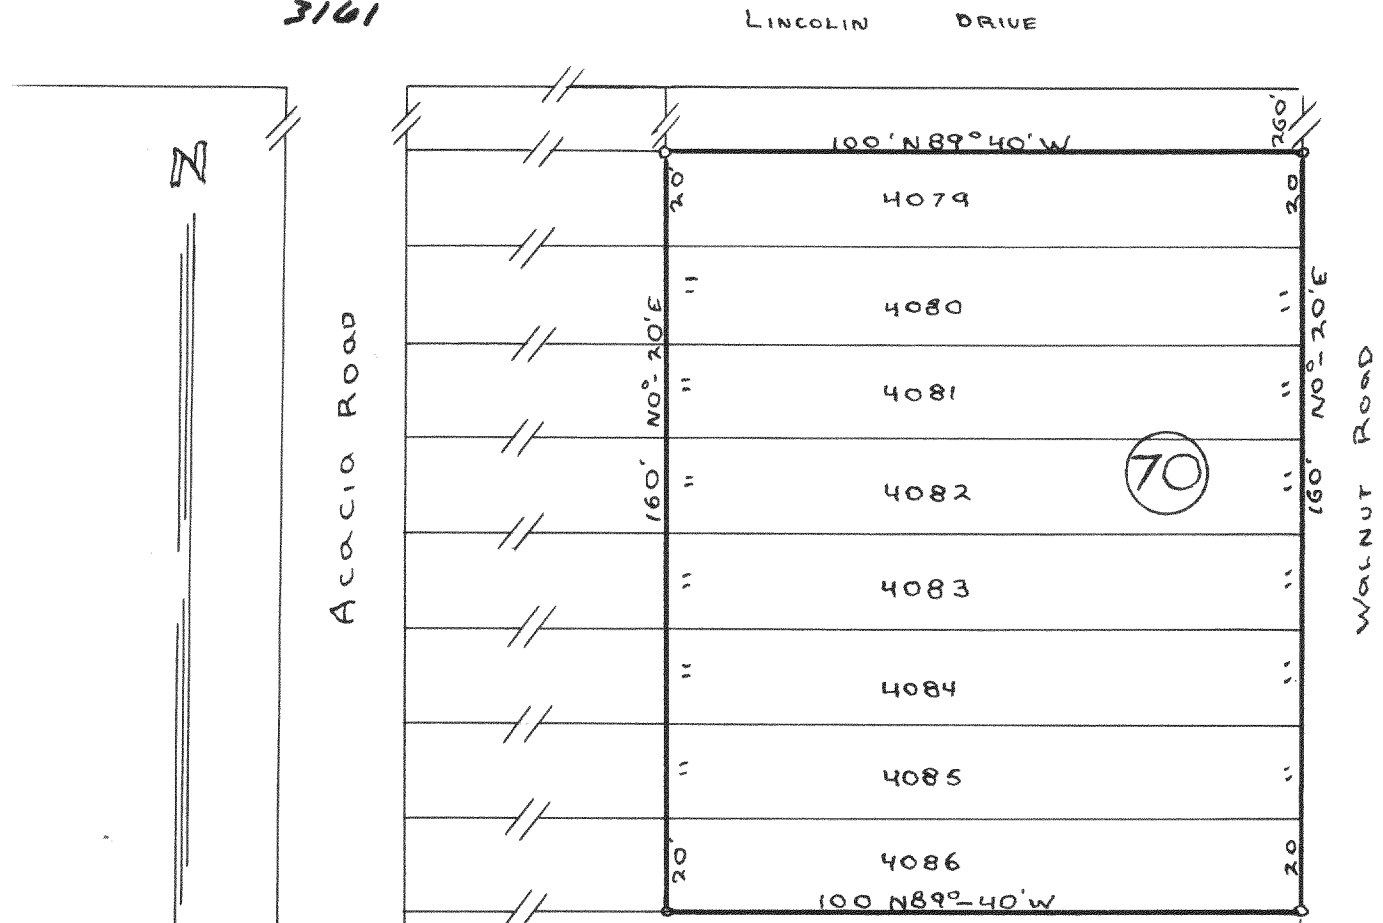

PLAT OF SURVEY OF LOTS 4079-4086,
BLOCK 70, LAKE COMO BEACH SUB.
T2N, R17E GENEVA TWP, WALWORTH
COUNTY, WISCONSIN
DEC. 1956 LLOYD L JENSEN
SURVEYOR

#3162

