



# 2668

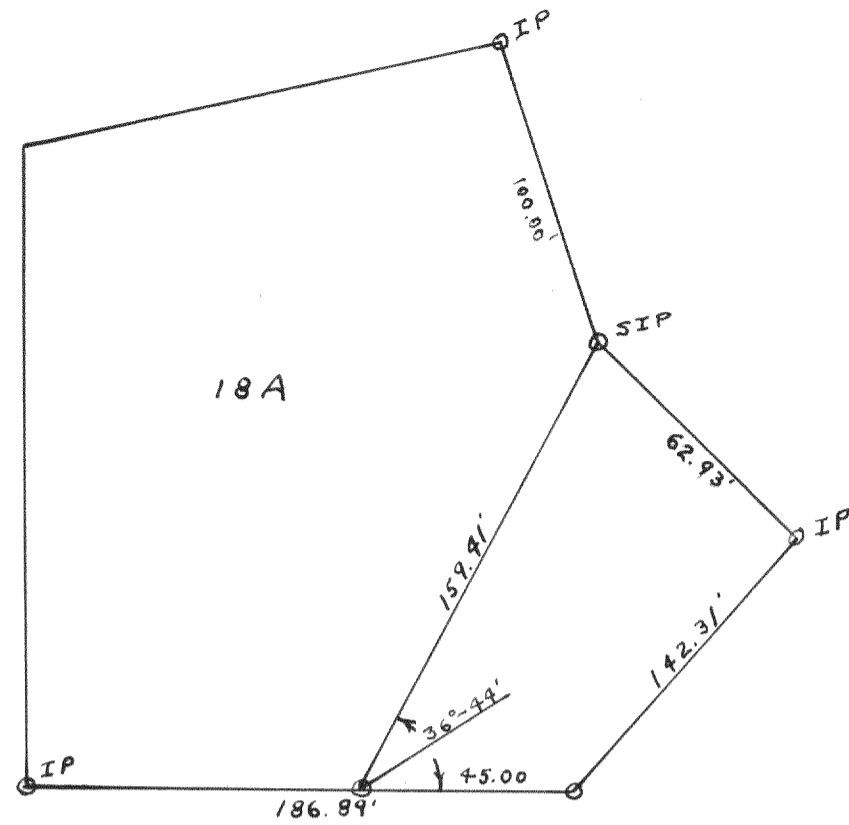


PLAT OF SURVEY OF PART OF LOT 18A OF  
 TRINKE ESTATES, LOCATED IN SECTION 10,  
 TINRITE. *Floyd L Jensen SA*  
 JUNE 17, 1952 COUNTY SURVEYOR

# 2669

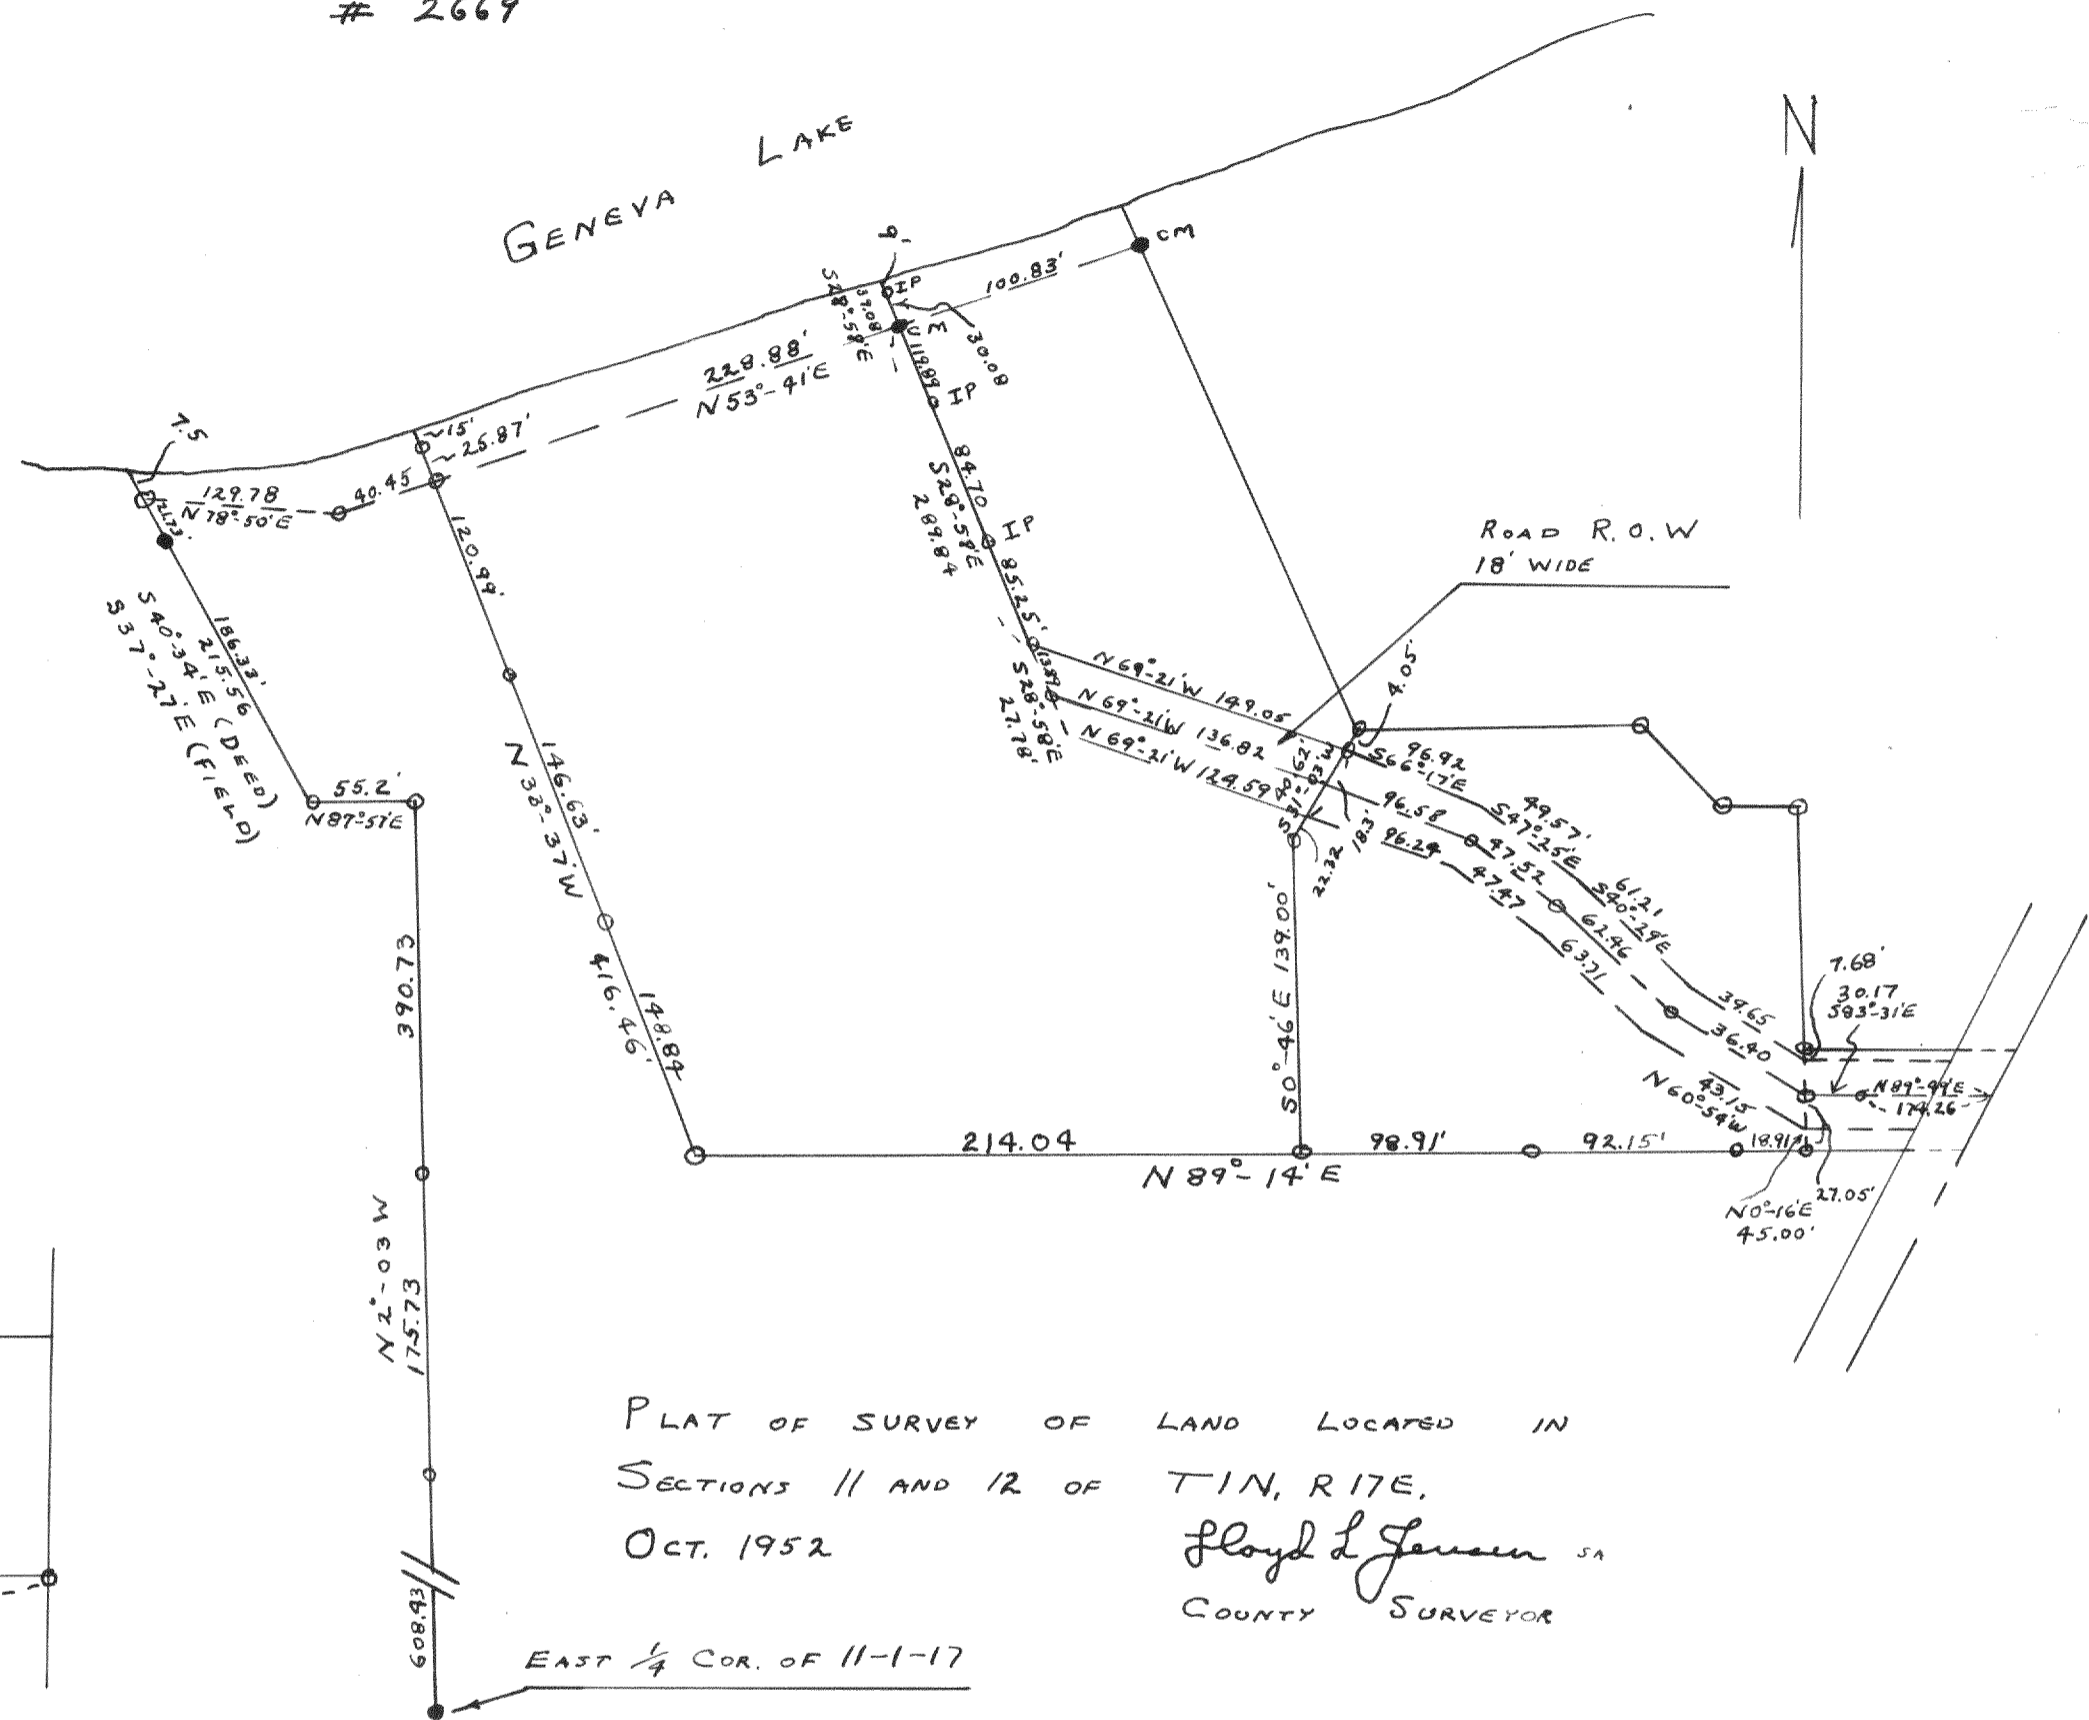

PLAT OF SURVEY OF LAND LOCATED IN  
 SECTIONS 11 AND 12 OF TINRITE,  
 OCT. 1952 *Floyd L Jensen SA*  
 COUNTY SURVEYOR

# 2670

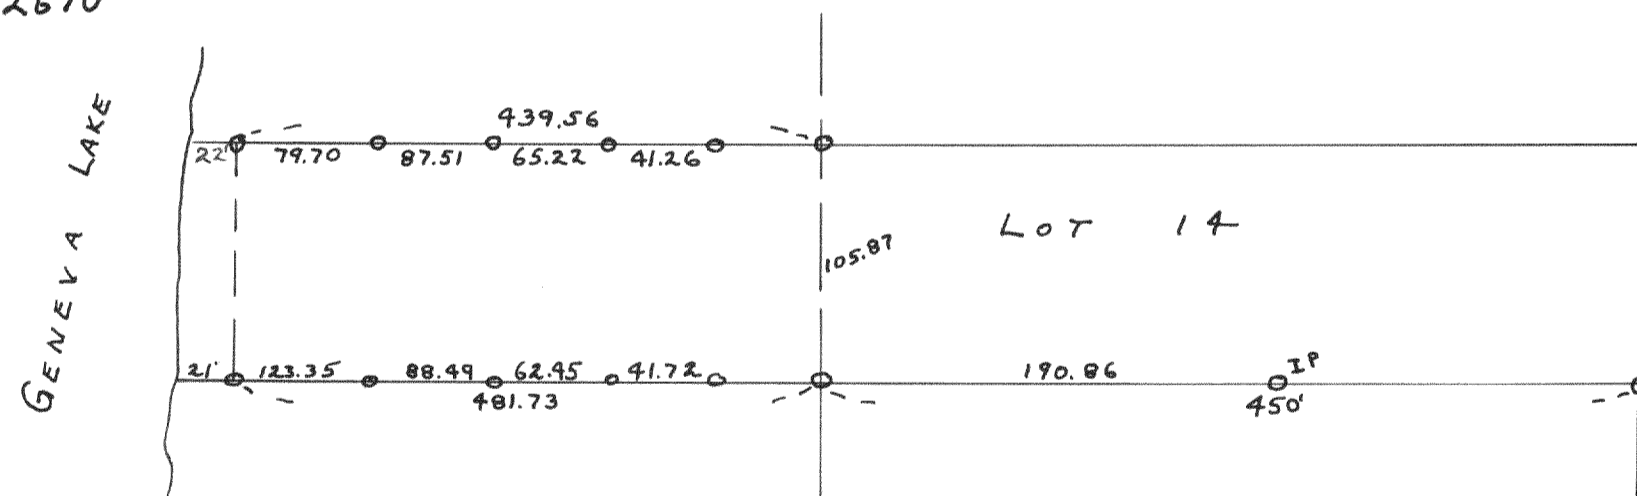

PLAT OF SURVEY TO PLACE ADDITIONAL STAKES ALONG  
 THE LINES OF LOT 14 OF S. B. CHAPIN SUBDIVISION.  
 AUGUST 1952 *Floyd L Jensen SA*  
 COUNTY SURVEYOR