




Plat of Survey of Lauderdale School Site in Sections 25 and 36 of T4N, R16E, of Walworth County, Wisconsin.
Sept. 1958 Lloyd L. Jensen Surveyor

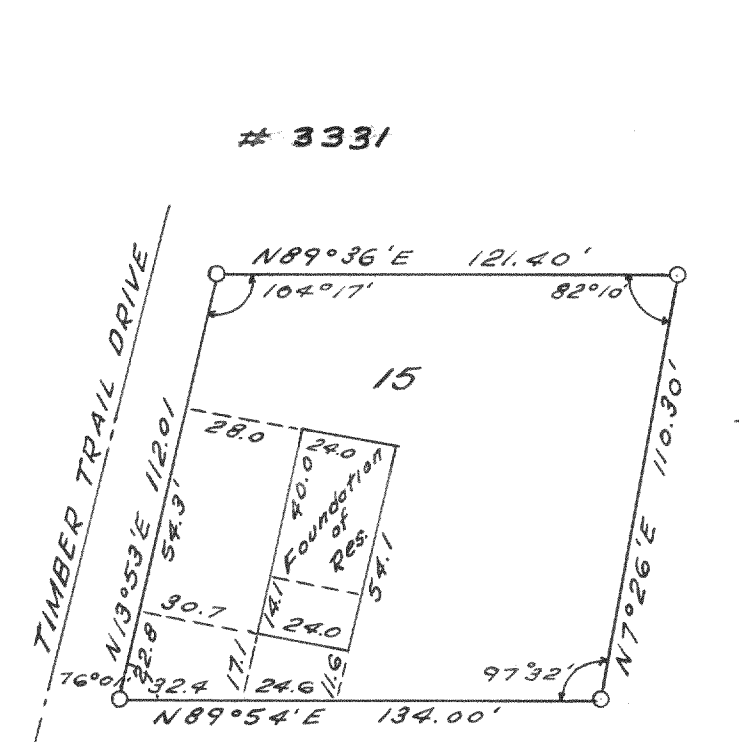

Plat of Survey of lot 15 Addition F Country Club Estates Village of Fontana on Geneva Lake, Walworth County, Wisconsin.
Oct. 1958 Lloyd L. Jensen Surveyor

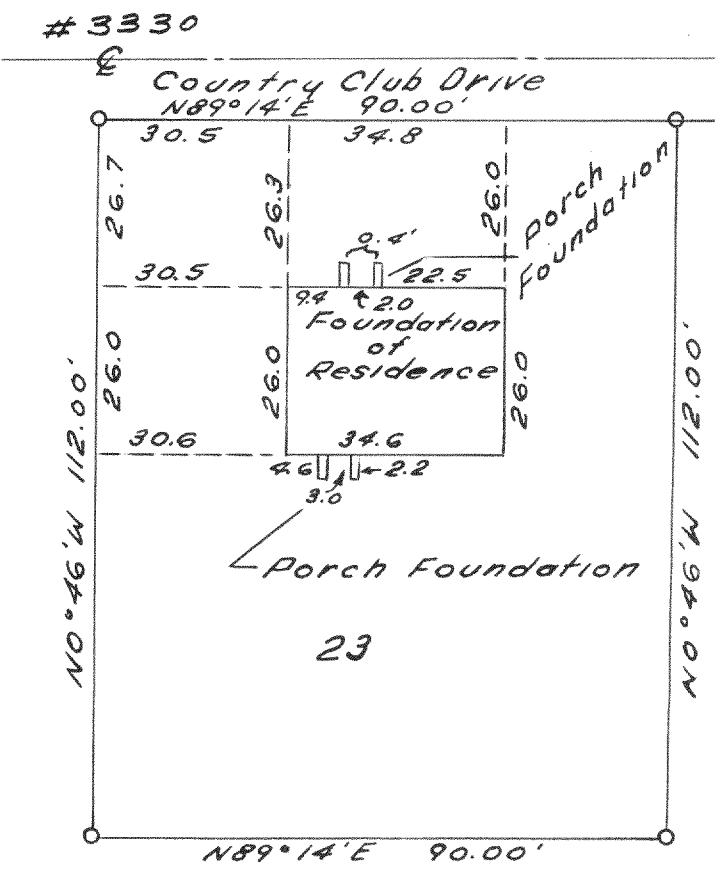

Plat of Survey of lot 23, Addition E to Country Club Estates located in the NW1/4 of the NE1/4 of Section 23 T1N, R16E, Village of Fontana on Geneva Lake, Walworth County, Wisconsin.
August 1958 Lloyd L. Jensen Surveyor

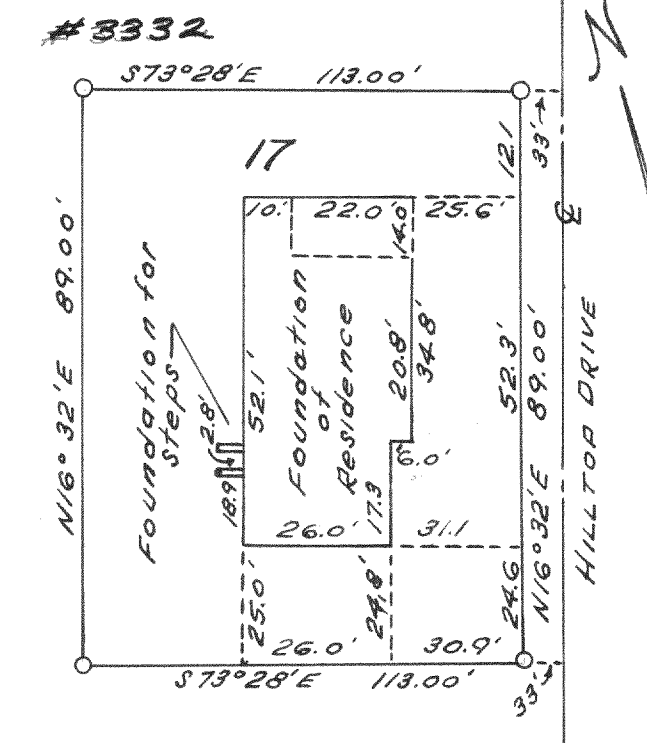

Plat of Survey of lot 17 of Lyndale Subdivision located in the Village of East Troy Walworth County, Wisconsin.
Oct. 1958 Lloyd L. Jensen Surveyor