




Survey of Lot 5, Hill & Wickstran Subdivision East Delavan, T2N, R16E

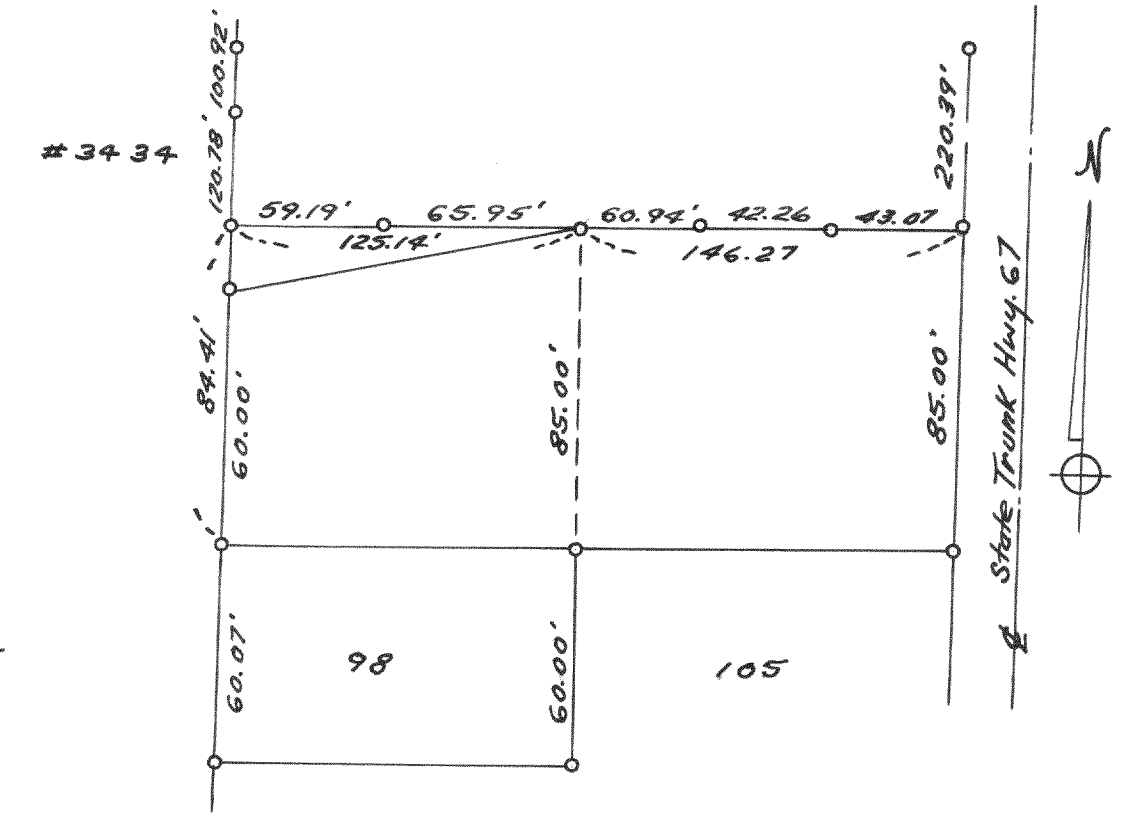


Survey of Parcel in NW 1/4 Sec. 25-3-16

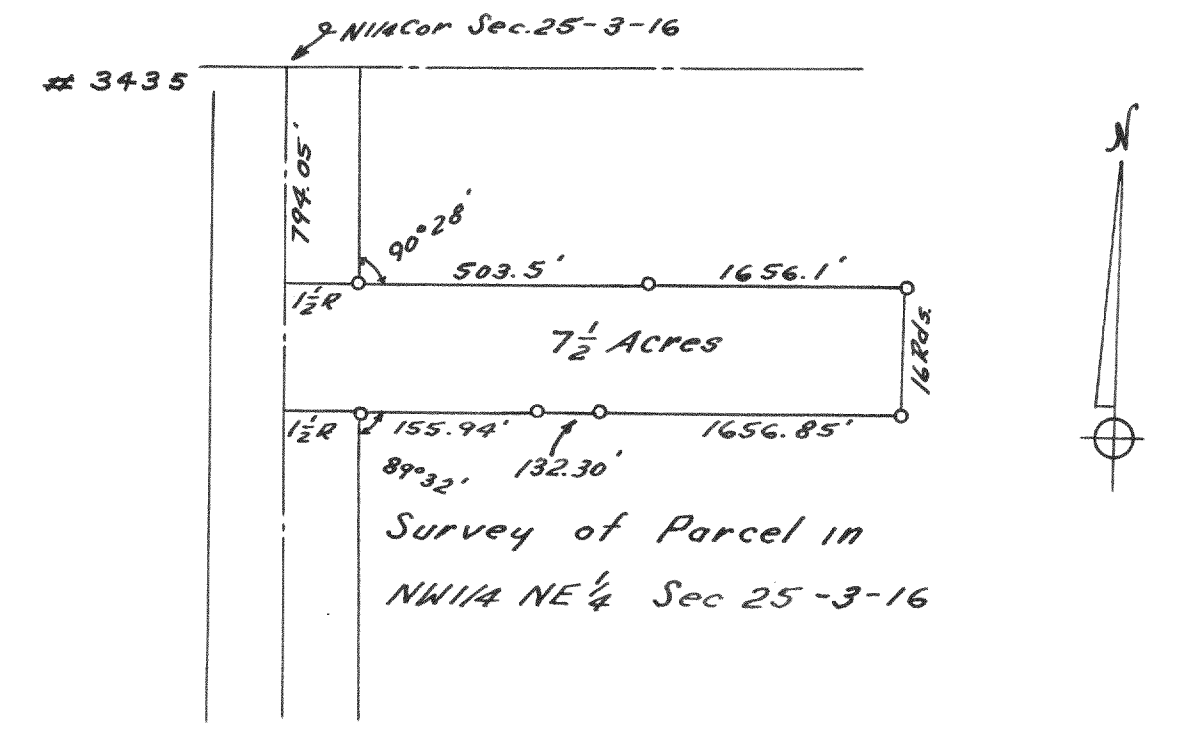


Survey of Parcel in NW 1/4 NE 1/4 Sec 25-3-16

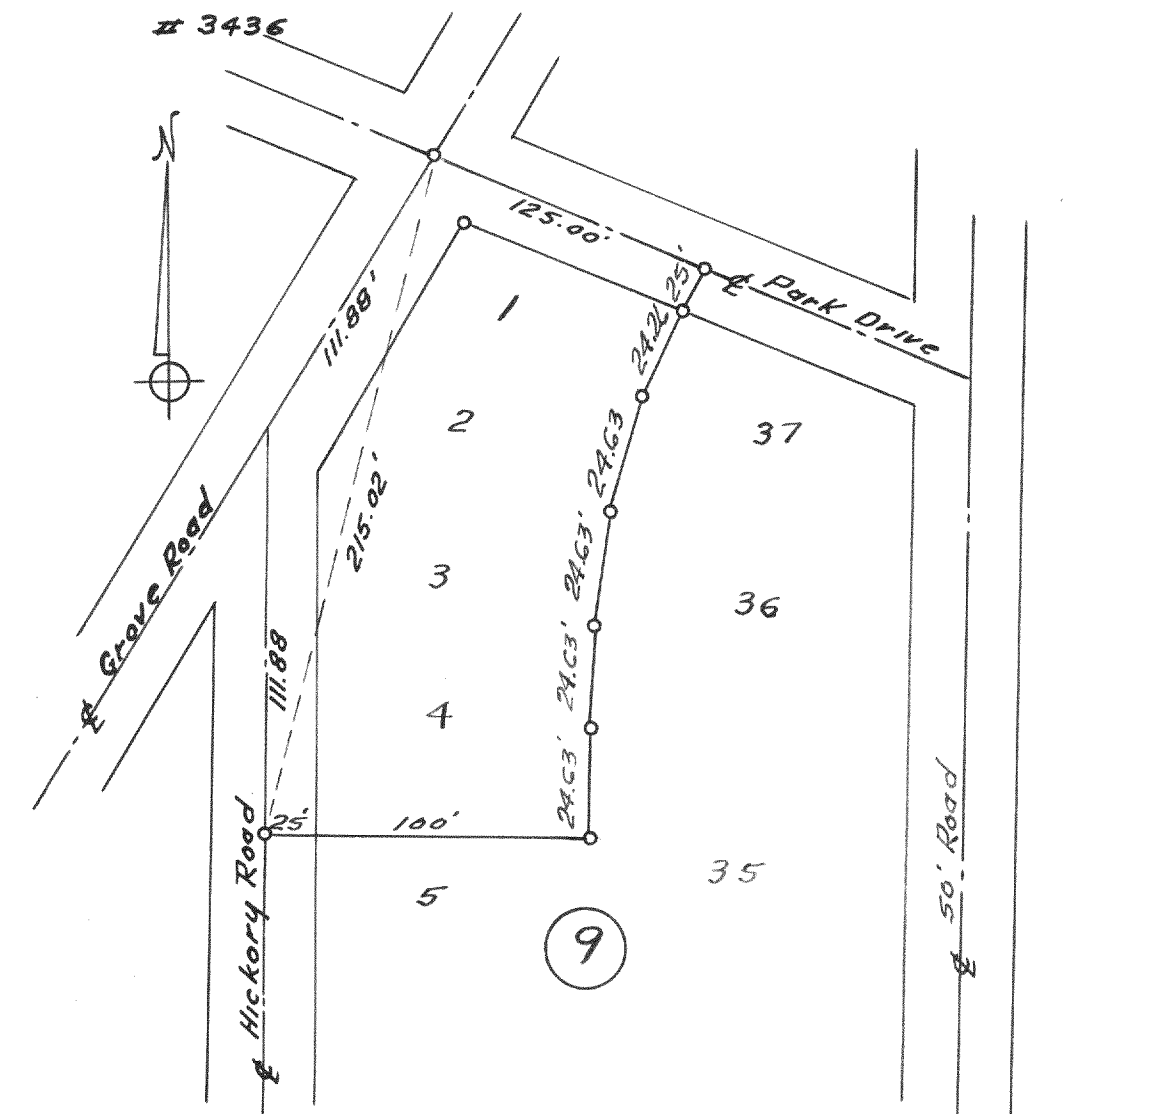


Survey of Lots 1-4 Block 9, Interlaken

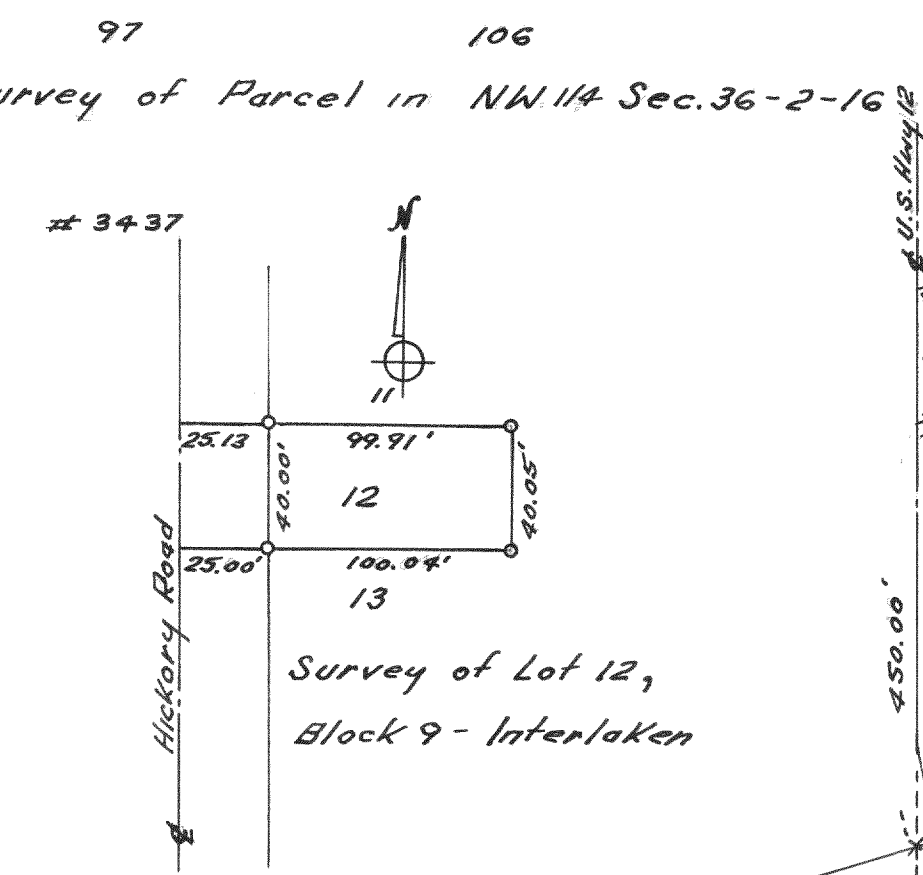


Survey of Lot 12, Block 9 - Interlaken

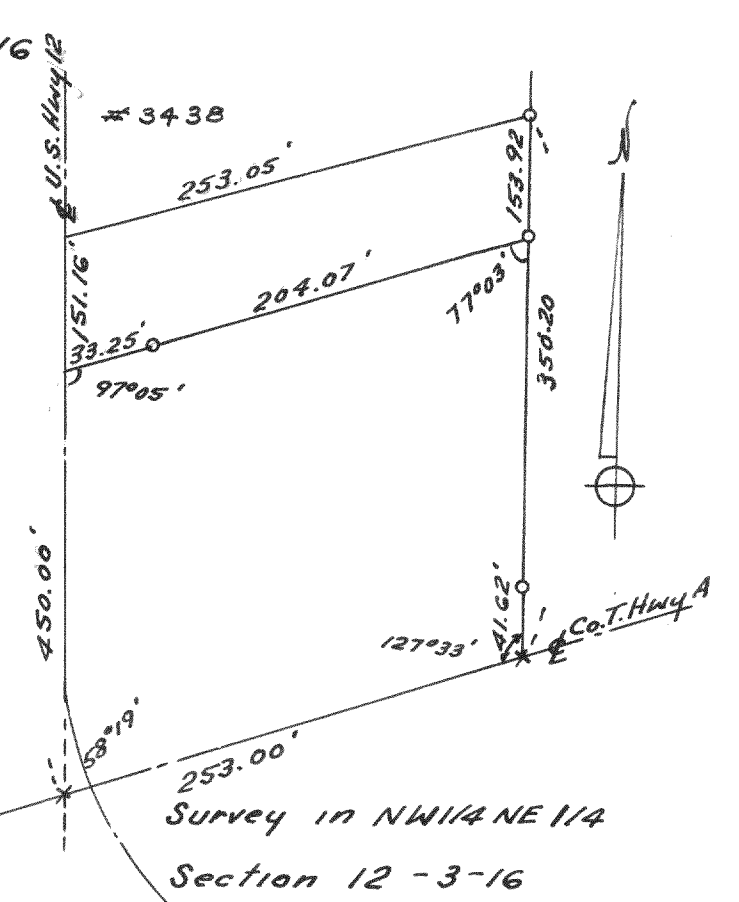


Survey in NW 1/4 NE 1/4 Section 12-3-16

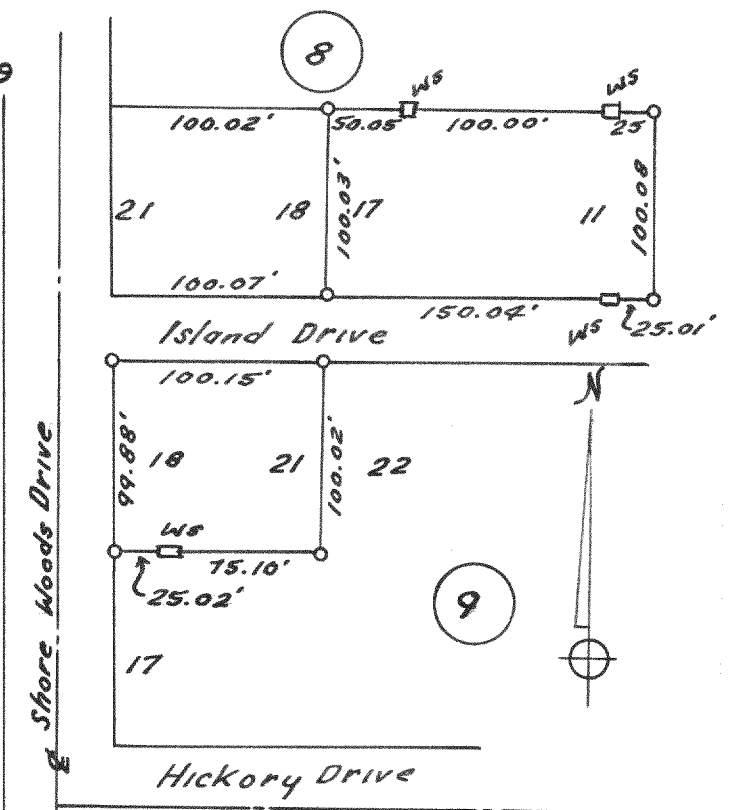


Survey of Lots 11-17 Block 8 and Lots 18-21 Block 9, North Lake Shore Woods

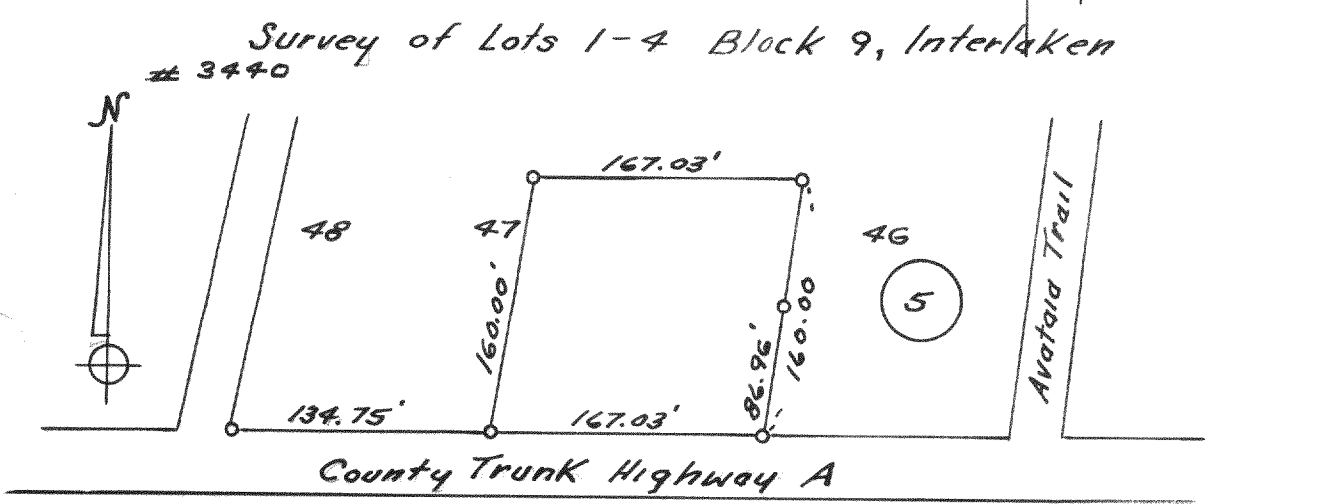


Survey Lots 46-48, Block 5, Wandawega Highlands 1st Add.

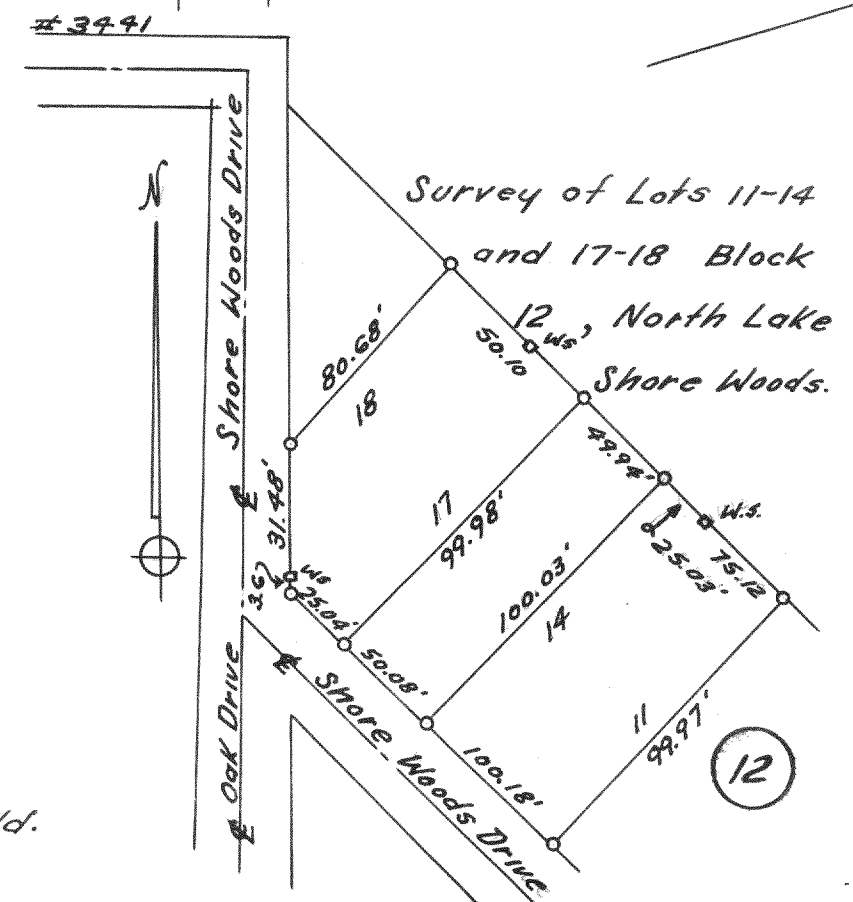

Survey of Lots 11-14 and 17-18 Block 12, North Lake Shore Woods.

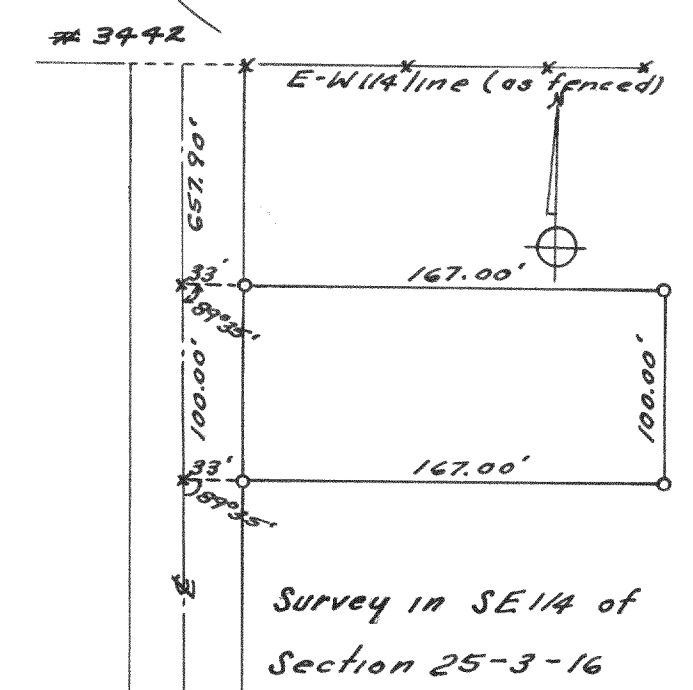

Survey in SE 1/4 of Section 25-3-16

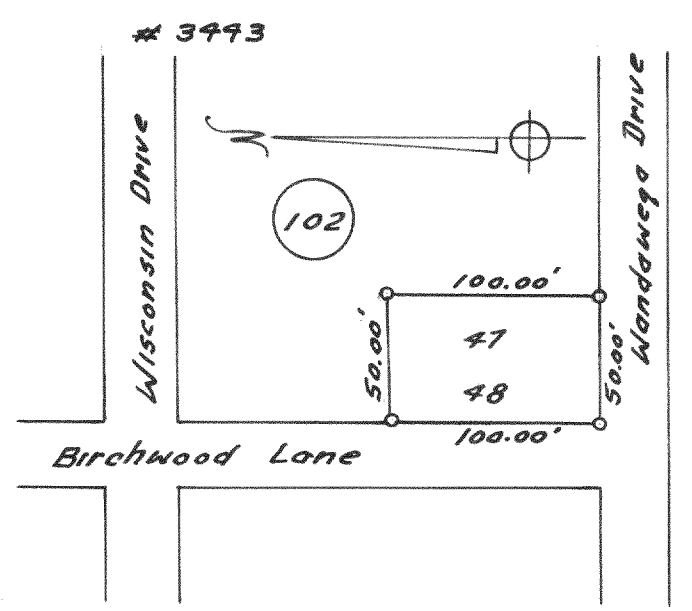

Survey Lots 47 & 48, Block 102, Lake Wandawega Subd.