




PLAT OF SURVEY OF
 LOT 13 AND PART OF LOT 14,
 BLOCK 1, MORaine PARK SUBD.
 SEC. 34, T4N, R15E WALWORTH
 COUNTY WISCONSIN
 LLOYD L. JENSEN
 COUNTY SURVEYOR

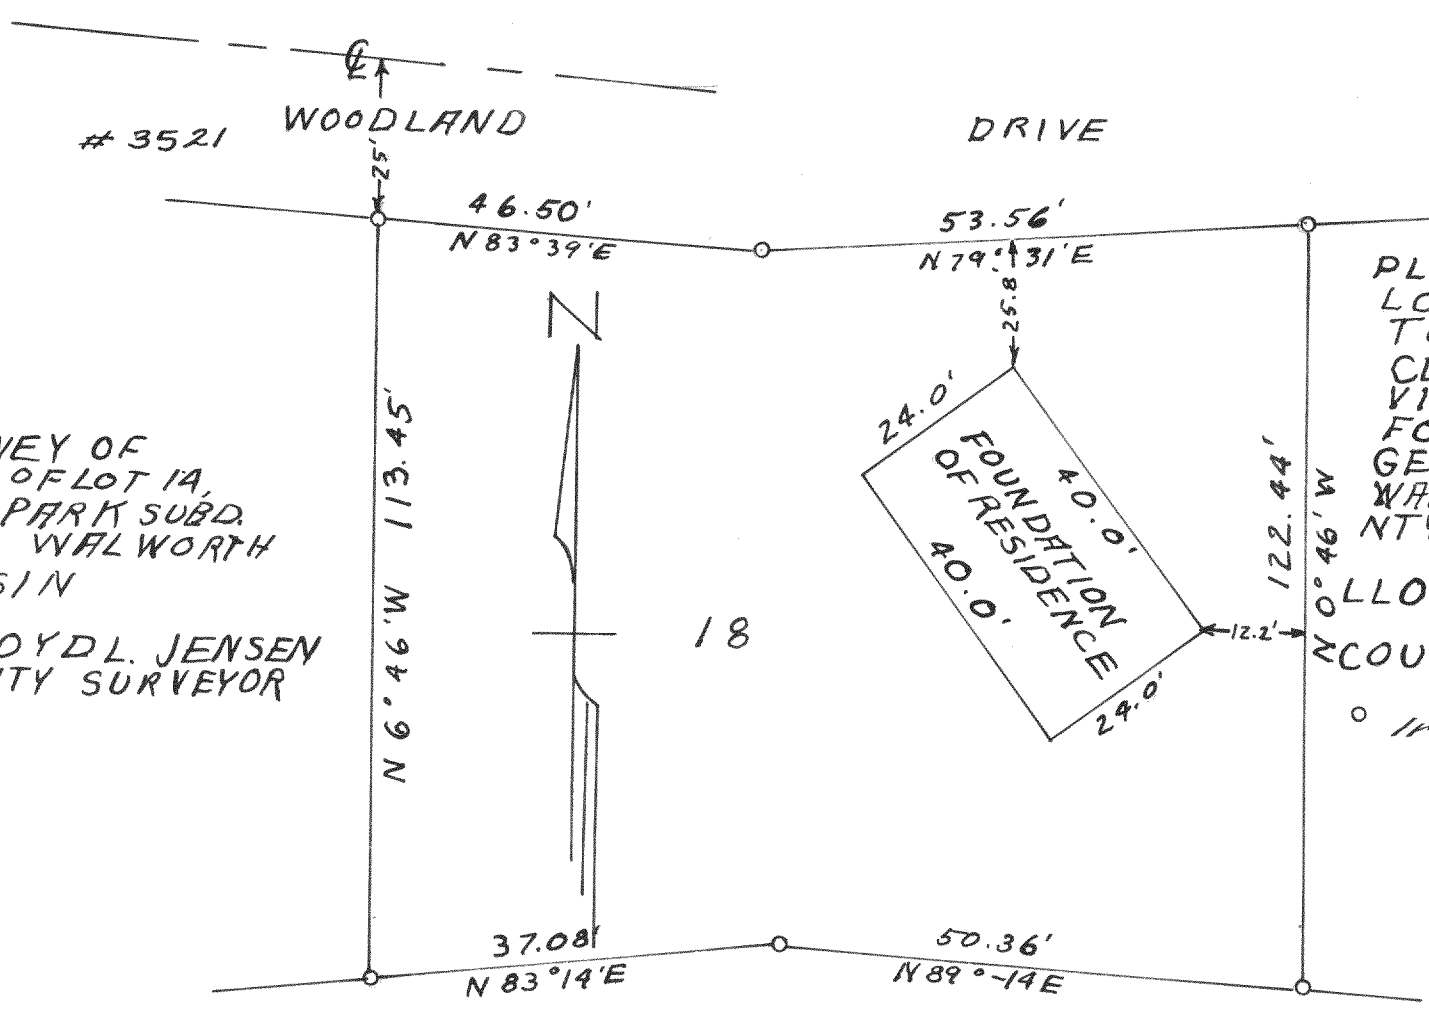


PLAT OF SURVEY OF
 LOT 18, ADD. "E"
 TO COUNTRY
 CLUB ESTATES,
 VILLAGE OF
 FONTANA-ON-
 GENEVA LAKE
 WALWORTH COUNTY
 WISCONSIN
 LLOYD L. JENSEN
 COUNTY SURVEYOR

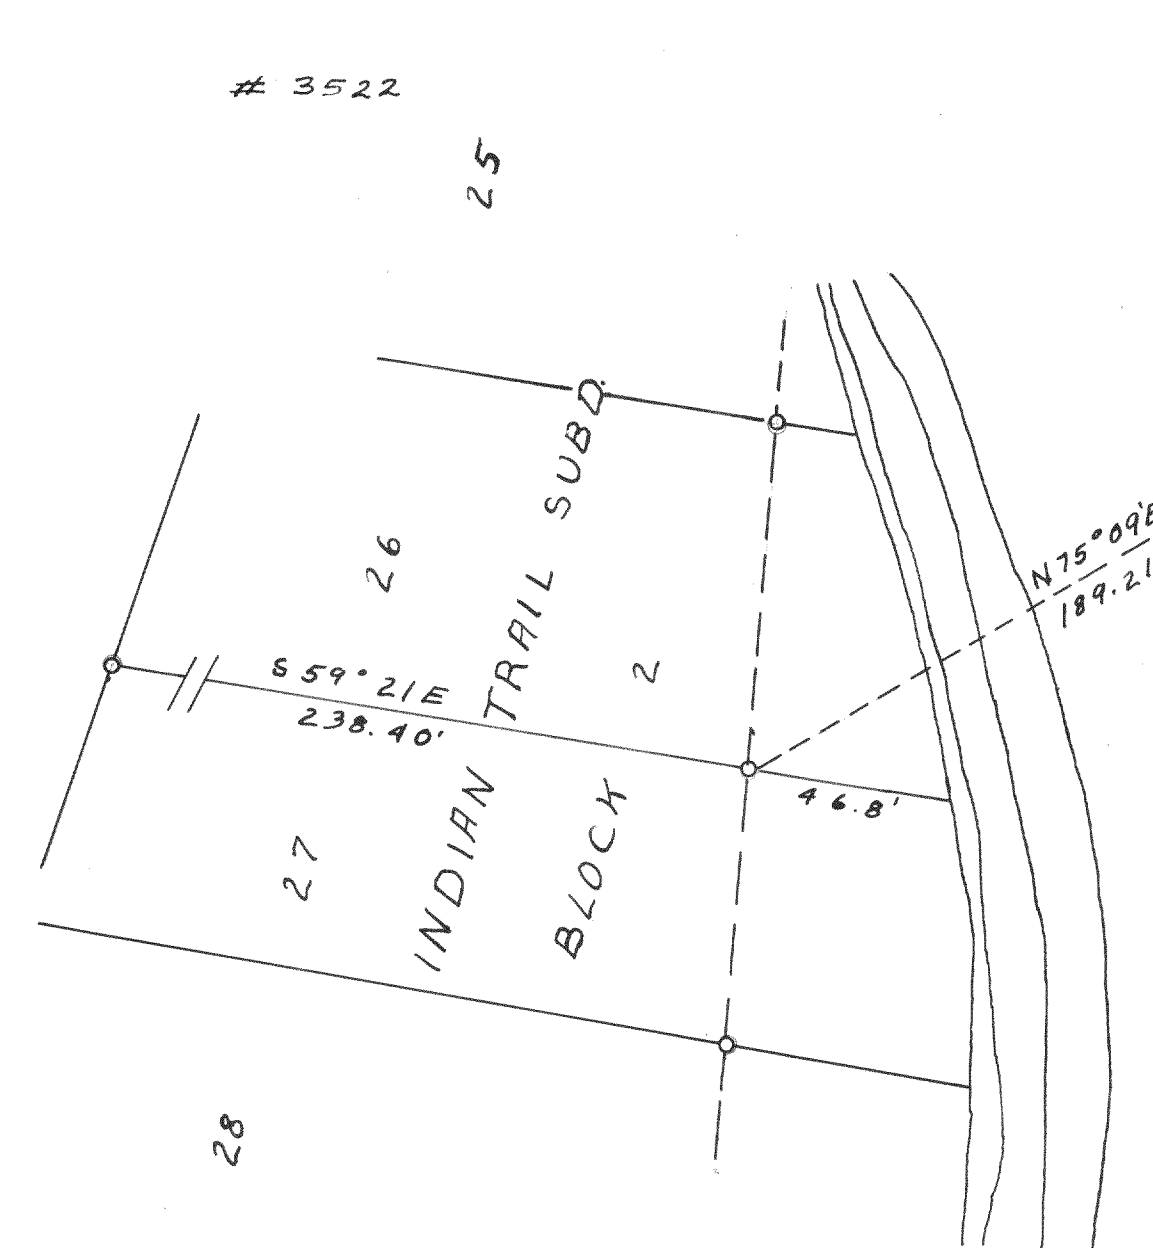

LOWER

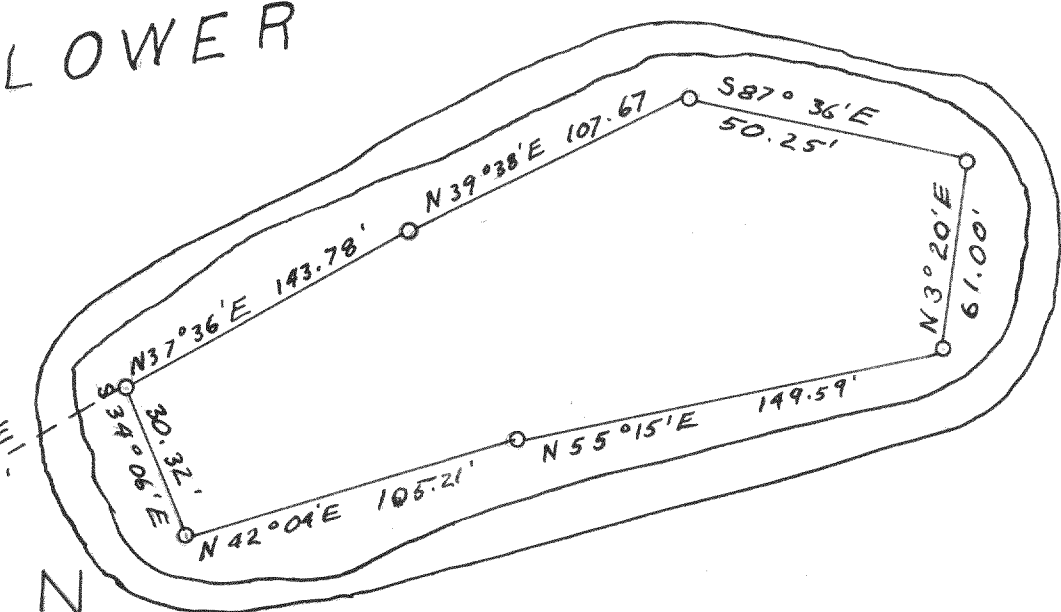

PLAT OF SURVEY OF
 ISLAND LOCATED IN LOWER
 WHITEWATER LAKE IN THE SE
 1/4 OF THE SE 1/4 OF SECTION 27
 T4N, R15E WALWORTH COUNTY
 WISCONSIN
 LLOYD L. JENSEN
 COUNTY SURVEYOR

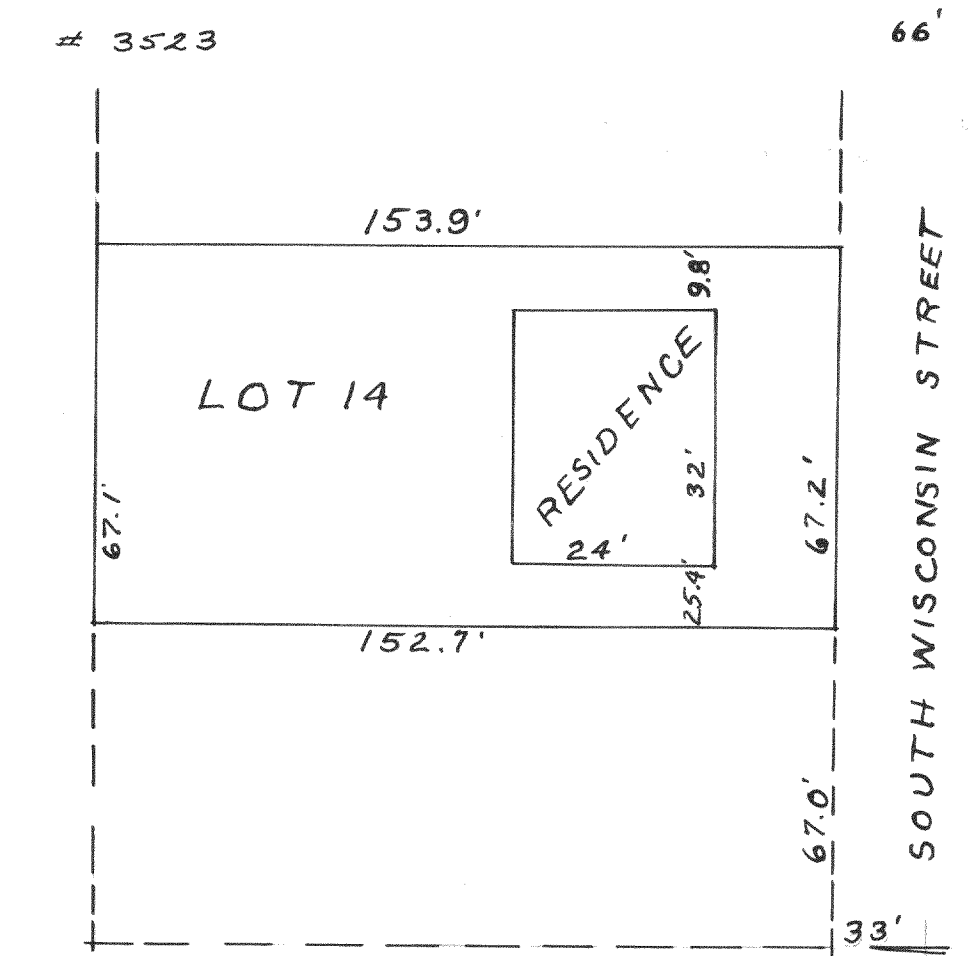

PLAT OF SURVEY OF LOT 14 OF BLOCK
 4 OF PRESTON'S ADD. TO THE CITY
 OF ELKHORN, WALWORTH COUNTY
 WISCONSIN
 LLOYD L. JENSEN
 COUNTY SURVEYOR

EAST 1/4 SEC. COR-
 NER OF SEC. 1,
 T2N, R16E