




**#3595**  
 Plat of Survey of Lot 21  
 Add. "E" Country Club  
 Estates, Village of Fontana  
 on Geneva Lake, Walworth  
 County Wisconsin  
 Dec 30 58 Lloyd L. Jensen  
 County Surveyor

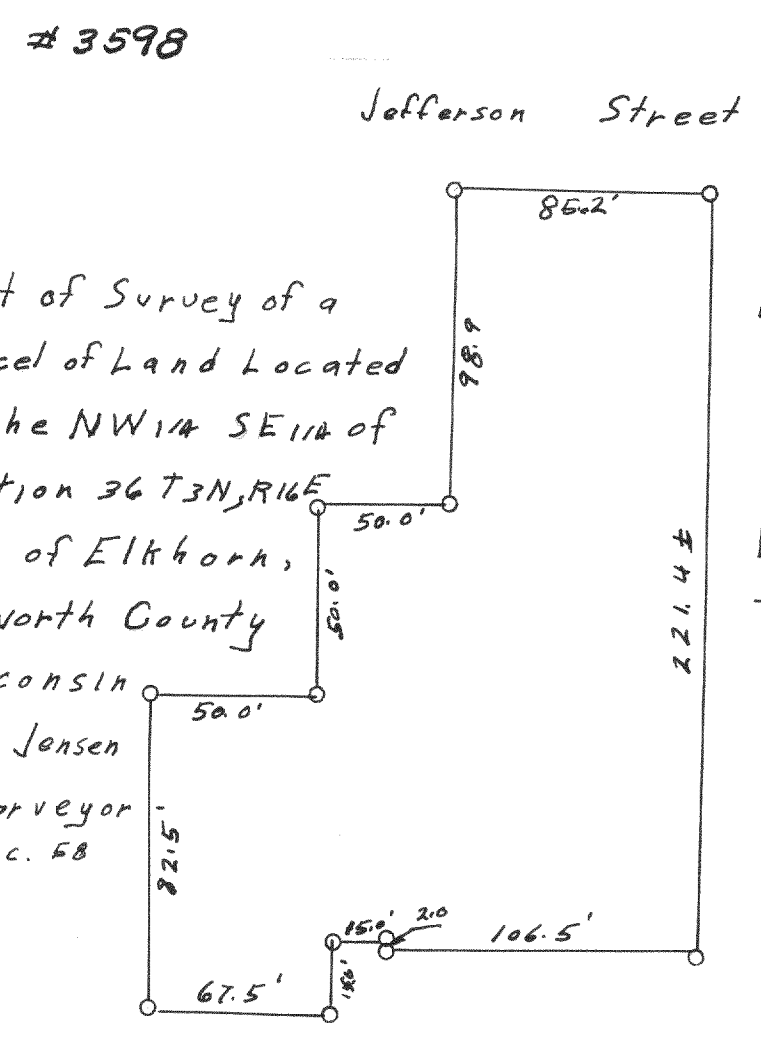


**#3598**  
 Plat of Survey of a  
 Parcel of Land Located  
 in the NW 1/4 SE 1/4 of  
 Section 36 T3N, R16E  
 City of Elkhorn,  
 Walworth County  
 Wisconsin  
 Lloyd L. Jensen  
 County Surveyor

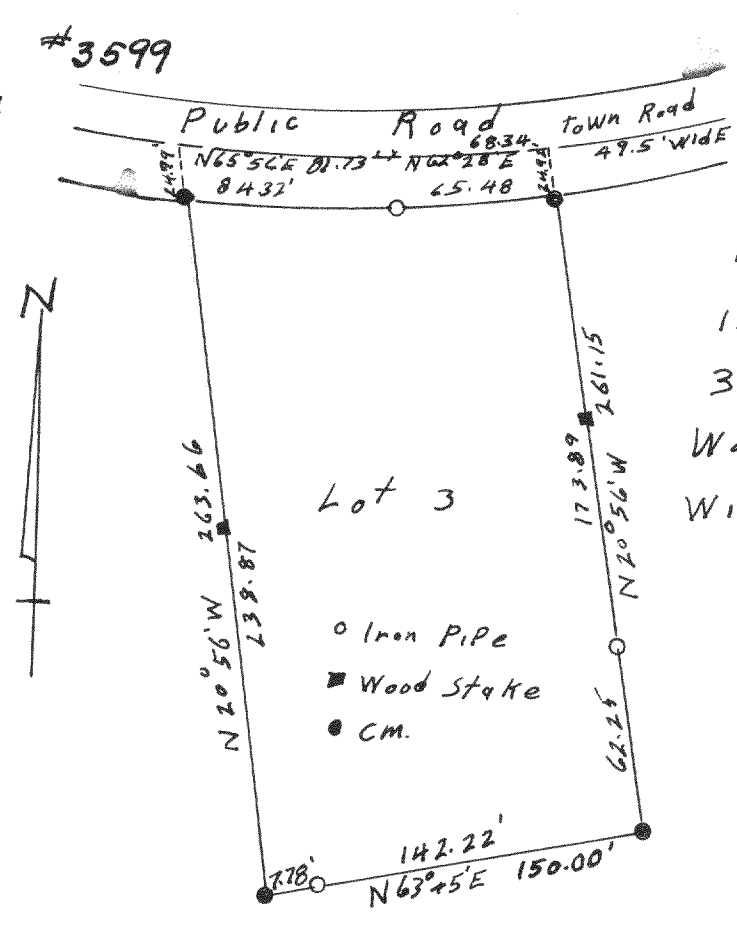


**#3599**  
 Plat of Survey of A  
 Parcel of Land Located  
 in the West 1/2 of Sec.  
 30, T2N, R18E,  
 Walworth County  
 Wisconsin Nov. 58  
 Lloyd L. Jensen  
 County Surveyor

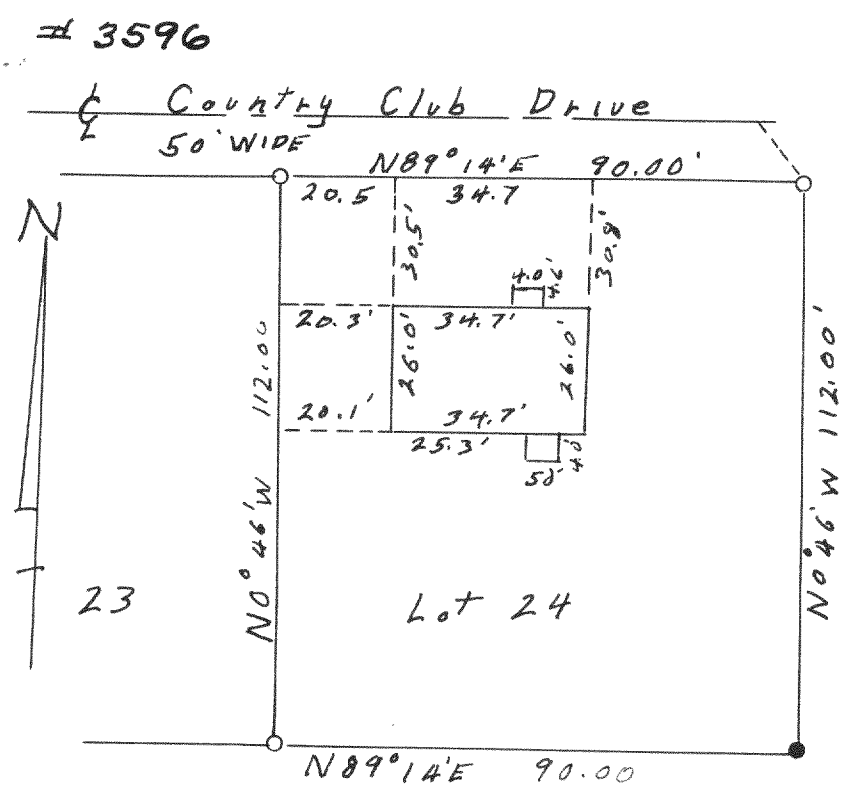


**#3596**  
 Plat of Survey of Lot  
 24 Add. "E" to Country Club  
 Estates Located in the Village  
 of Fontana - on Geneva Lake  
 Walworth County Wisconsin  
 Dec. 14 58 Lloyd L. Jensen  
 County Surveyor

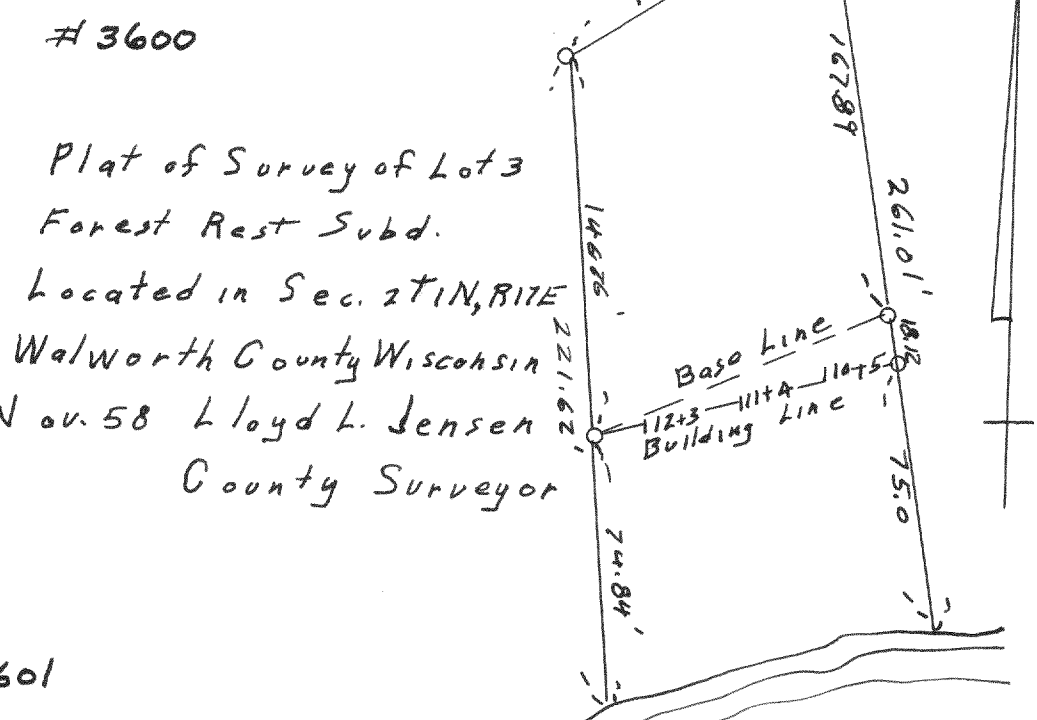

**#3600**  
 Plat of Survey of Lot 3  
 Forest Rest Subd.  
 Located in Sec. 27 T1N, R17E  
 Walworth County Wisconsin  
 Nov. 58 Lloyd L. Jensen  
 County Surveyor

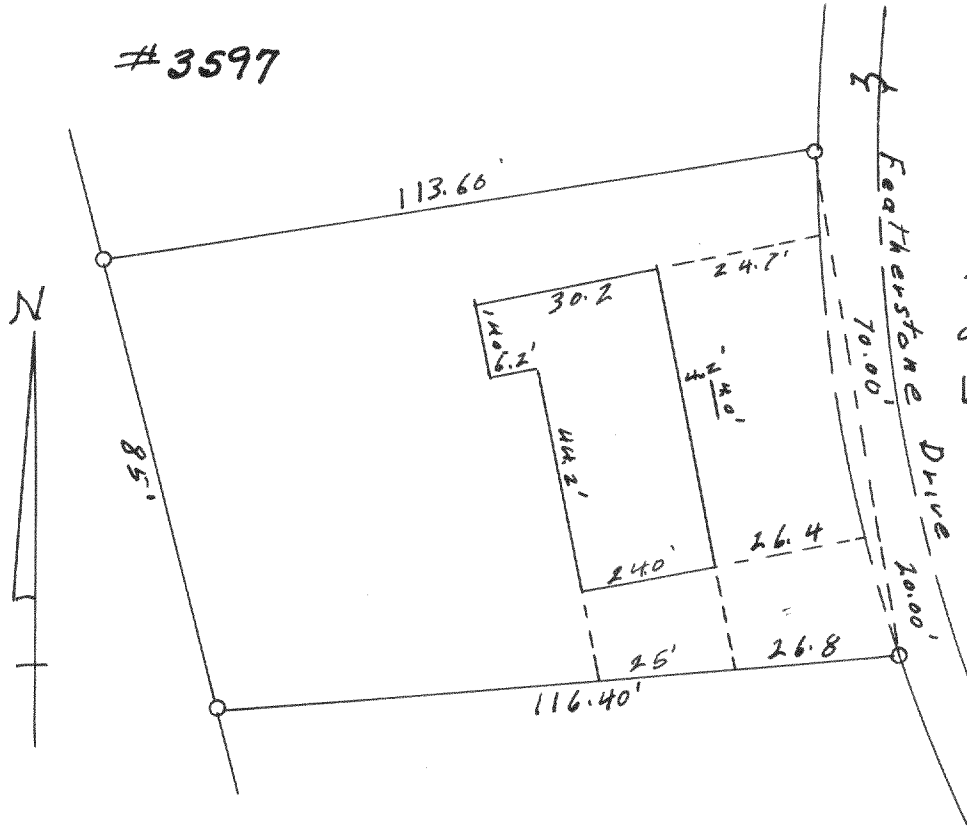

**#3597**  
 Plat of Survey of Lot 3 Block "E"  
 Unit 3 of Country Club Estates  
 Located in the Village of Fontana  
 on Geneva Lake, Walworth County  
 Wisconsin  
 Dec. 58 Lloyd L. Jensen #3601  
 County Surveyor

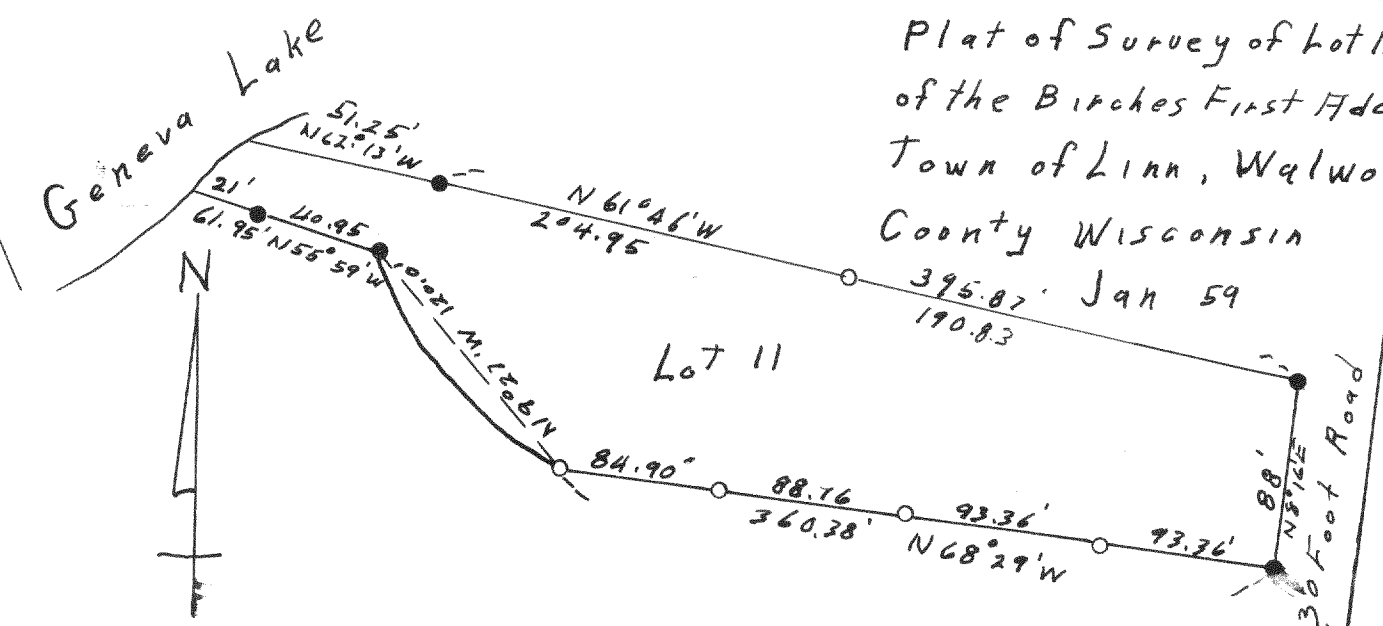

**#3601**  
 Plat of Survey of Lot 11  
 of the Birches First Add.  
 Town of Linn, Walworth  
 County Wisconsin  
 395.87' Jan 59  
 190.83'  
 Lloyd L. Jensen  
 County Surveyor