



3739

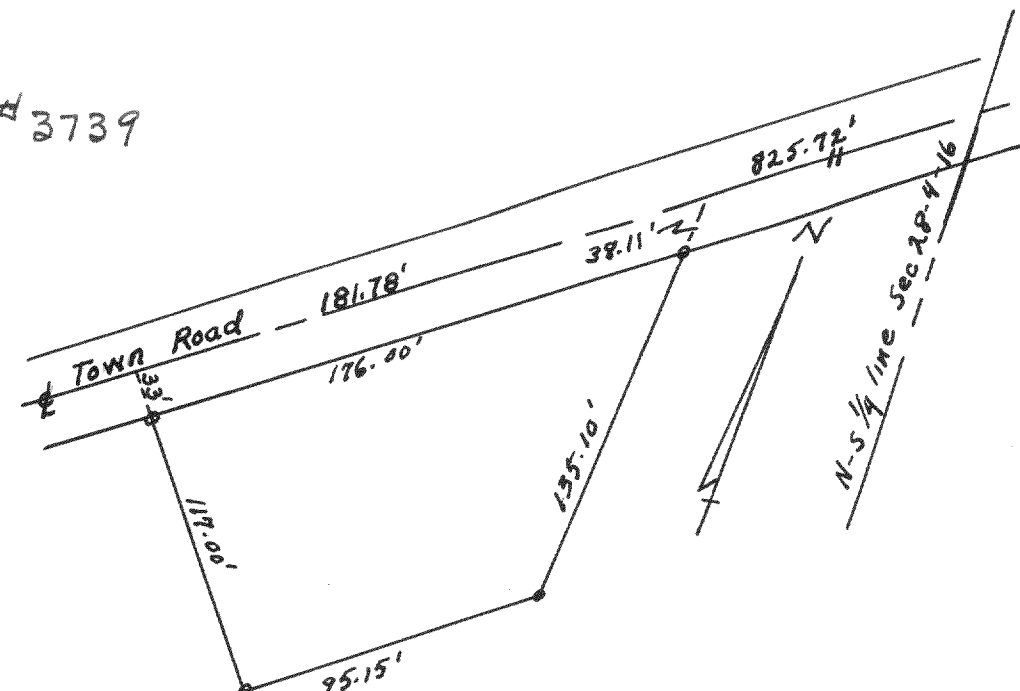

Survey in the SE 1/4 SW 1/4 Sec 28, T 4 N, R 16 E, Wal. Co. Wisc.

Lloyd L. Jensen
County Surveyor


3740

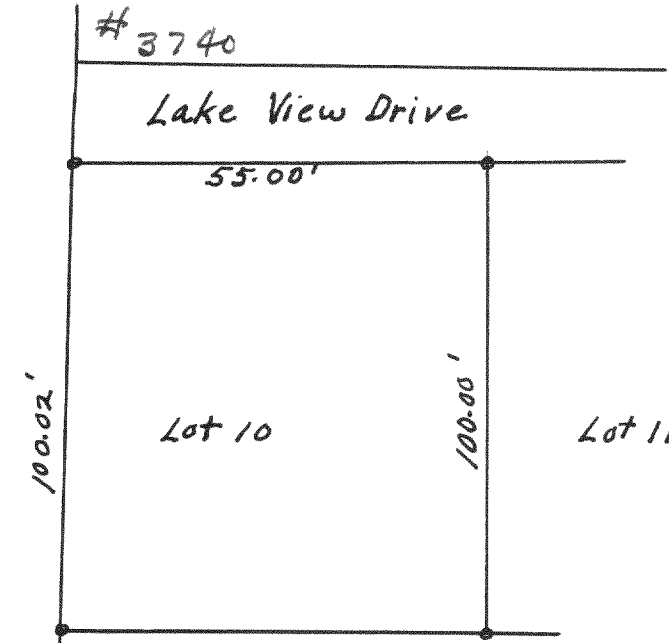

Survey of Lot 10, Edgewater Terrace, T 1 N, R 17 E, Wal. Co. Wisc.

Lloyd L. Jensen
County Surveyor


3741

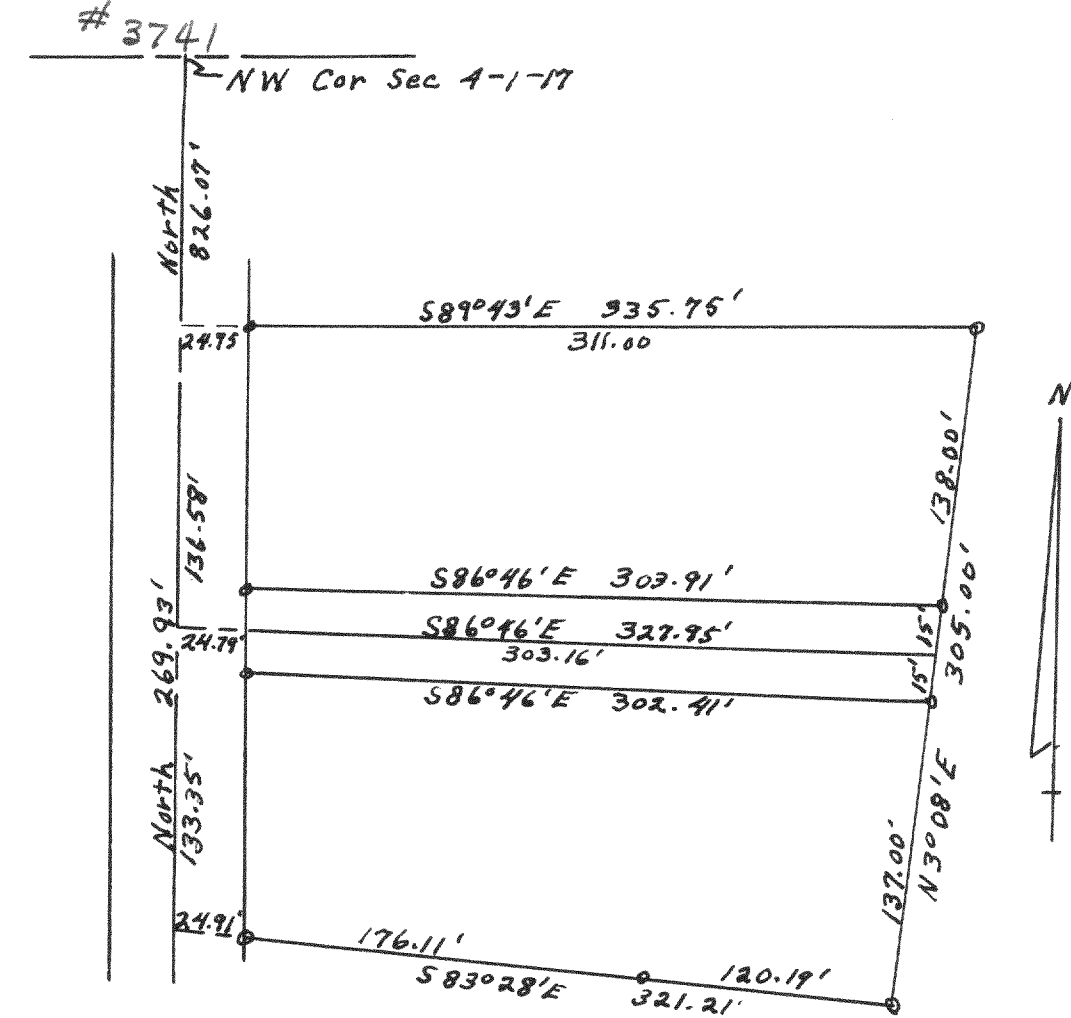

Survey in NW 1/4 NW 1/4 Fractional Sec 4, T 1 N, R 17 E Wal. Co. Wisc.

Lloyd L. Jensen
County Surveyor


3742

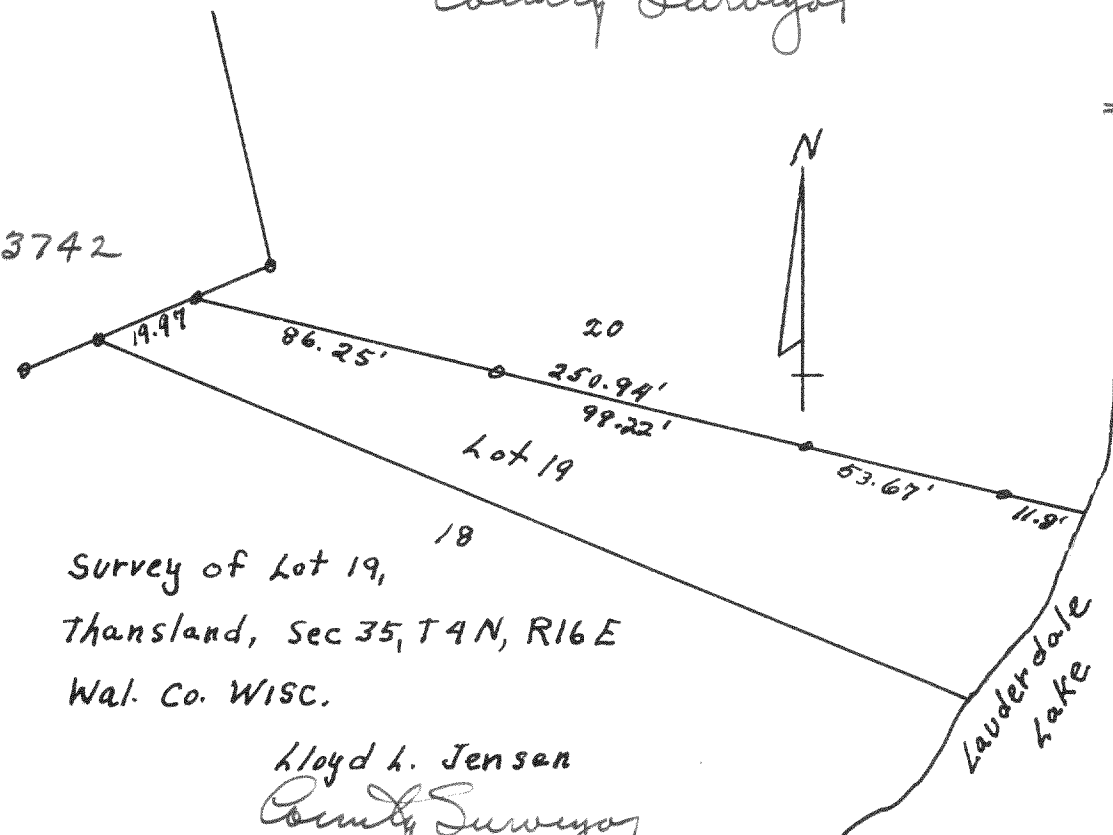

Survey of Lot 19, Thansland, Sec 35, T 4 N, R 16 E Wal. Co. Wisc.

Lloyd L. Jensen
County Surveyor


3744

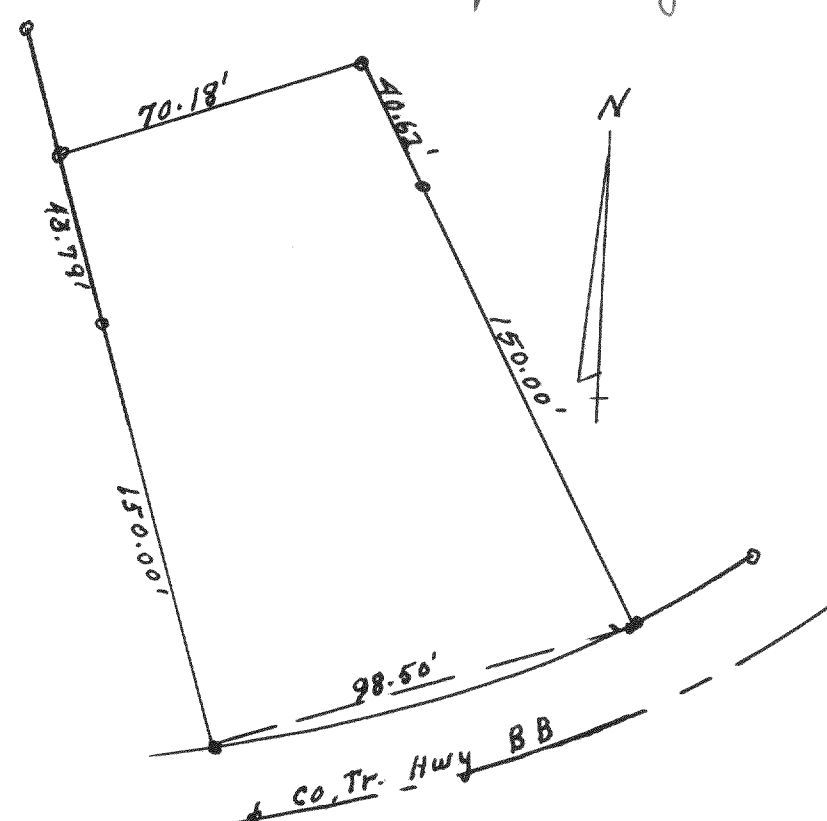

Survey in SE 1/4 Sec 11, T 1 N, R 17 E, Wal. Co. Wisc.

Lloyd L. Jensen
County Surveyor


3745

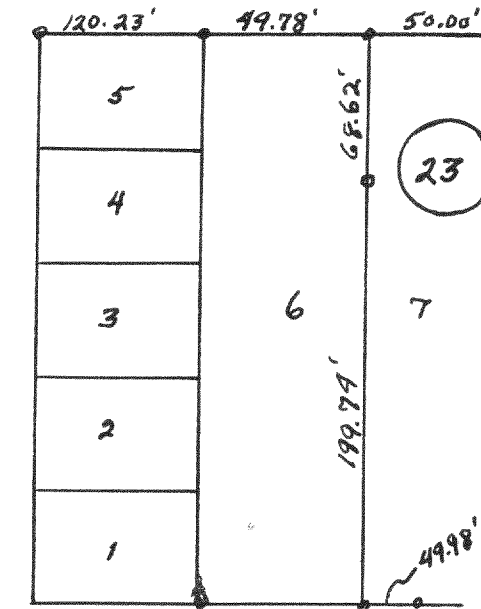

Survey of Lot 6, Bk 23 Sunset Hills Subd, T 1 N, R 17 E, Wal. Co. Wisc.

Lloyd L. Jensen
County Surveyor


3746

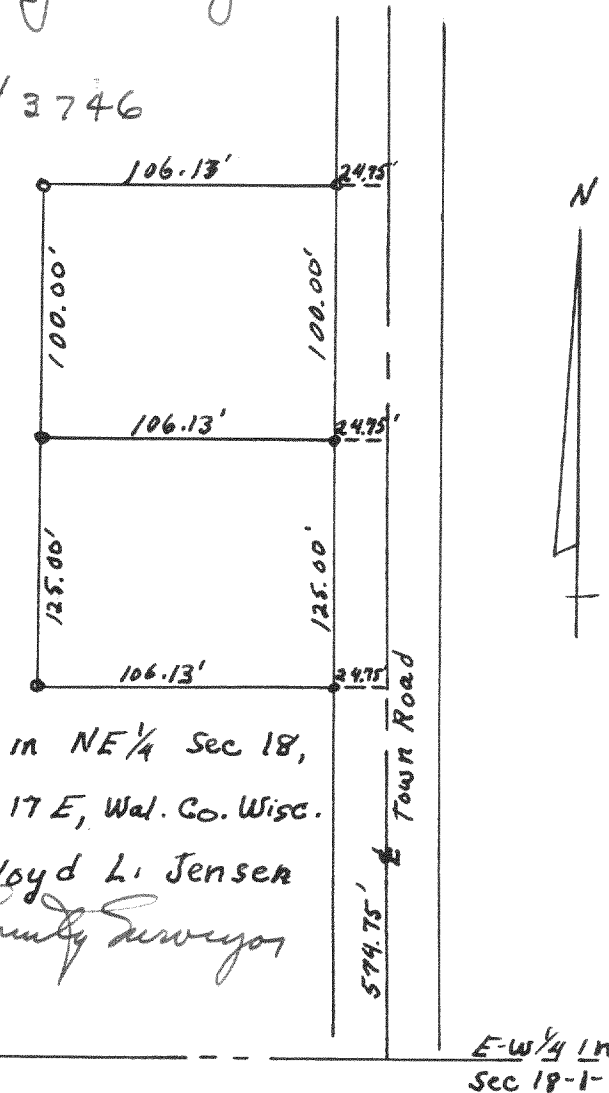

Survey in NE 1/4 Sec 18, T 1 N, R 17 E, Wal. Co. Wisc.

Lloyd L. Jensen
County Surveyor

3743

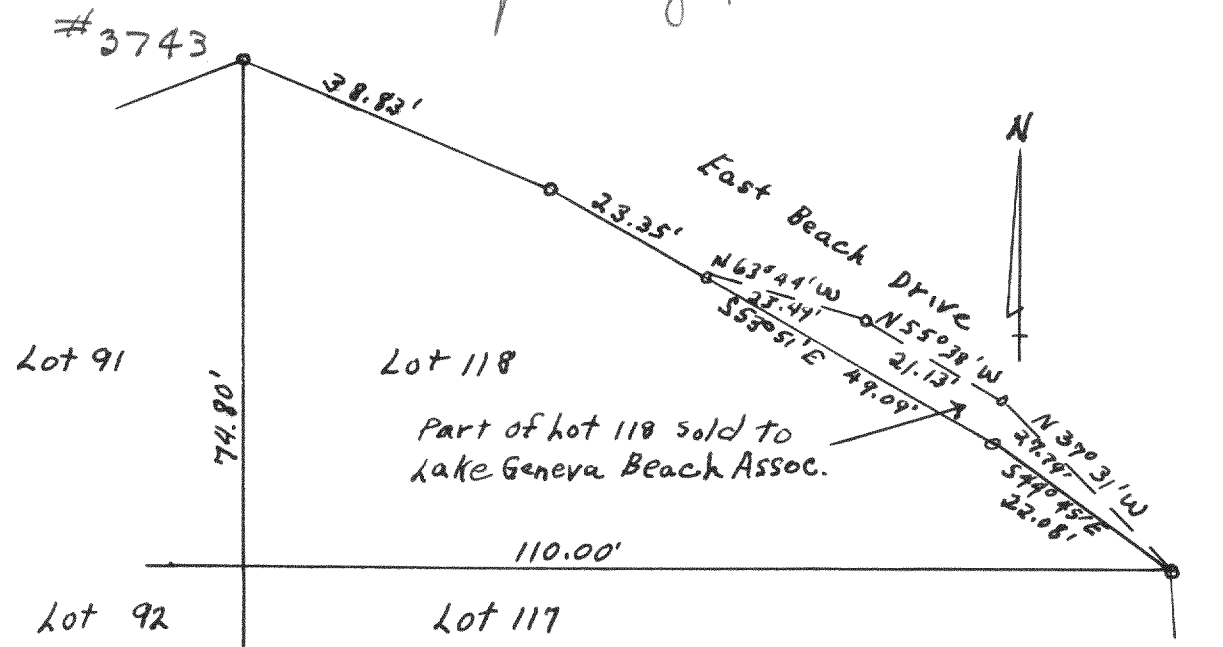

Survey of Lot 118, Lake Geneva Beach Subd, SW 1/4 Sec, 11, T 1 N, R 17 E Wal. Co. Wisc.

Lloyd L. Jensen
County Surveyor