



2705

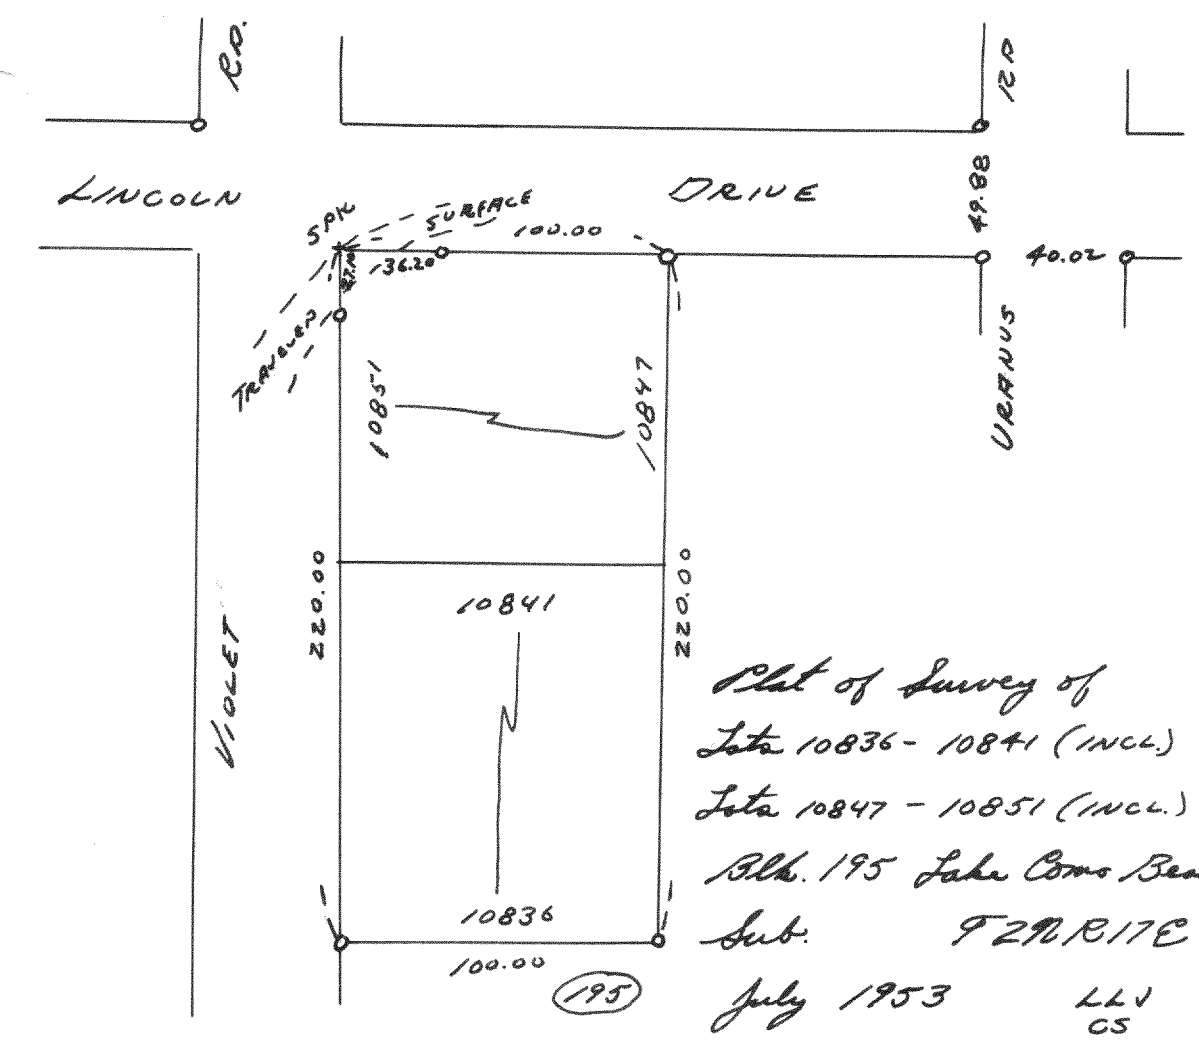


Plat of Survey of
 Lots 10836 - 10841 (INCL.)
 Lots 10847 - 10851 (INCL.)
 Blk. 195 Lake Como Beach
 Sub. F290B17E
 July 1953 LLJ
 CS

2706

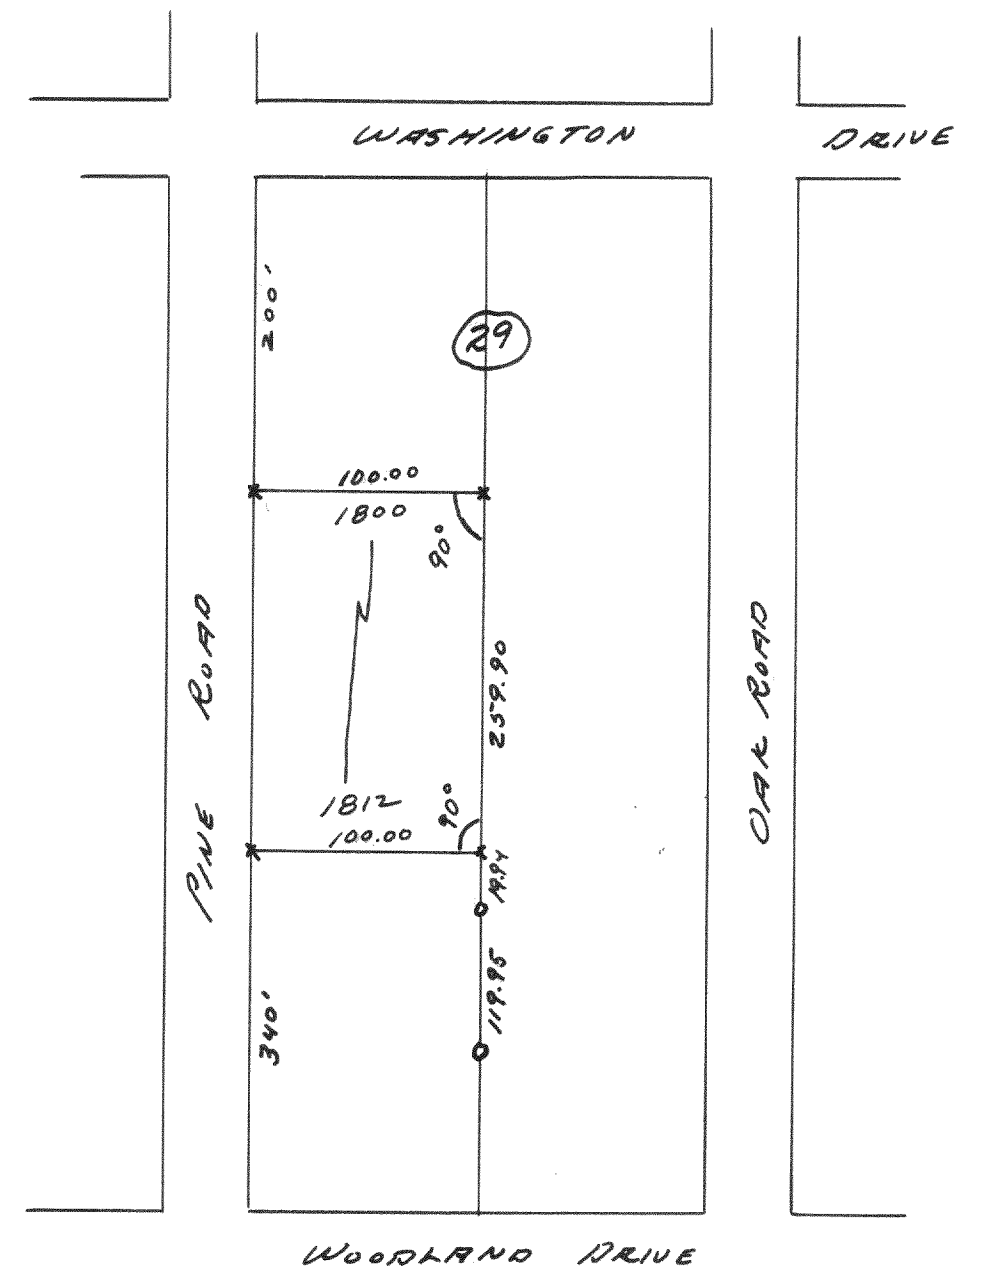


Plat of Survey of Lots 1800-1812 (INCL.)
 Block 29 Lake Como Beach Sub.
 Oct. 1953 LLJ
 CS

2707

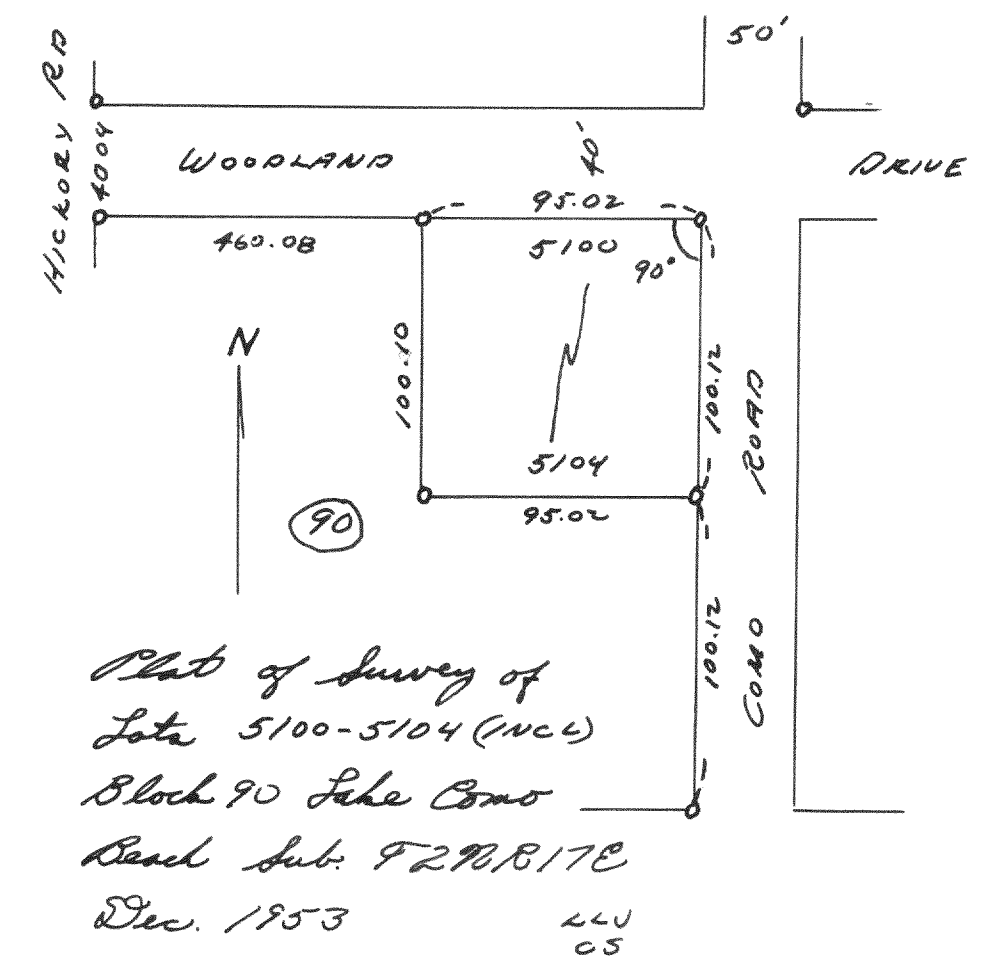


Plat of Survey of
 Lots 5100-5104 (INCL.)
 Block 90 Lake Como
 Beach Sub. F290B17E
 Dec. 1953 LLJ
 CS

2708

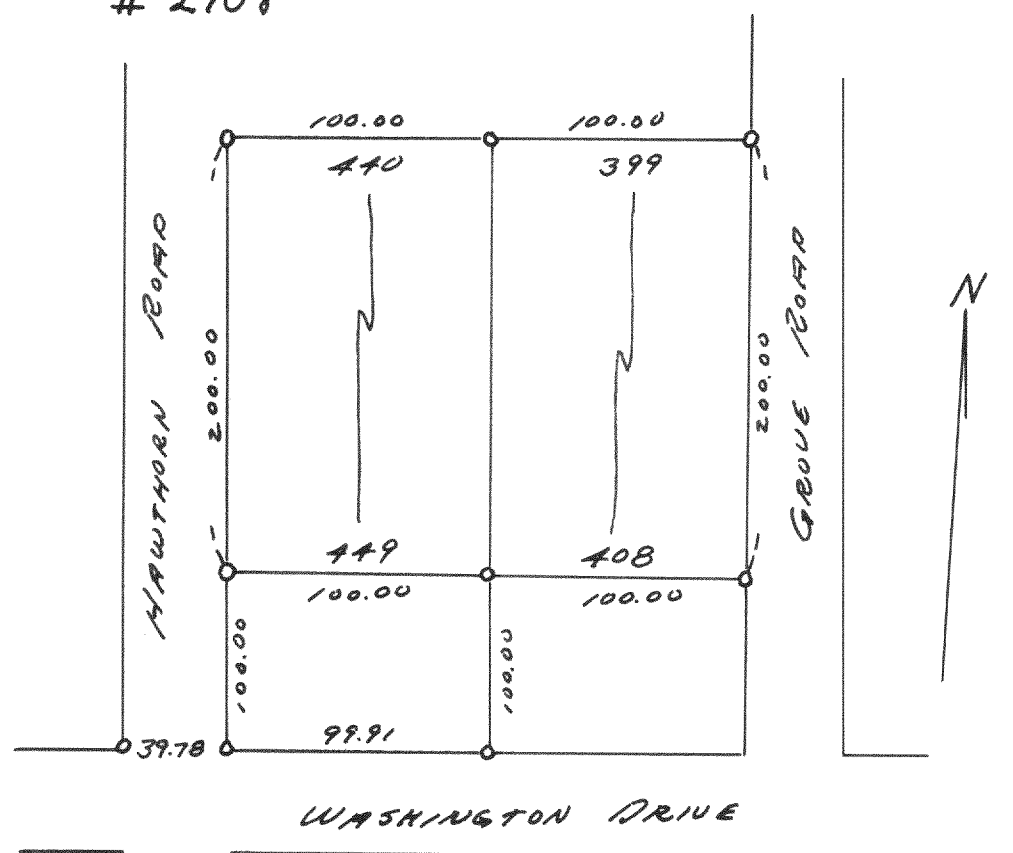

Plat of Survey of Lots 440-449 (INCL.)
 Lots 399-408 (INCL.) Block 8 Lake Como
 Beach Sub. F290B17E
 Aug. 1953 LLJ
 CS

2709

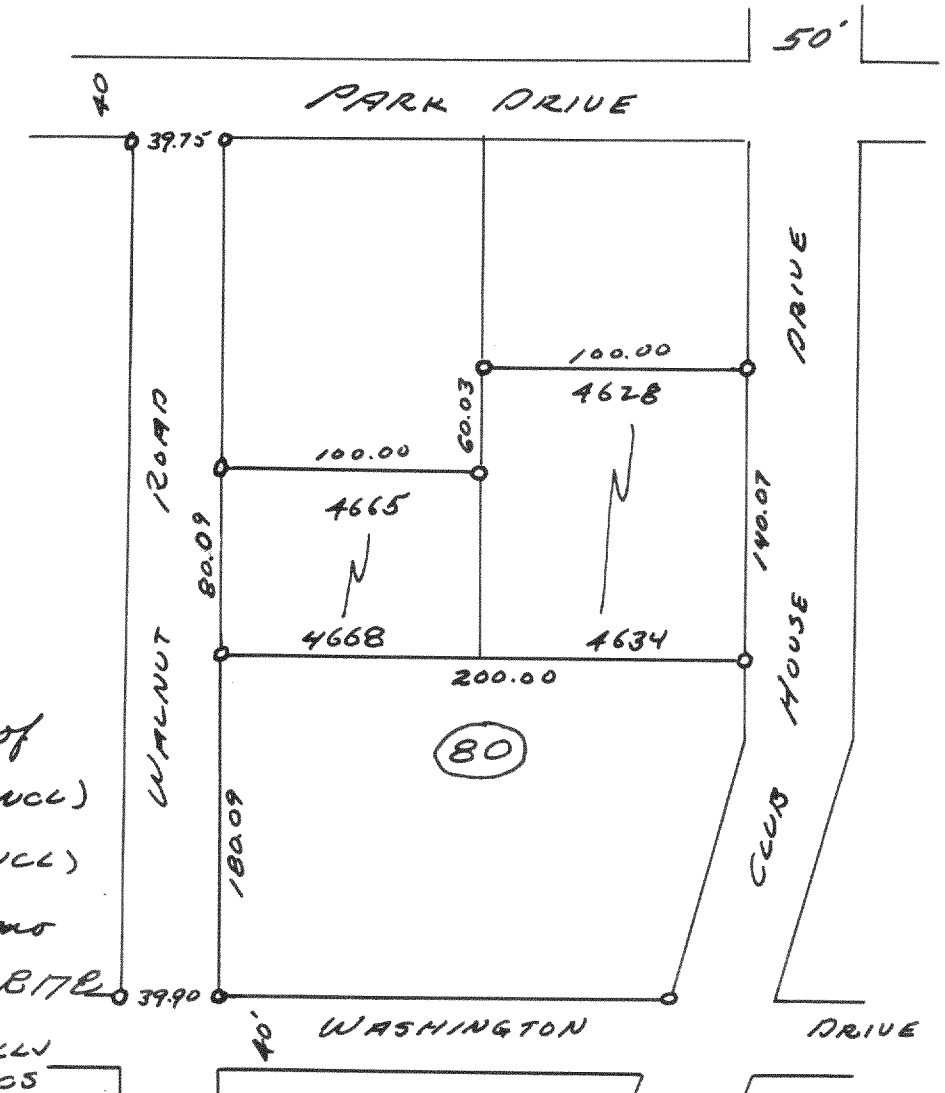

Plat of Survey of
 Lots 4628-4634 (INCL.)
 Lots 4665-4668 (INCL.)
 Blk. 80 Lake Como
 Beach Sub. F290B17E
 Dec. 1953 LLJ
 CS