



# 2710

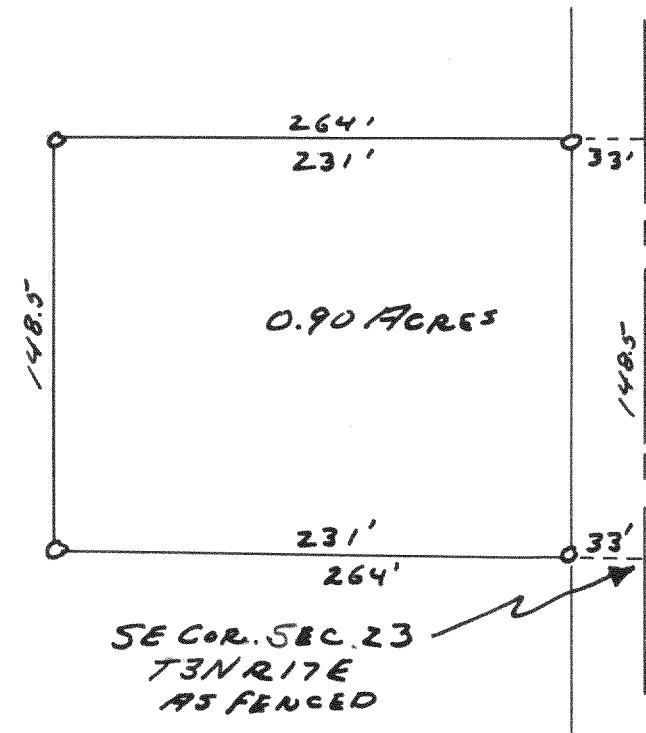

Plat of Survey of Land in  
SE 1/4 Sec. 23 T3N R17E  
March 1953 LLJ CS


# 2711

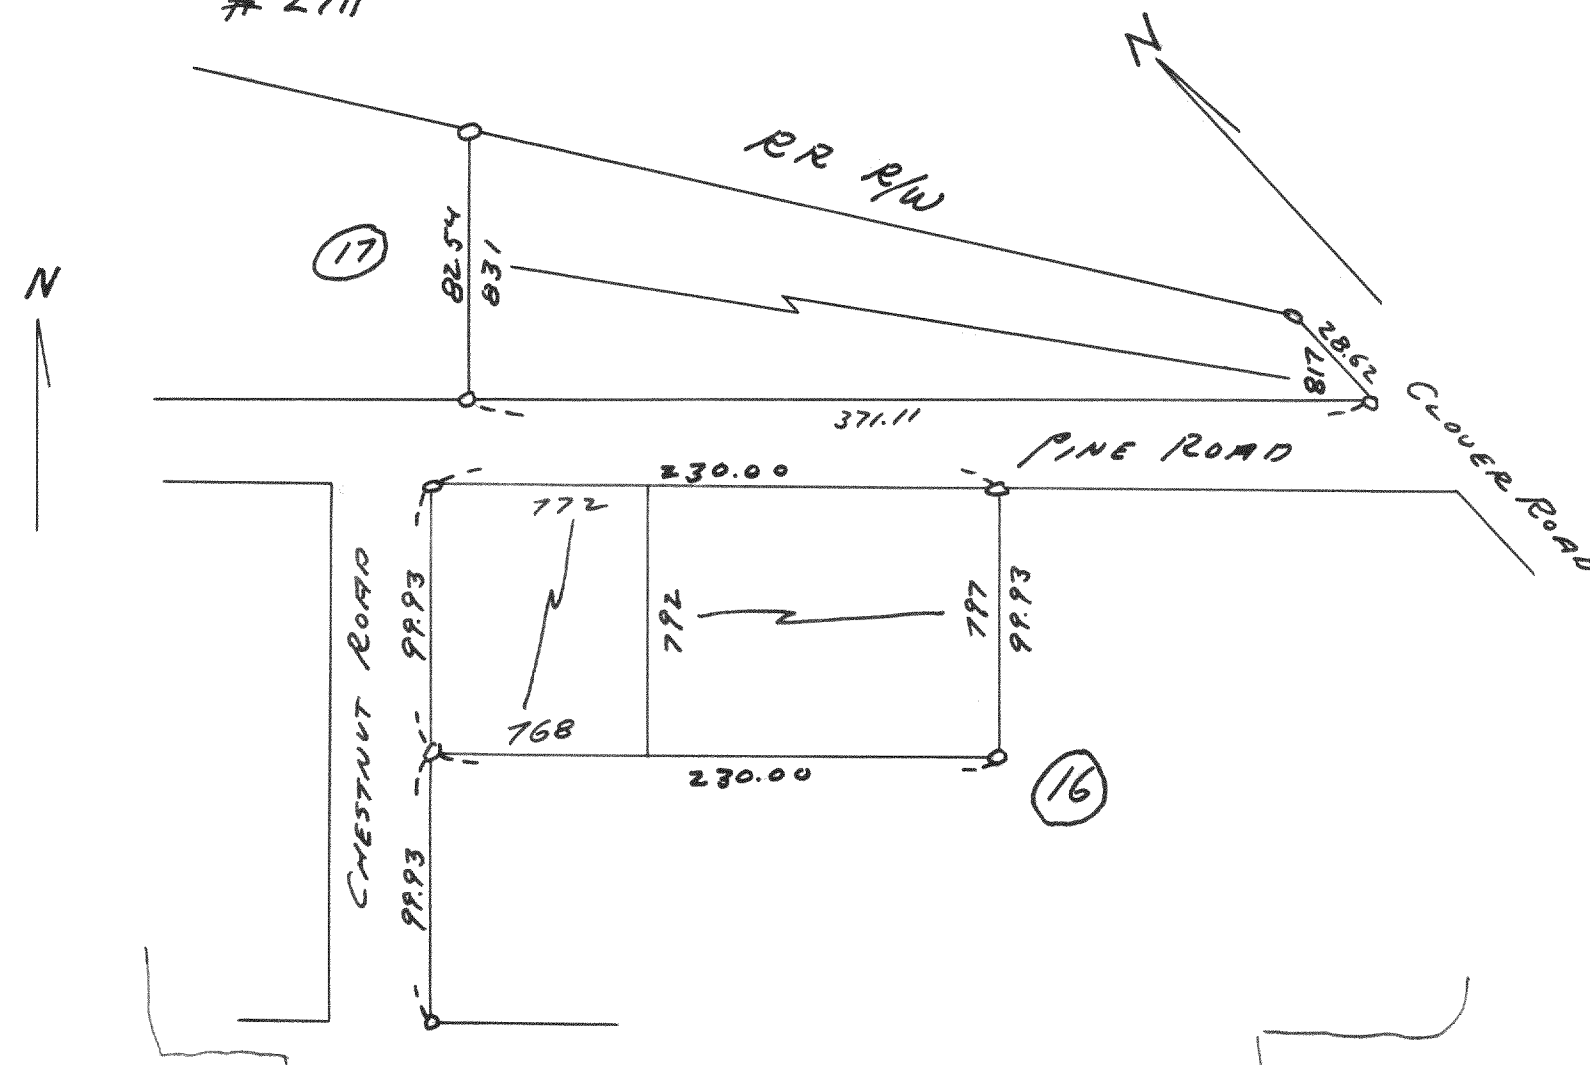

# 2714


Plat of Survey of Lots 768-772 (INCL)  
& Lots 792-797 (INCL) Block 16 & Lots  
817-831 (INCL) Block 17  
Pell Lake T1N R18E  
July 1953 LLJ CS

# 2712

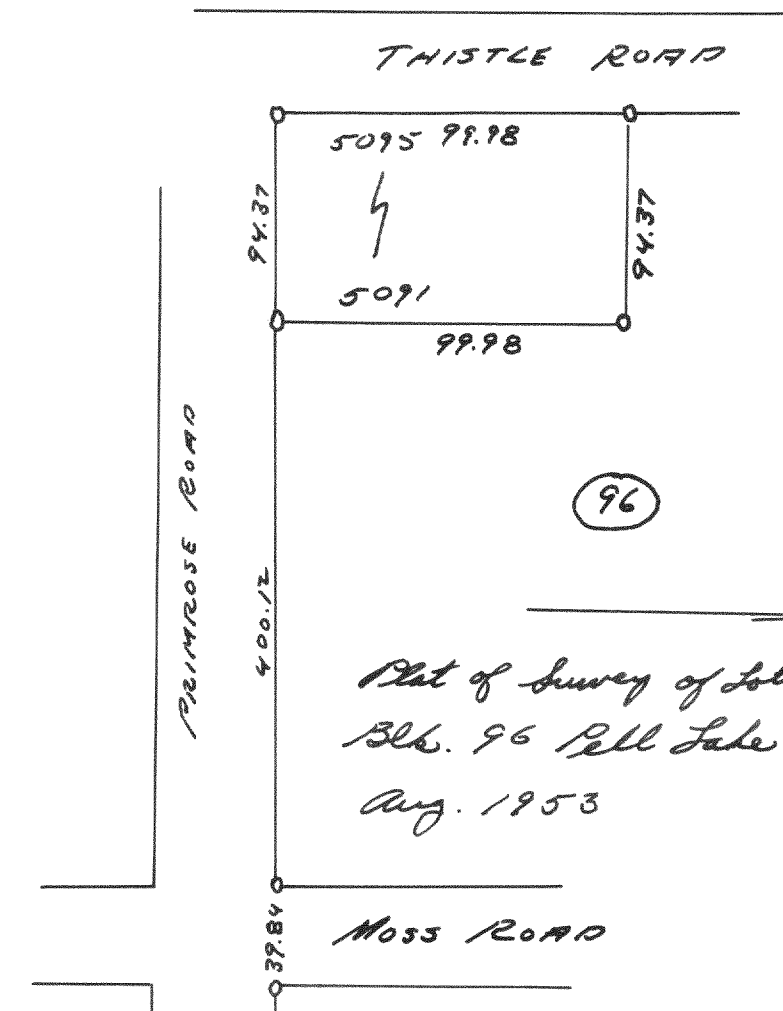


Plat of Survey of Lots 5091-5095 (INCL)  
Blk. 96 Pell Lake T1N R18E  
Aug. 1953 LLJ CS

# 2713

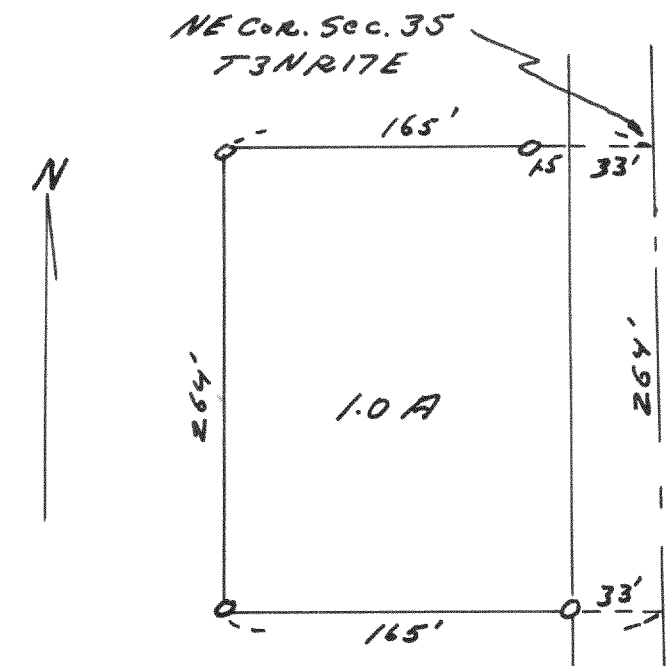


Plat of Survey of Land  
in NE 1/4 Sec. 35 T3N R17E  
April 1953 LLJ CS

# 2715

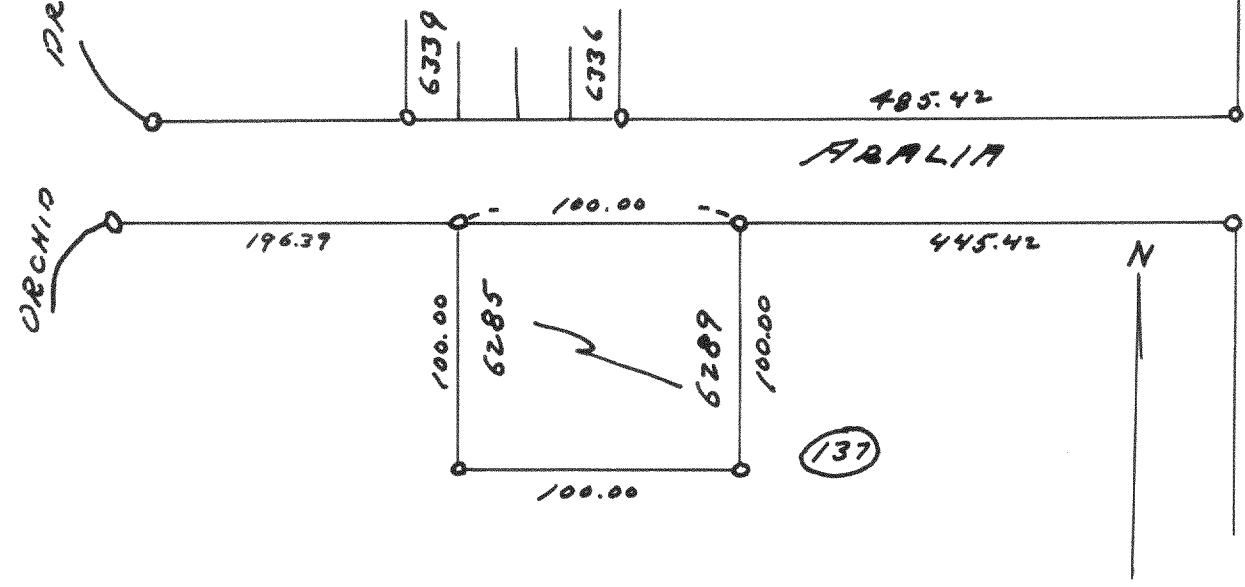

Plat of Survey of Lots 6285-6289 (INCL)  
Pell Lake T1N R18E  
April 1953 LLJ CS

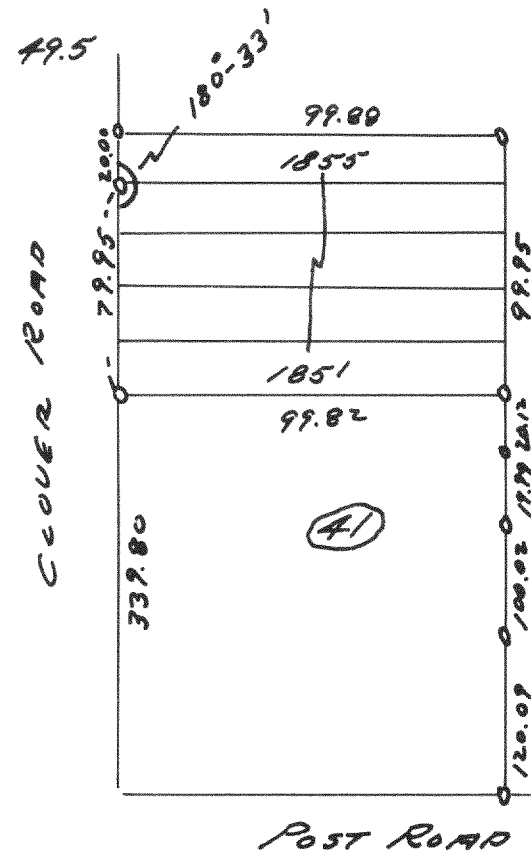

Plat of Survey of Lots 1851-1855 (INCL)  
Block 41 Pell Lake  
Aug. 1953 LLJ CS