



#3828

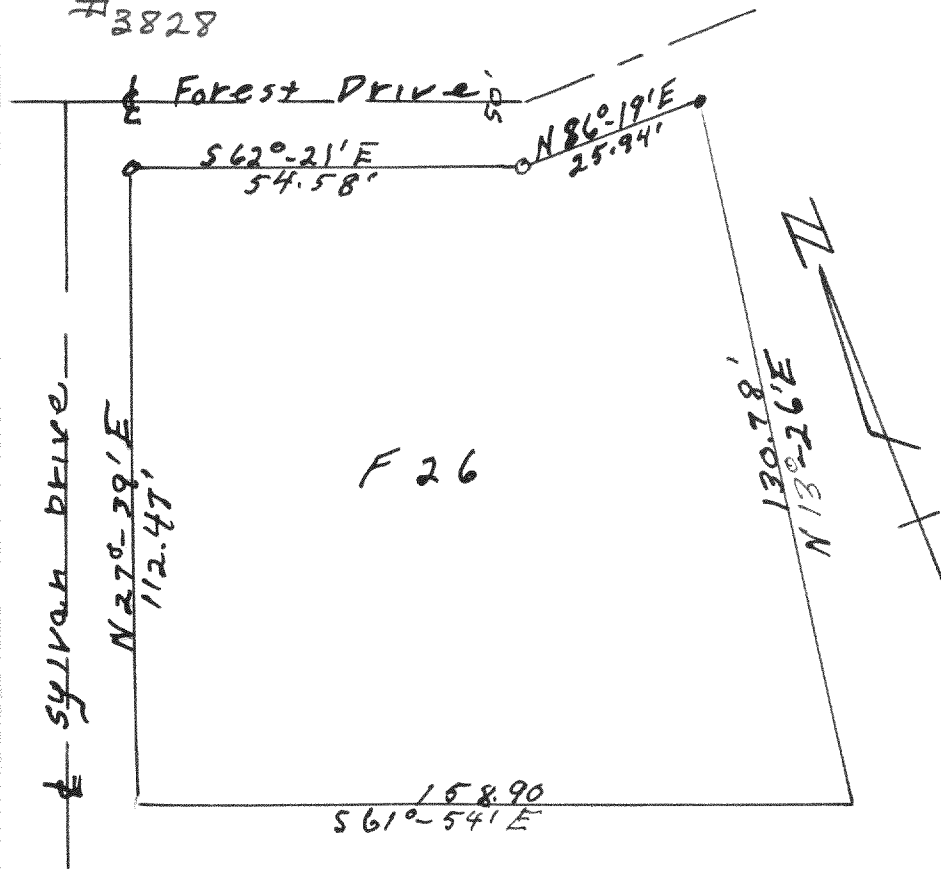


Plat of Survey of Lot F26,
Add. F to Country Club Estates,
Village of Fontana, Walworth
County Wisconsin Nov. 1959
Lloyd L. Jensen County Surveyor

#3829

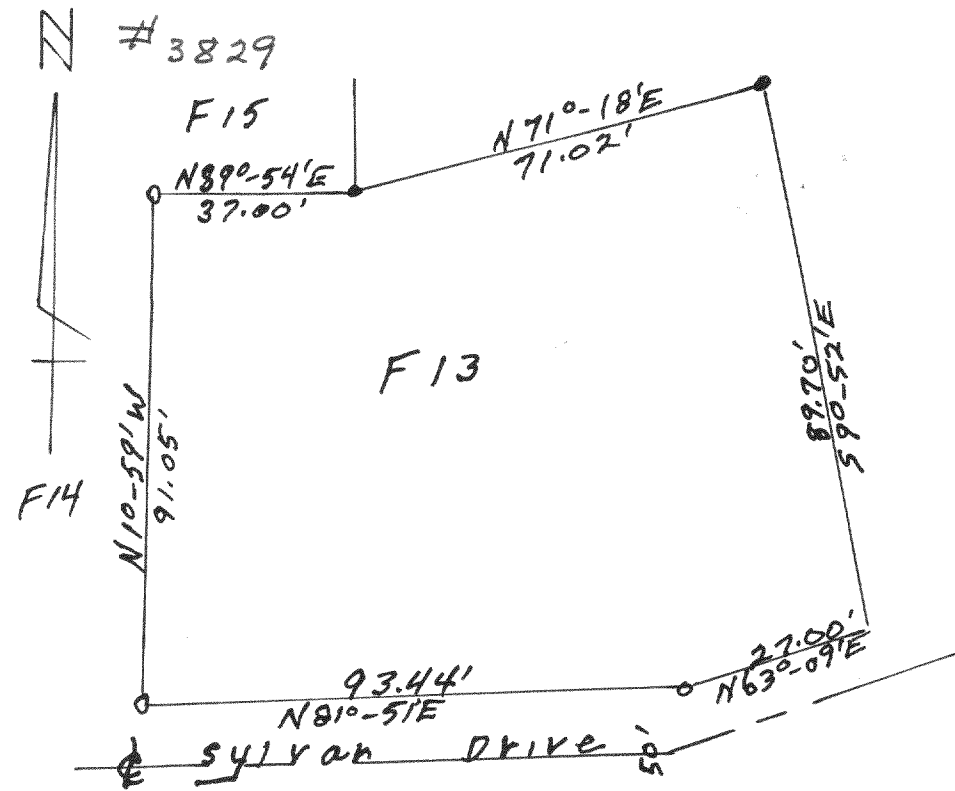


Plat of Survey of Lot F13,
Add. F to Country Club Estates,
Village of Fontana, Walworth
County Wisconsin Aug. 1959
Lloyd L. Jensen
County Surveyor

#3830

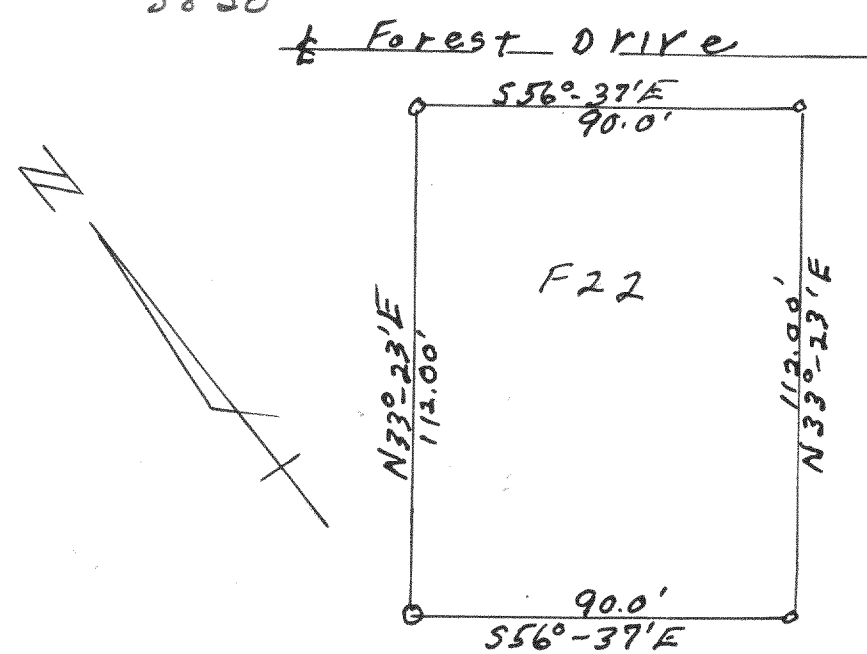


Plat of Survey of Lot F22
Add. F to Country Club Estates,
Village of Fontana, Walworth
County Wisconsin July 1959
Lloyd L. Jensen
County Surveyor

#3831

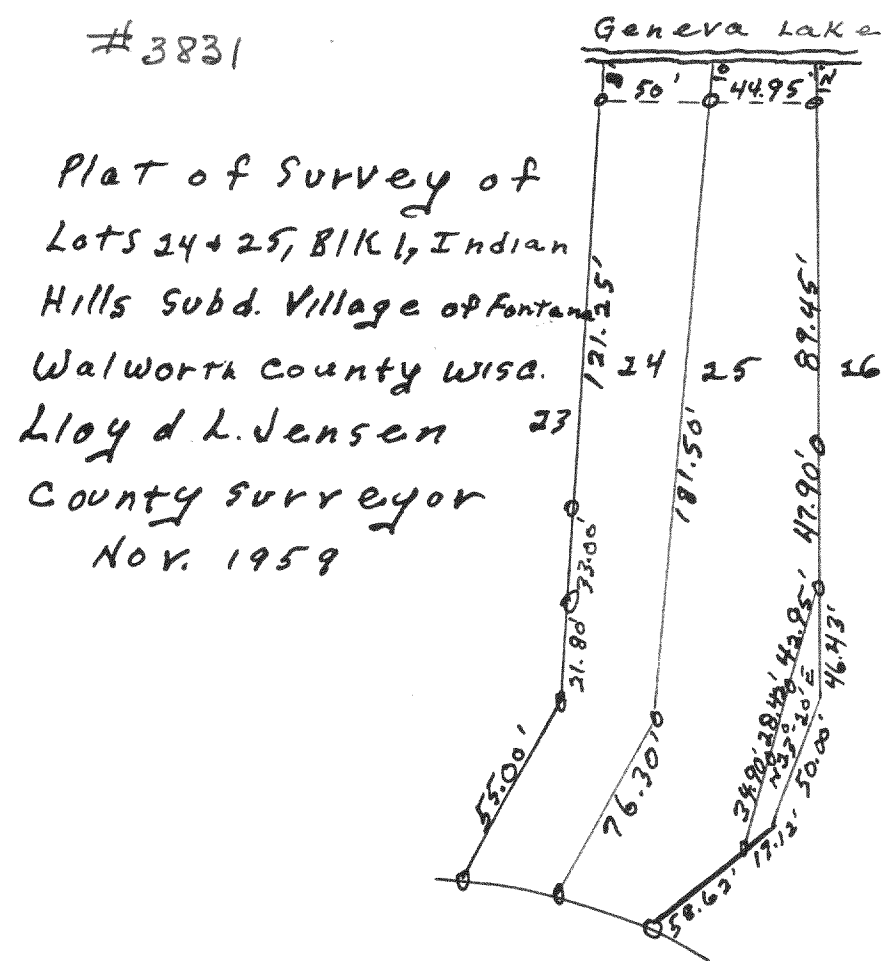


Plat of Survey of
Lots 24+25, BIK, Indian
Hills Subd. Village of Fontana
Walworth County Wisd.
Lloyd L. Jensen
County Surveyor
Nov. 1959

#3832

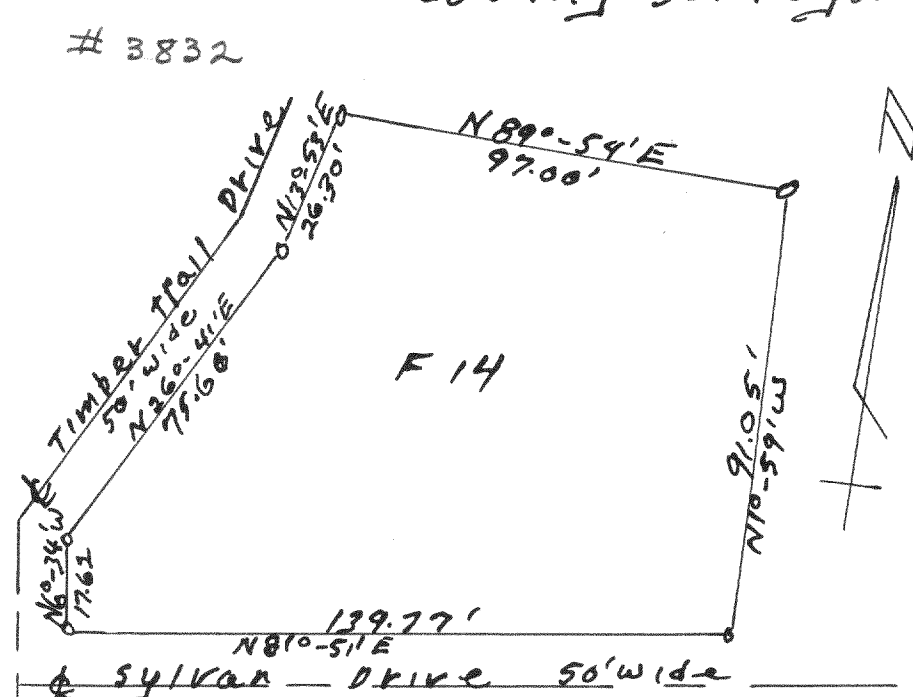

Plat of Survey of Lot F14
Add. F to Country Club Estates,
Village of Fontana, Walworth
County Wisconsin May 1959
Lloyd L. Jensen
County Surveyor

#3833

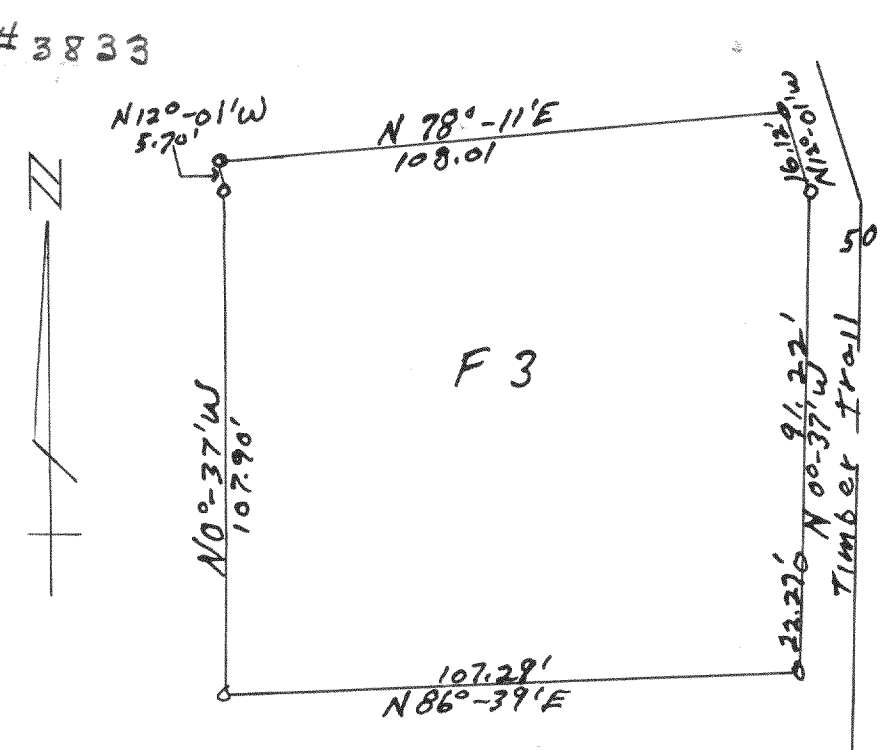

Plat of Survey of Lot F3
Add. F to Country Club Estates
Village of Fontana, Walworth
County Wisconsin July 1959
Lloyd L. Jensen
County Surveyor